



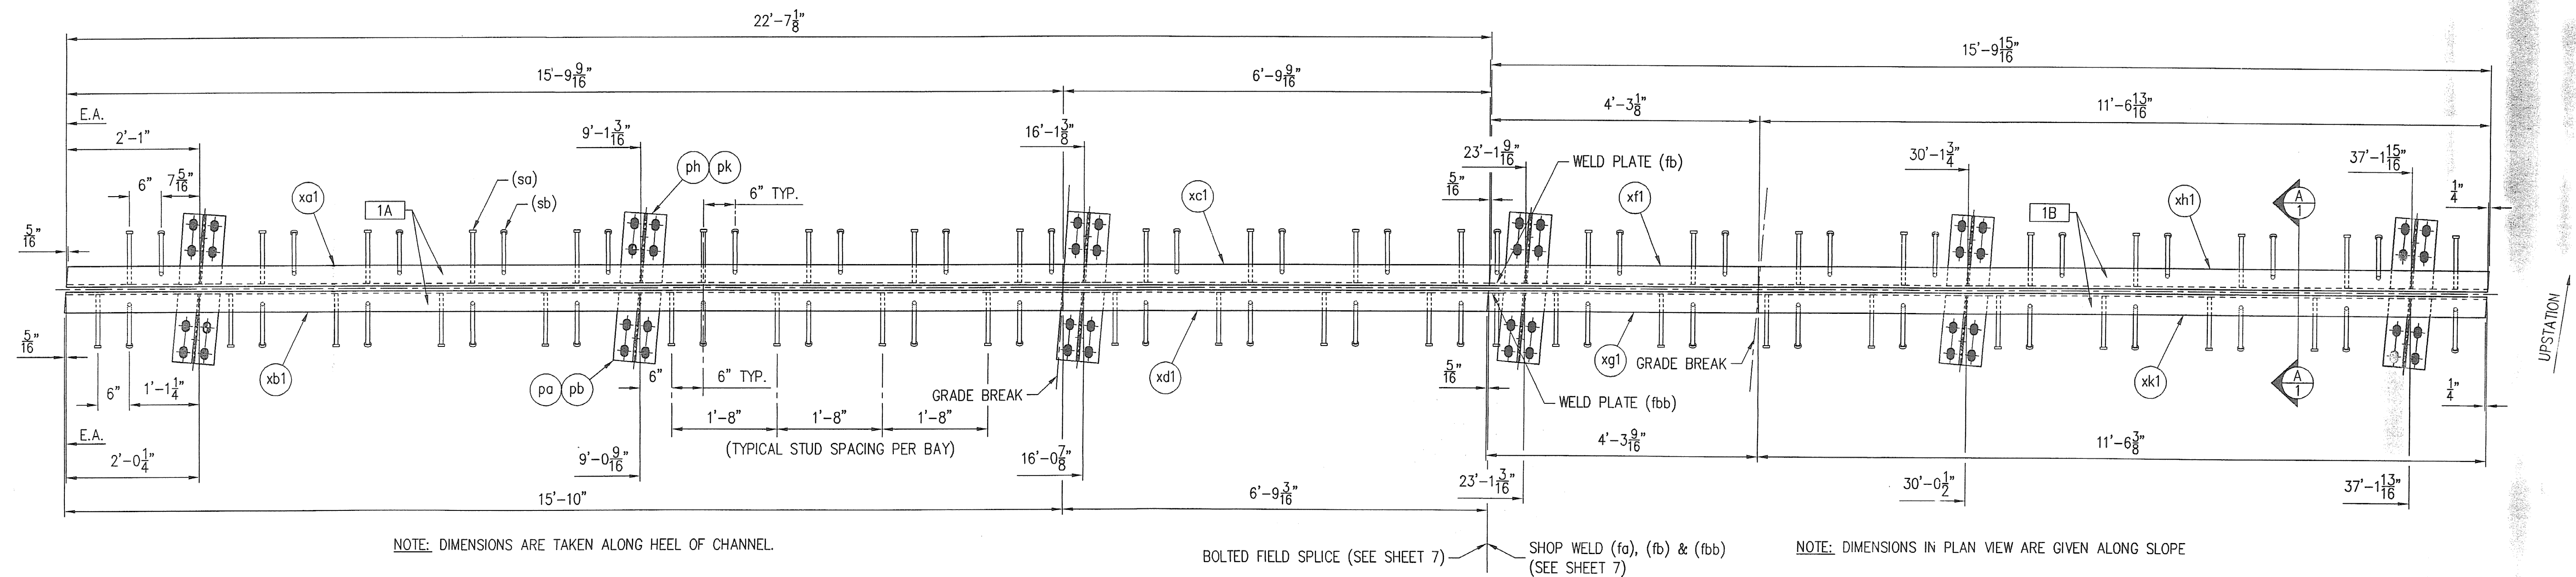

PLAN VIEW - EXPANSION JOINT
(PIER 1 - WESTBOUND)

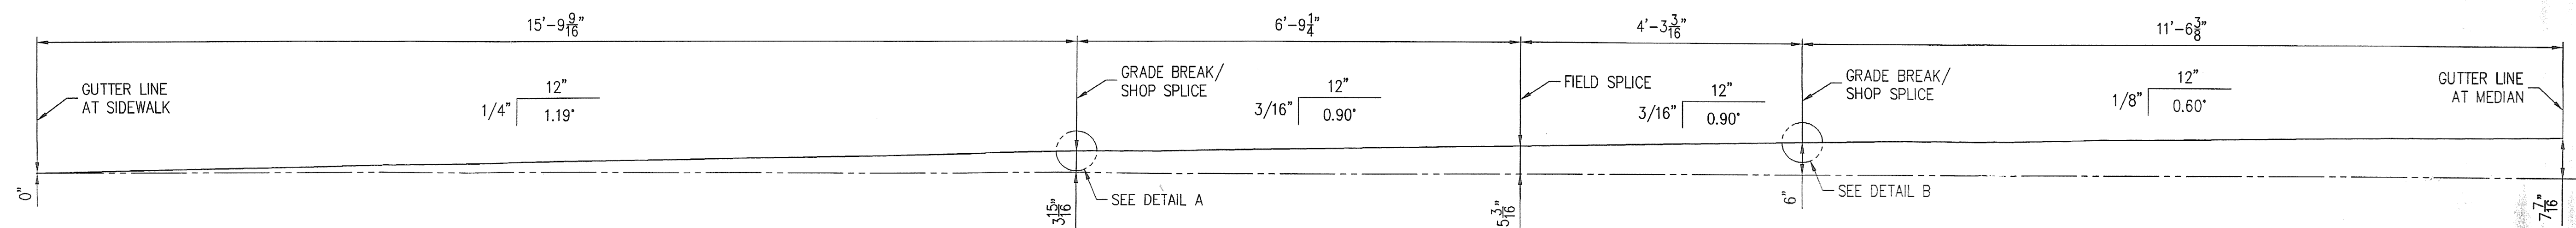

ELEVATION VIEW
(ELEVATIONS TAKEN ALONG C OF JOINT)

TEMPERATURE ADJUSTING CHART - PIER 1				
TEMPERATURE	45°	60°	75°	90°
DIM 'A'	1 1/4	1	7/8	3/4

SEE SHEET 7 FOR GENERAL NOTES

LINE NO.	DESCRIPTION	LENGTH	MK	REMARKS	WGHT.
1	EXPANSION JOINT ASS'Y		1A	HDG	
2	MC18x42.7	15'-9 9/16"	xa1	REMOVE FLANGE	11-8
3	MC18x42.7	15'-10"	xb1	REMOVE FLANGE	11-8
4	MC18x42.7	6'-9 9/16"	xc1	REMOVE FLANGE	11-8
5	MC18x42.7	6'-9 9/16"	xd1	REMOVE FLANGE	11-8
6	PL 1/2 x 6	1'-3"	pa	SHAPE CUT / COPE TO FIT MC18x42.7	19-16
7	PL 1/2 x 8	1'-3 5/16"	pb	SHAPE CUT	19-16
8	PL 1/2 x 6	1'-0"	ph	SHAPE CUT / COPE TO FIT MC18x42.7	19-16
9	PL 1/2 x 8	1'-0 1/4"	pk	SHAPE CUT	19-16
10	WS 3/4 x 10		sa	26	29-19
11	WS 3/4 x 10		sb	25 / BEND	29-19
12					
13					
14					
15	EXPANSION JOINT ASS'Y		1B	HDG	
16	MC18x42.7	4'-3 1/8"	xf1	REMOVE FLANGE	11-8
17	MC18x42.7	4'-3 3/8"	xg1	REMOVE FLANGE	11-8
18	MC18x42.7	11'-6 13/16"	xh1	REMOVE FLANGE	11-8
19	MC18x42.7	11'-6 3/8"	xi1	REMOVE FLANGE	11-8
20	PL 1/2 x 6	1'-3"	pa	SHAPE CUT / COPE TO FIT MC18x42.7	19-16
21	PL 1/2 x 8	1'-3 5/16"	pb	SHAPE CUT	19-16
22	PL 1/2 x 6	1'-0"	ph	SHAPE CUT / COPE TO FIT MC18x42.7	19-16
23	PL 1/2 x 8	1'-0 1/4"	pk	SHAPE CUT	19-16
24	WS 3/4 x 10		sa	18	29-19
25	WS 3/4 x 10		sb	18 / BEND	29-19
26	FB 1/4 x 2	0'-2"	fa		16-29
27	FB 1/4 x 4	1'-0"	fb		16-36
28	FB 1/4 x 4	1'-0"	fbb		16-36
29					
30					
31					
32					
33					

