


ROTATED ELEVATION FOR 1A




ROTATED ELEVATION FOR 1B




ROTATED ELEVATION FOR 2A

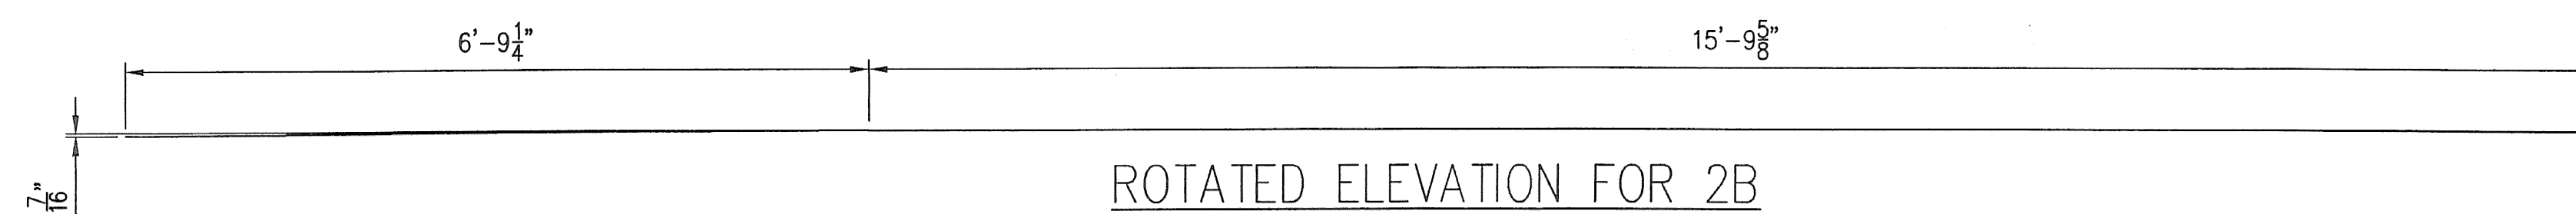


ROTATED ELEVATION FOR 2B

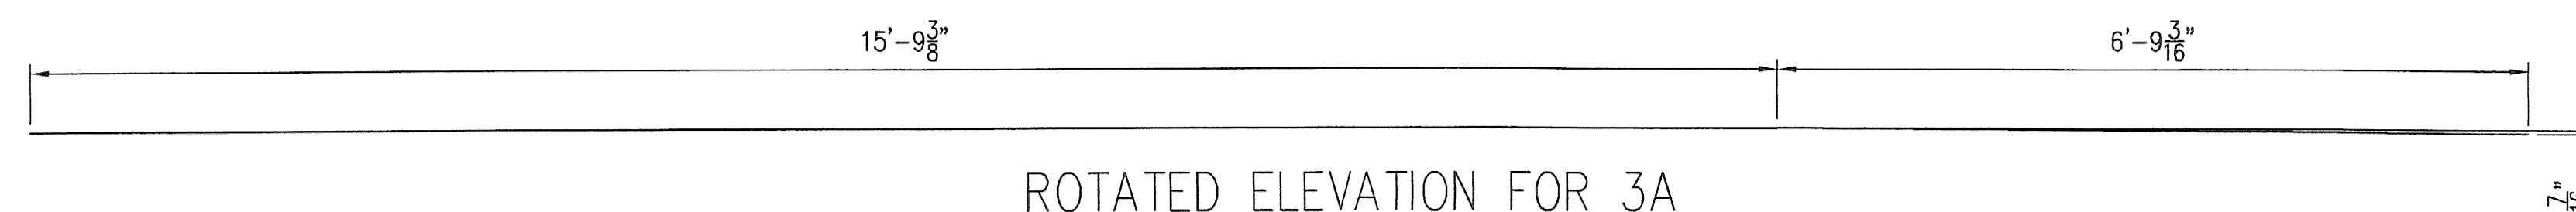

ROTATED ELEVATION FOR 3A

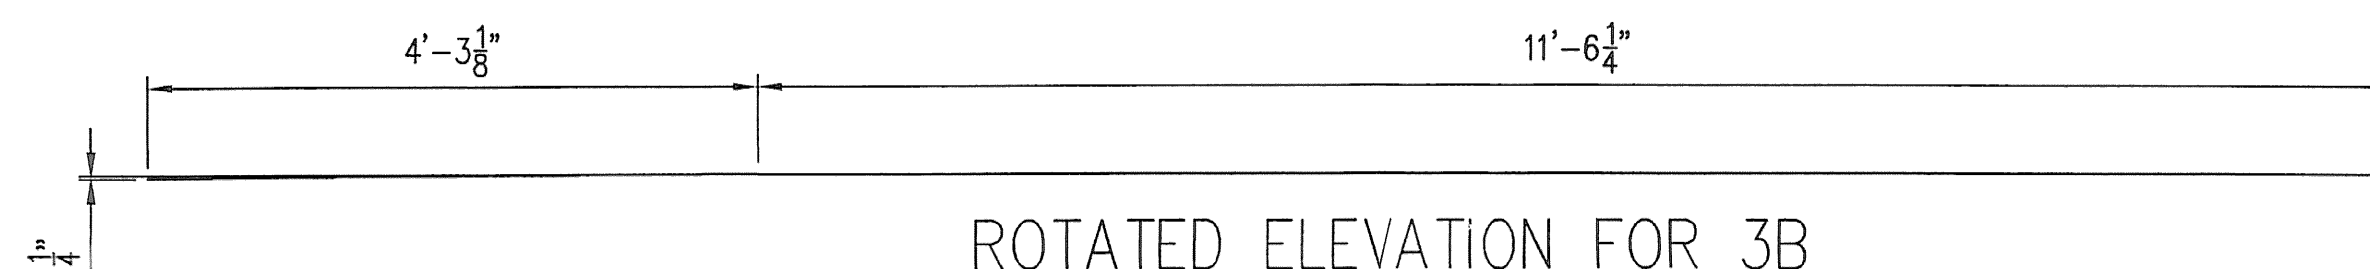


ROTATED ELEVATION FOR 3B

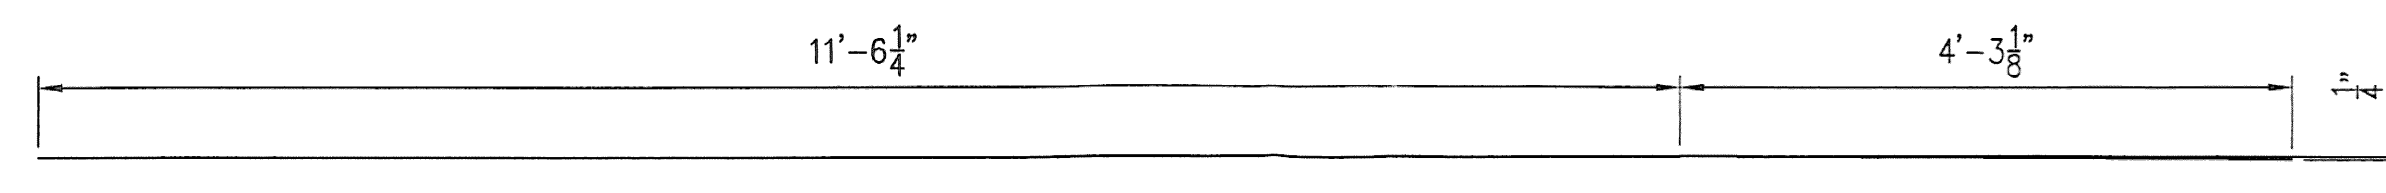

ROTATED ELEVATION FOR 4A




ROTATED ELEVATION FOR 4B

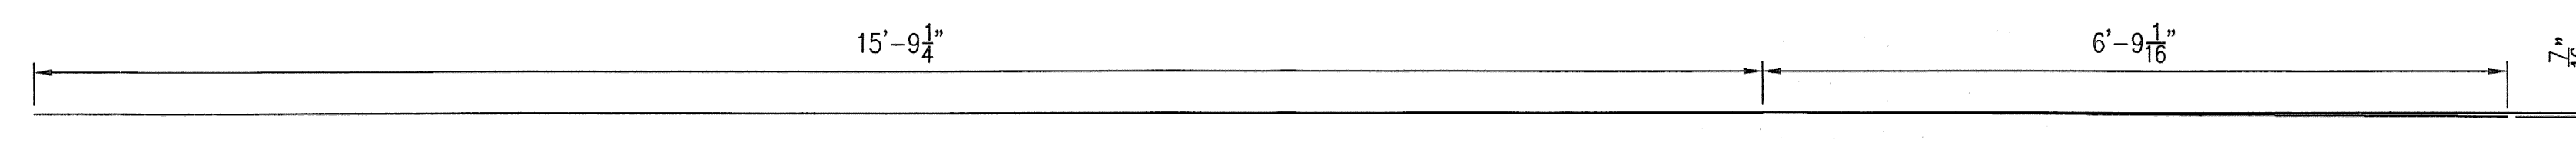


ROTATED ELEVATION FOR 5A



ROTATED ELEVATION FOR 5B

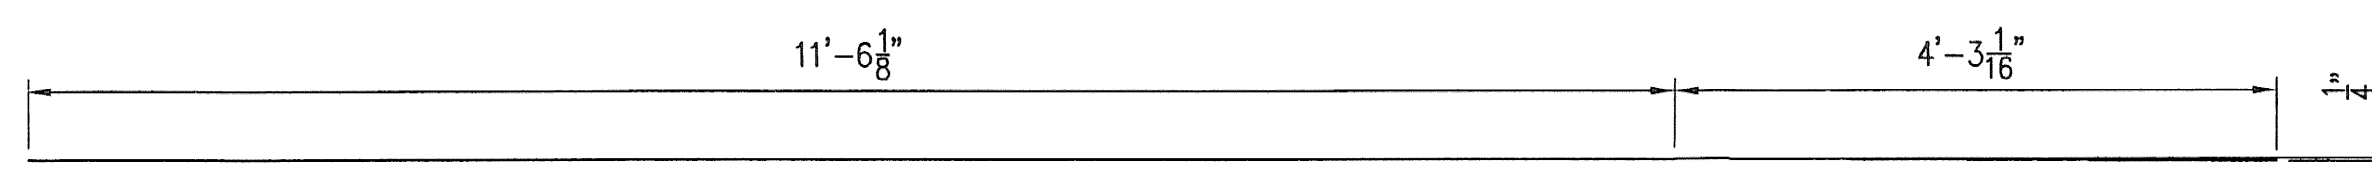

ROTATED ELEVATION FOR 6A

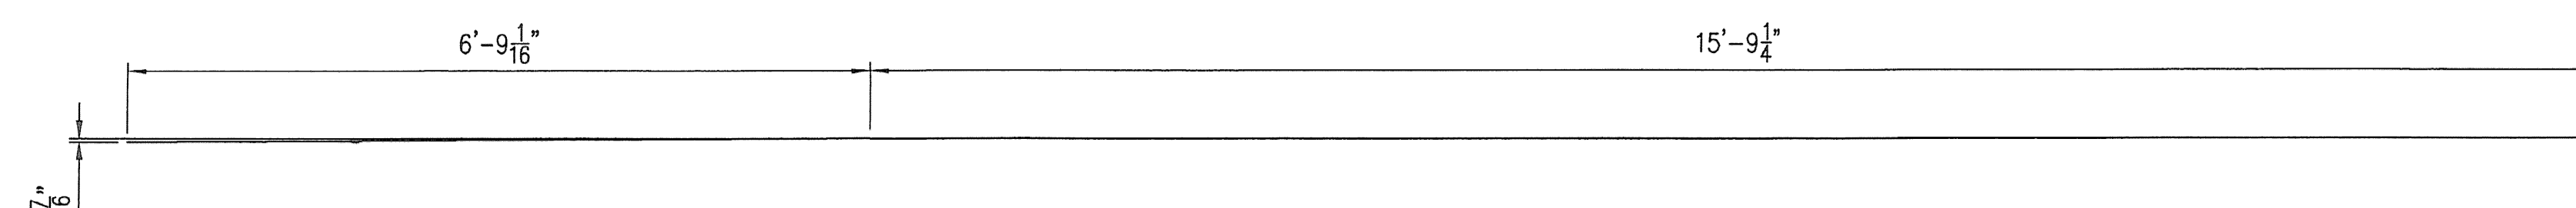

ROTATED ELEVATION FOR 6B

THIS SHEET IS FOR SHOP USE ONLY

SHOP NOTE:
ALL DIMENSIONS ARE GIVEN ALONG C OF JOINT.

SHOP DRAWING REVIEW

☒ REVIEWED AS REQUIRED BY THE CONSTRUCTION CONTRACT DOCUMENTS AND APPROVED, BUT ONLY FOR CONFORMANCE WITH THE DESIGN DEVELOPED BY THE WORK ANALYST SUBJECT TO FURTHER LIMITATIONS AND REQUIREMENTS CONTAINED IN THE CONSTRUCTION CONTRACT DOCUMENTS.

☐ REJECTED ☐ REVISE AND REPERMIT ☐ PENDING AND RE-REQUIRED

CONSTRUCTION OR CONSULTING FIRM: **Vanessa/Jamgon Brustin, Inc.**
 REVIEWED CONSTRUCTION: **Vanessa/Jamgon Brustin, Inc.**
 SPECIFICATIONS: **AS PER THE SPECIFICATIONS OF THE PROJECT**
 DESIGN CONSULTANT: **AS PER THE DESIGN CONSULTANT'S REQUIREMENTS**
 IN THE CONSTRUCTION: **AS PER THE CONSTRUCTION REQUIREMENTS**
 CONSTRUCTION: **AS PER THE CONSTRUCTION REQUIREMENTS**
 TECHNOLOGICAL OR CONSTRUCTION: **AS PER THE TECHNOLOGICAL OR CONSTRUCTION REQUIREMENTS**
 AND PERFORMANCE: **AS PER THE PERFORMANCE REQUIREMENTS**

Job Number: **50929**
 Reviewed By: **ASR**
 Date: **2/21/01**

VJB Vanessa/Jamgon Brustin, Inc.
 Engineering, Planning and Architects
 800 - 360-0000
 20000 N. 10th Street, Suite 200
 Scottsdale, AZ 85260 602-544-0888

[illegible]