
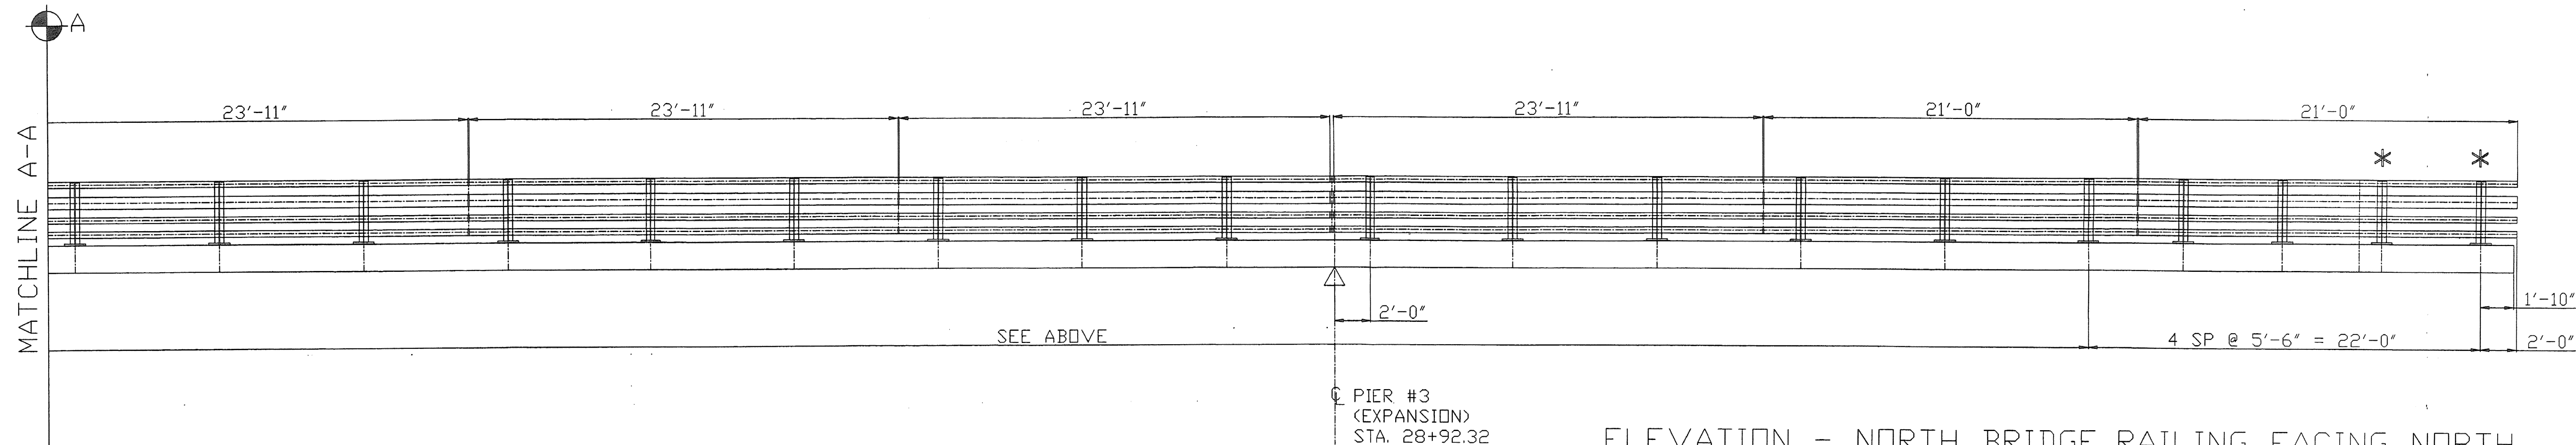


BILL OF MATERIAL			
Mk.	Qty.	Description	Total wgt.

△ * - DENOTES SPECIAL WING WALL POST SEE SECTION "N" PAGE 2/2
VERIFIED BY FIELD MEASUREMENTS 9/25/00

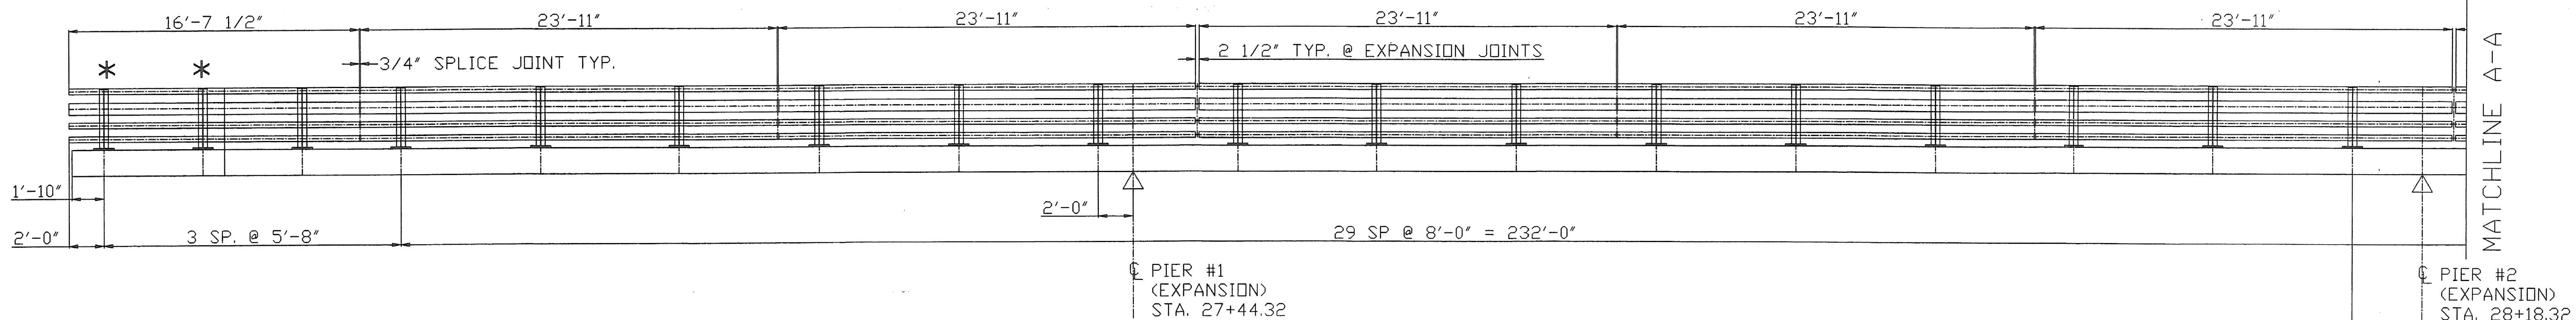

ELEVATION - NORTH BRIDGE RAILING FACING NORTH
SOUTH BRIDGE RAILING SIMILAR
TOTAL PAY LIMIT ITEM 525.34(BRIDGE RAILING - 4 RAIL) = 550 LF

THE BRIDGE RAIL LAYOUT SHOWN IS BASED ON INFORMATION FROM EXISTING PLANS.
THE CONTRACTOR SHALL VERIFY THE PROPOSED BRIDGE RAIL LAYOUT PRIOR TO THE
FABRICATION OF BRIDGE RAIL.

REVISIONS		
No.	Remarks	Date
0	Initial submittal	8/7/00
1	misc corrections. field verification	10/6/00

SHOP DRAWING REVIEW	
☒ REVIEWED AS REQUIRED BY THE CONSTRUCTION CONTRACT DOCUMENTS AND APPROVED, BUT ONLY FOR CONFORMANCE TO THE DESIGN CONCEPT OF THE WORK, AND SUBJECT TO FURTHER LIMITATIONS AND REQUIREMENTS CONTAINED IN THE CONSTRUCTION CONTRACT DOCUMENTS. ☐ REJECTED ☐ REVISE AND RESUBMIT ☐ FORWARDED AS CORRECTED	
CORRECTIONS OR COMMENTS MADE ON THE SHOP DRAWING SHALL BE MADE IN THE MARGINS OF THIS SHEET. THE CONTRACTOR SHALL BE RESPONSIBLE FOR OBTAINING THE NECESSARY APPROVALS FROM THE DESIGNER AND THE OWNER. THE CONTRACTOR SHALL BE RESPONSIBLE FOR OBTAINING THE NECESSARY APPROVALS FROM THE DESIGNER AND THE OWNER. THE CONTRACTOR SHALL BE RESPONSIBLE FOR OBTAINING THE NECESSARY APPROVALS FROM THE DESIGNER AND THE OWNER.	
VHB Vermont Highway Builders, Inc. Engineers, Planners and Surveyors 500 State Street, Room 200 Burlington, VT 05401-1000 Phone: (802) 244-0000	Job Number: 50929 Reviewed By: ASR Date: 1-19-01

HIGHWAY SAFETY CORP.	
GLASTONBURY, CT	
ITEM 525.34 - BRIDGE RAILING - NETC 4 RAIL	
CITY OF SOUTH BURLINGTON US ROUTE 20VER I-89 @ EXIT 14 IM DECK(36) BRIDGE #68	
DRAWN P. VUKAS CHECKED <i>[Signature]</i> DATE 07-23-00 SCALE NONE HSC REFERENCE NO. 1213 SIZE D REVISION 1 SHEET NO. 1 of 2	GENERAL CONTRACTOR SUB CONTRACTOR F.R. LAFAYETTE, INC.