


STATE OF VERMONT AGENCY OF TRANSPORTATION



PROPOSED IMPROVEMENT CITY OF SOUTH BURLINGTON COUNTY OF CHITTENDEN

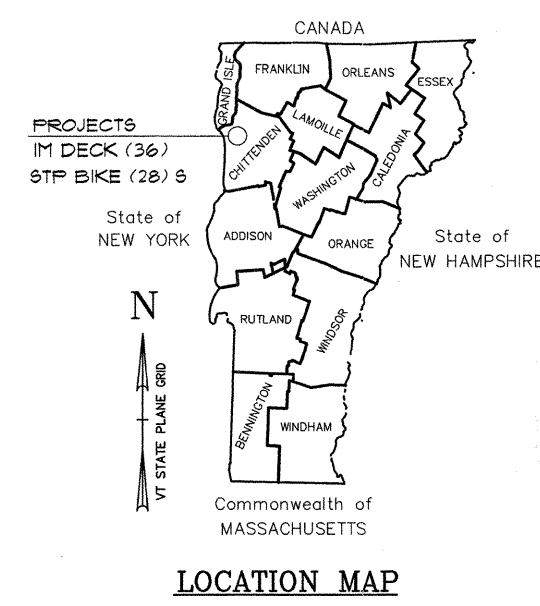

IM DECK (36)	BRIDGE NO. : 68	STP BIKE (28) S
ROUTE NO. : 1-89	PROJECT LOCATION: U.S. 2 (WILLISTON RD.) OVER I-89	PROJECT DESCRIPTION: U.S. 2 (WILLISTON RD.) OVER I-89
PROJECT LOCATION: U.S. 2 (WILLISTON RD.) OVER I-89	PROJECT DESCRIPTION: INSTALL TRAFFIC CONTROL, REHABILITATE	CONSTRUCT SIDEWALK AND BIKEWAY ALONG
PROJECT DESCRIPTION: INSTALL TRAFFIC CONTROL, REHABILITATE	STRUCTURE, REMOVE TRAFFIC CONTROL	U.S. 2 BETWEEN STA. 2100 AND 36461
LENGTH OF STRUCTURE: 261.00'	LENGTH OF PROJECT: 1561.00'	
LENGTH OF PROJECT: 1723.00'		




RECORD PLANS

CONTRACTOR: J.A. McDONALD - LYNDON CTR. VT.
 RESIDENT ENGINEER: ROBERT SUCKERT
 CONSTRUCTION BEGAN: JUNE 17, 2004
 CONSTRUCTION COMPLETE: APRIL 27, 2004
 RECORD PLANS BY: R. SUCKERT, D. HOSKING & N. GARBARICK

I HEREBY CERTIFY THAT ALL THE CONSTRUCTION REQUIRED BY THIS SET OF DRAWINGS HAS BEEN ACCOMPLISHED AS INDICATED HEREIN.

BY: *[Signature]* RESIDENT ENGINEER
 DATE: 6-2-09

NOTE: Any further information concerning final quantities, amounts or other details relative to this project may be found at Central File in the electronic archives.

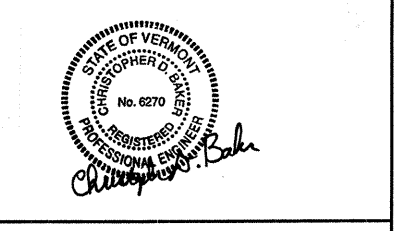

THESE PLANS ARE SUBJECT TO SUCH ENGINEERING CHANGES AS MAY BE REQUIRED BY THE FEDERAL HIGHWAY ADMINISTRATION OR THE CHIEF ENGINEER. CONSTRUCTION IS TO BE CARRIED ON IN ACCORDANCE WITH THESE PLANS AND THE STANDARD SPECIFICATIONS FOR CONSTRUCTION DATED 1990, AS APPROVED BY THE FEDERAL HIGHWAY ADMINISTRATION ON MARCH 15, 1990 FOR USE ON THIS PROJECT, INCLUDING ALL SUBSEQUENT REVISIONS AND SUCH REVISED SPECIFICATIONS AND SPECIAL PROVISIONS AS ARE INCORPORATED IN THESE PLANS.

APPROVED: *[Signature]* DATE 3/14/09
 DIRECTOR OF PROJECT DEVELOPMENT
 DEPARTMENT OF TRANSPORTATION
 FEDERAL HIGHWAY ADMINISTRATION

APPROVED: *[Signature]* DATE 3/14/09
 DIVISION ADMINISTRATOR

PROJECT: SOUTH BURLINGTON IM DECK(36)
 SOUTH BURLINGTON STP BIKE (28)S
 SHEET 1 OF 75 SHEETS

CONVENTIONAL SIGNS

COUNTY LINE	---
TOWN LINE	---
LIMITS OF ACCESS	---
POINT OF ACCESS	X
FENCE LINE	---
STONE WALL	---
TRAVELED WAY	---
GUARD RAIL	---
RAILROAD	---
SURVEY LINE	---
CULVERT	---
POWER POLE	---
TELEPHONE POLE	---
TREES	---
CONTROL OF ACCESS	---
PROPERTY LINE	---
R.O.W. TAKING LINE	---
SLOPE RIGHTS	---
TOP OF CUT	---
TOE OF SLOPE	---

DATUM	
VERTICAL	N/A
HORIZONTAL	N/A