


**EXISTING PLAN**

SCALE: 1"=20'

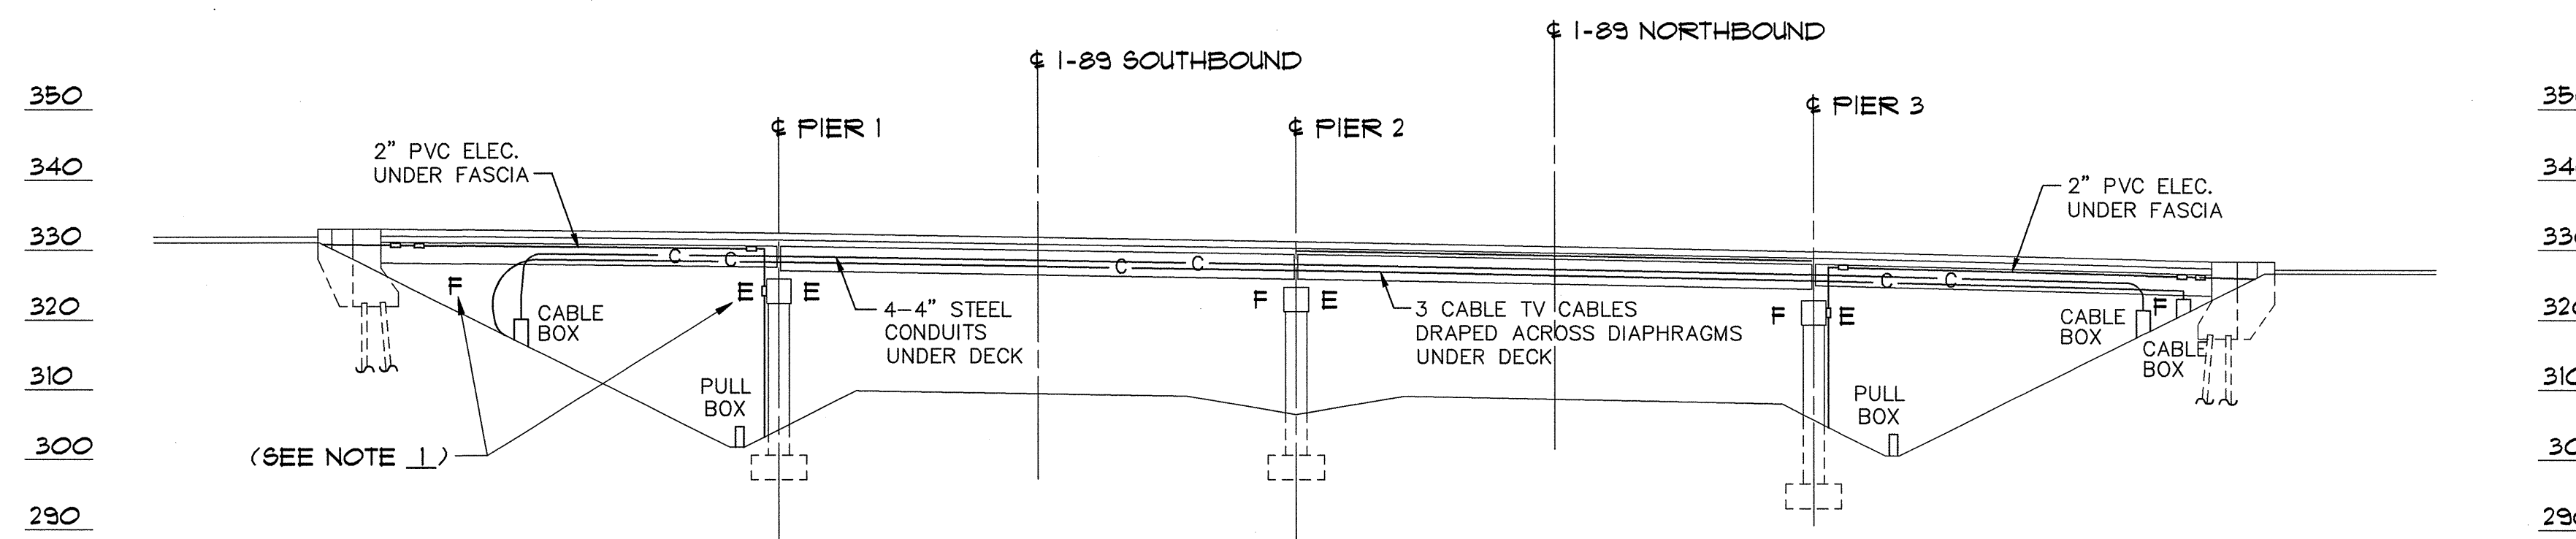

**ELEVATION**

SCALE: 1"=20'

**NOTES:**

1. ABUTMENT 1 CHANGED FROM EXPANSION TO FIXED. PIER 1 CHANGED FROM FIXED TO EXPANSION.
2. THE MINIMUM VERTICAL CLEARANCE IN THE PROPOSED CONDITION WILL BE THE SAME AS THE EXISTING.

**STATE OF VERMONT  
AGENCY OF TRANSPORTATION**

|             |                  |            |    |
|-------------|------------------|------------|----|
| Town Of     | SOUTH BURLINGTON | Bridge No. | 68 |
| Highway No. | U.S. 2           | Log Sta.   |    |
|             |                  | Surv. Sta. |    |

U.S. 2 OVER I-89

**EXISTING PLAN & ELEVATION**

|             |             |                          |            |
|-------------|-------------|--------------------------|------------|
| Designed By | T.S. BRYANT | Drawn By                 | B.J. MASSE |
| Checked By  | A. SETAS    | Date                     | 1/00       |
|             |             | Bridge Design Supervisor | C.D. BAKER |
|             |             | Date                     | 1/00       |

|         |                  |             |              |
|---------|------------------|-------------|--------------|
| PROJECT | SOUTH BURLINGTON | PROJECT NO. | IM DECK (36) |
|---------|------------------|-------------|--------------|

|                     |         |       |          |
|---------------------|---------|-------|----------|
| VHB Cad Drawing No. | 50929FE | Date  | 1/00     |
| Bridge Sheet No.    |         | Sheet | 6A of 75 |