


- NOTES:**
1. For General Notes see Br 1.
 2. For pier elevations see Br 4.
 3. For pier details see Br 6.
 4. For estimate of quantities see Br 4.

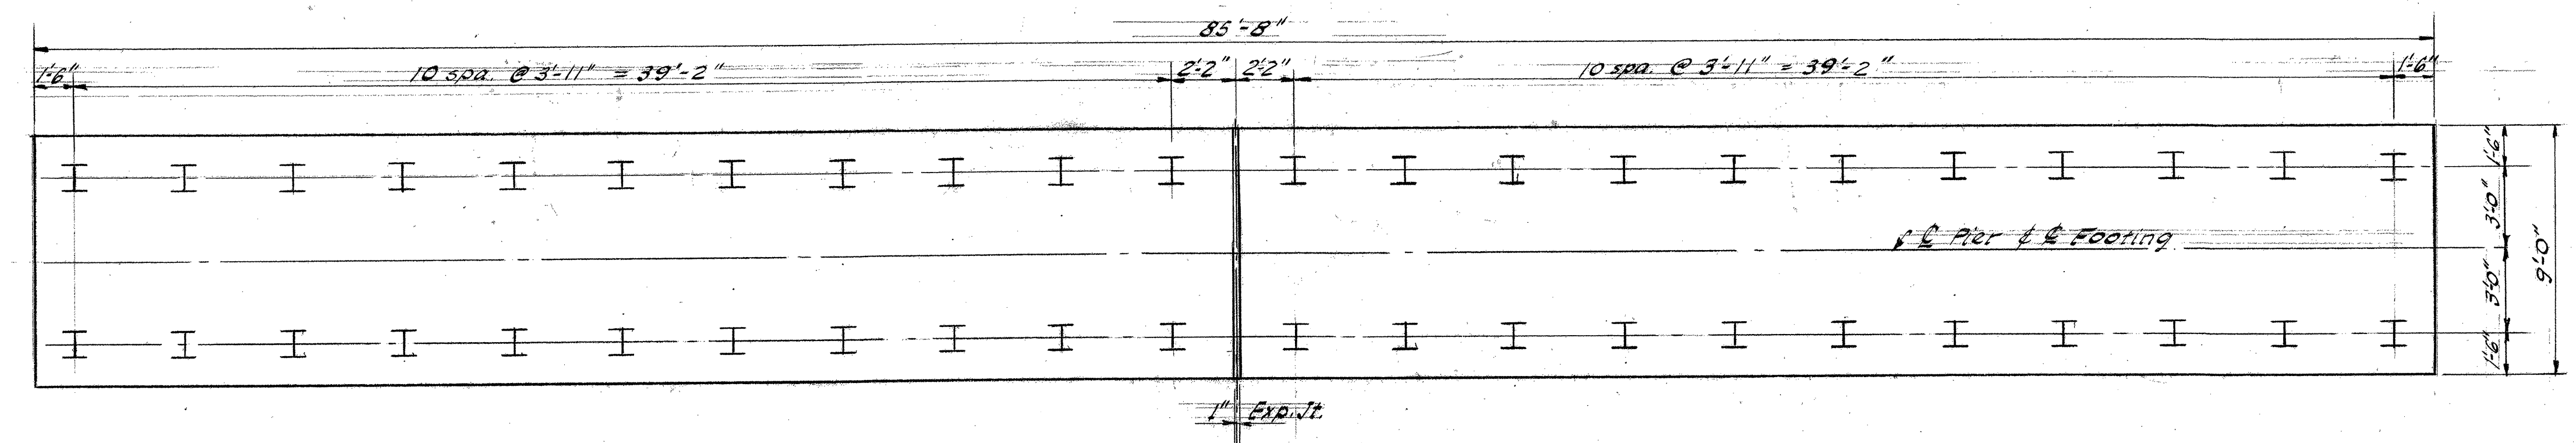

PILE PLAN

44 - 35" Steel H Piles ea Pier
 Estimated av'g Pile Length
 Pier #1 - 40'
 Pier #2 - 30'
 Pier #3 - 45'

SOUTH BURLINGTON IM DECK(56)
 FOR REFERENCE ONLY - BRIDGE 68
 SHEET 64 OF 75

STATE OF VERMONT DEPARTMENT OF HIGHWAYS	
INTERSTATE PROJECT IN THE TOWNS OF SOUTH BURLINGTON	
UNDERPASS STA. 2101+78.29 BURLINGTON INTERCHANGE PIER PLANS	
BOSWELL ENGINEERING CO. RIDGEFIELD PARK, N.J.	
DRAWN BY A.M.	IN CHARGE A.J.L.
CHECKED BY M.J.C.	DATE
PROJECT NO. I 89 - 3 (I2)	SHEET 54 OF 125