




**WEST ABUTMENT PLAN**  
SCALE: 1/4"=1'-0"

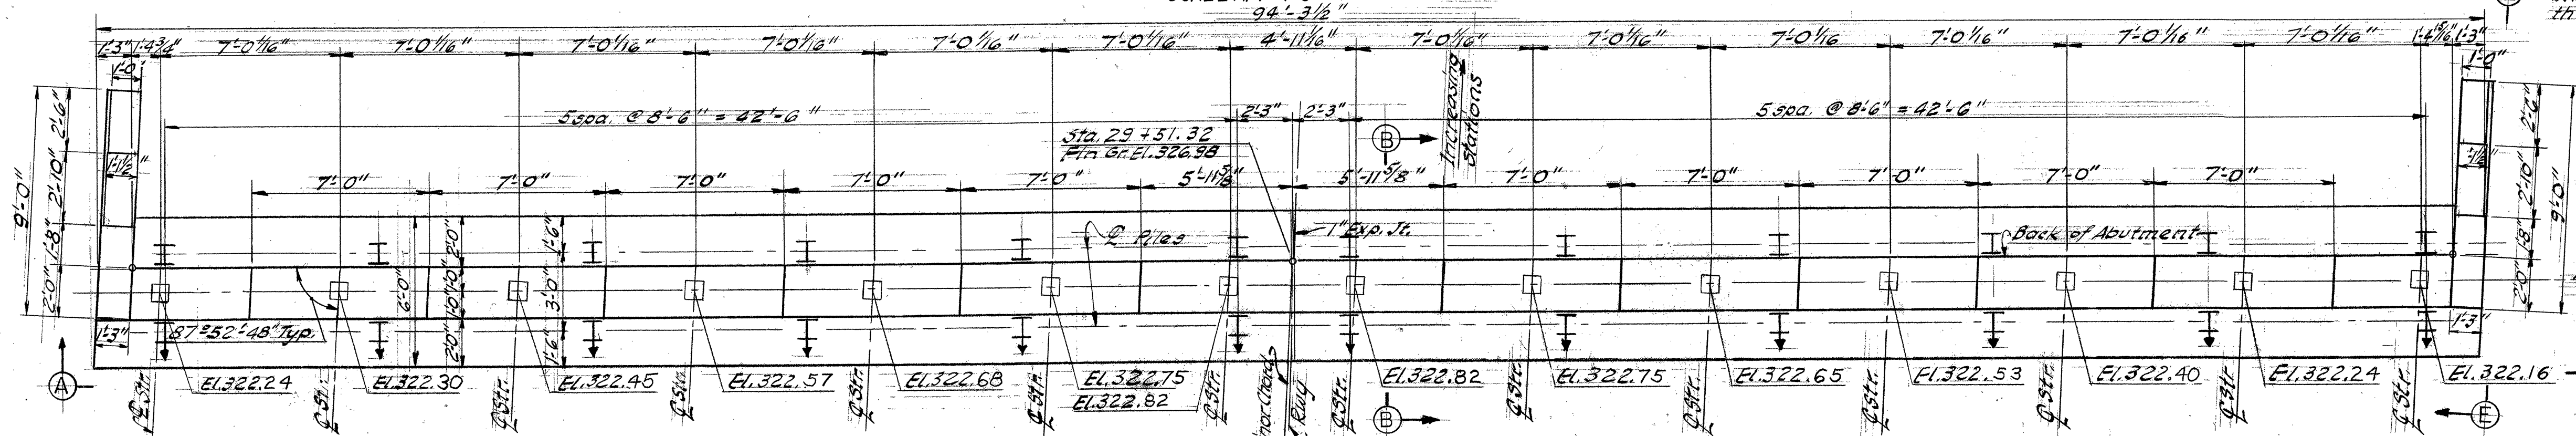

**EAST ABUTMENT PLAN**  
SCALE: 1/4"=1'-0"

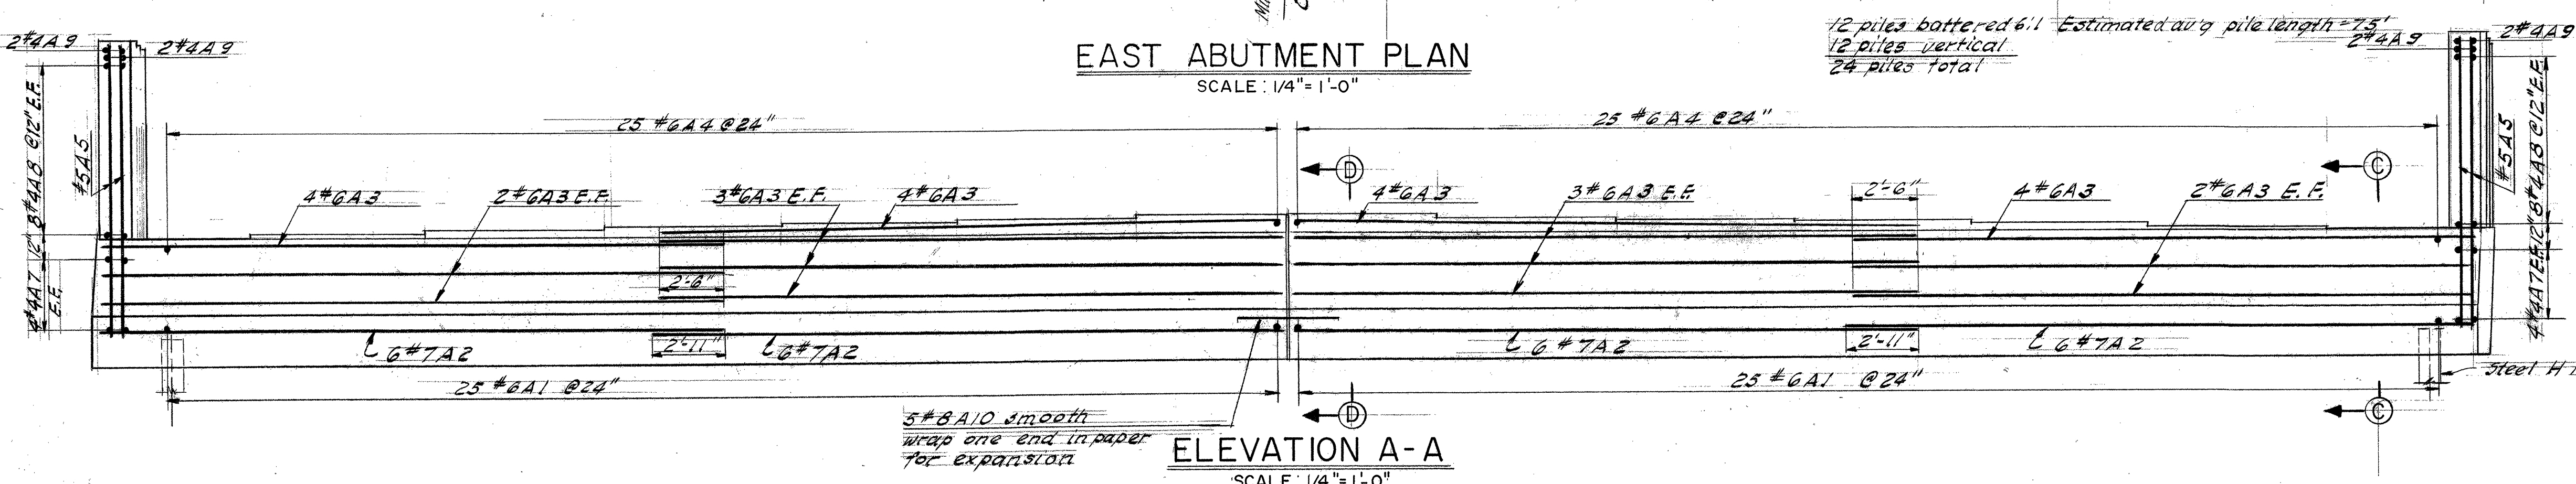


**ELEVATION A-A**  
SCALE: 1/4"=1'-0"

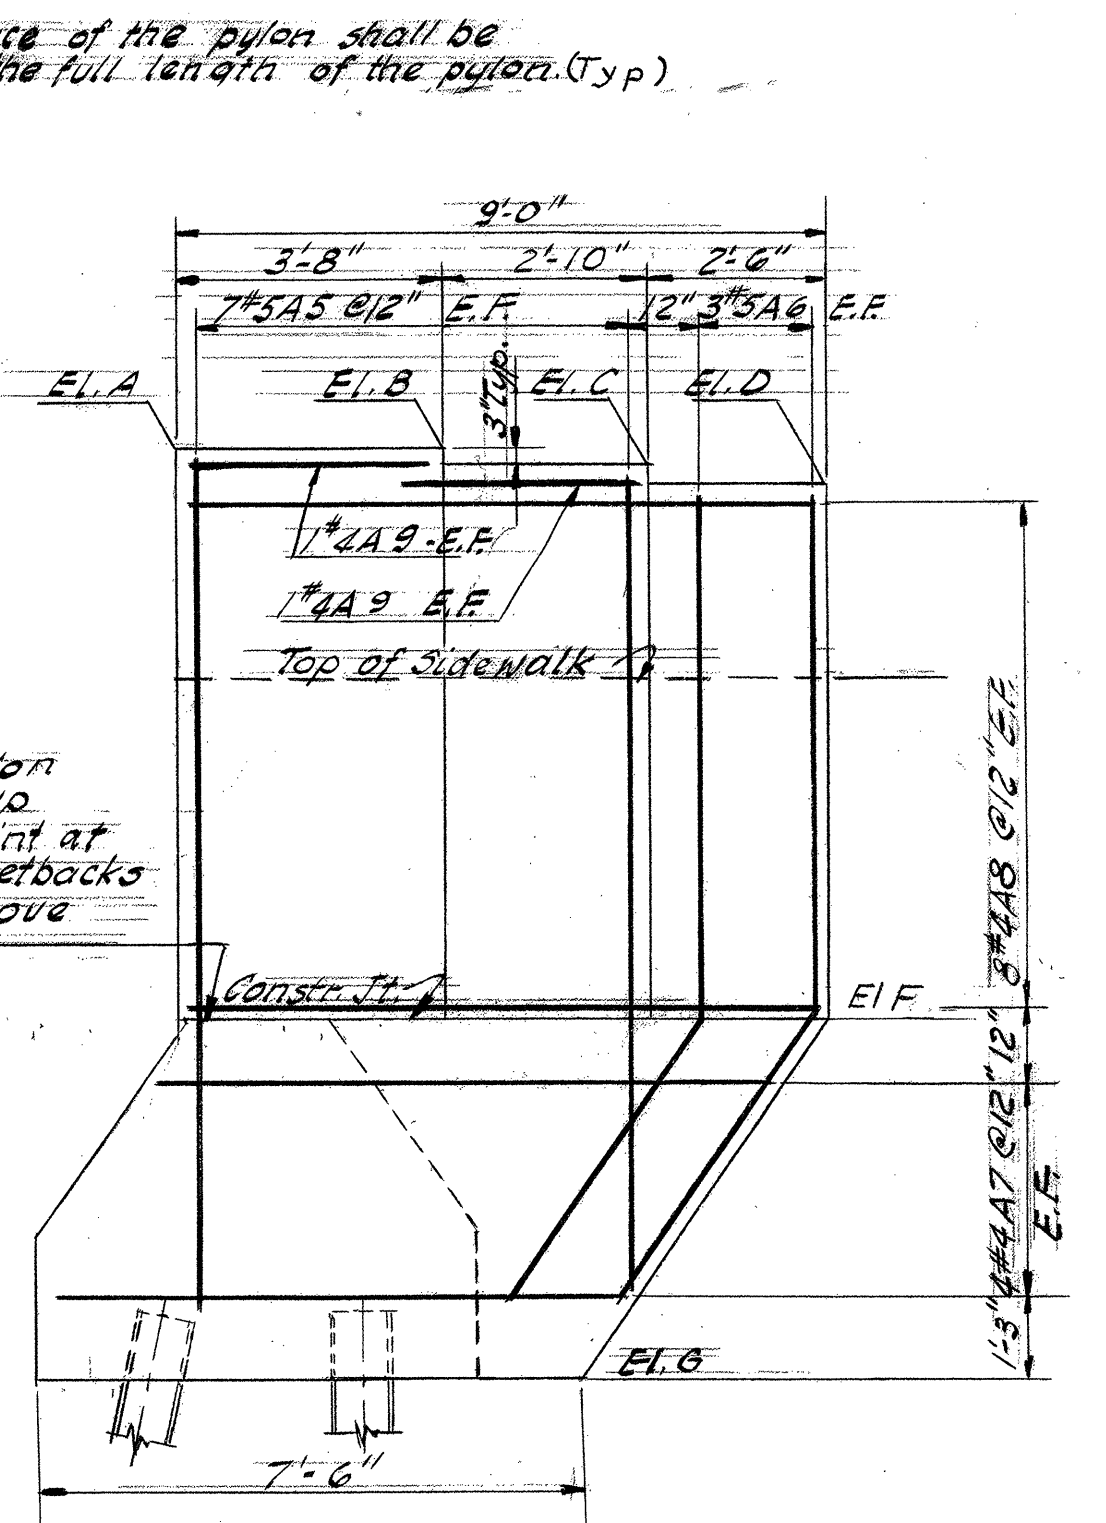

**SECTION E-E**  
SCALE: 3/8"=1'-0"

ELEV.	WEST ABUTMENT		EAST ABUTMENT	
	LEFT PYLON	RIGHT PYLON	LEFT PYLON	RIGHT PYLON
A	335.54	335.44	330.83	330.77
B	335.59	335.48	330.74	330.68
C	335.37	335.26	330.42	330.36
D	335.15	335.04	330.16	330.04
E	327.00	326.89	322.24	322.16
G	321.89	321.89	317.16	317.16

- NOTES:**
- For General Notes see B-1
  - For additional details see SB-20-60, SB-21-56
  - I indicates battered pile
  - Left & Right are determined by looking toward increasing stations.

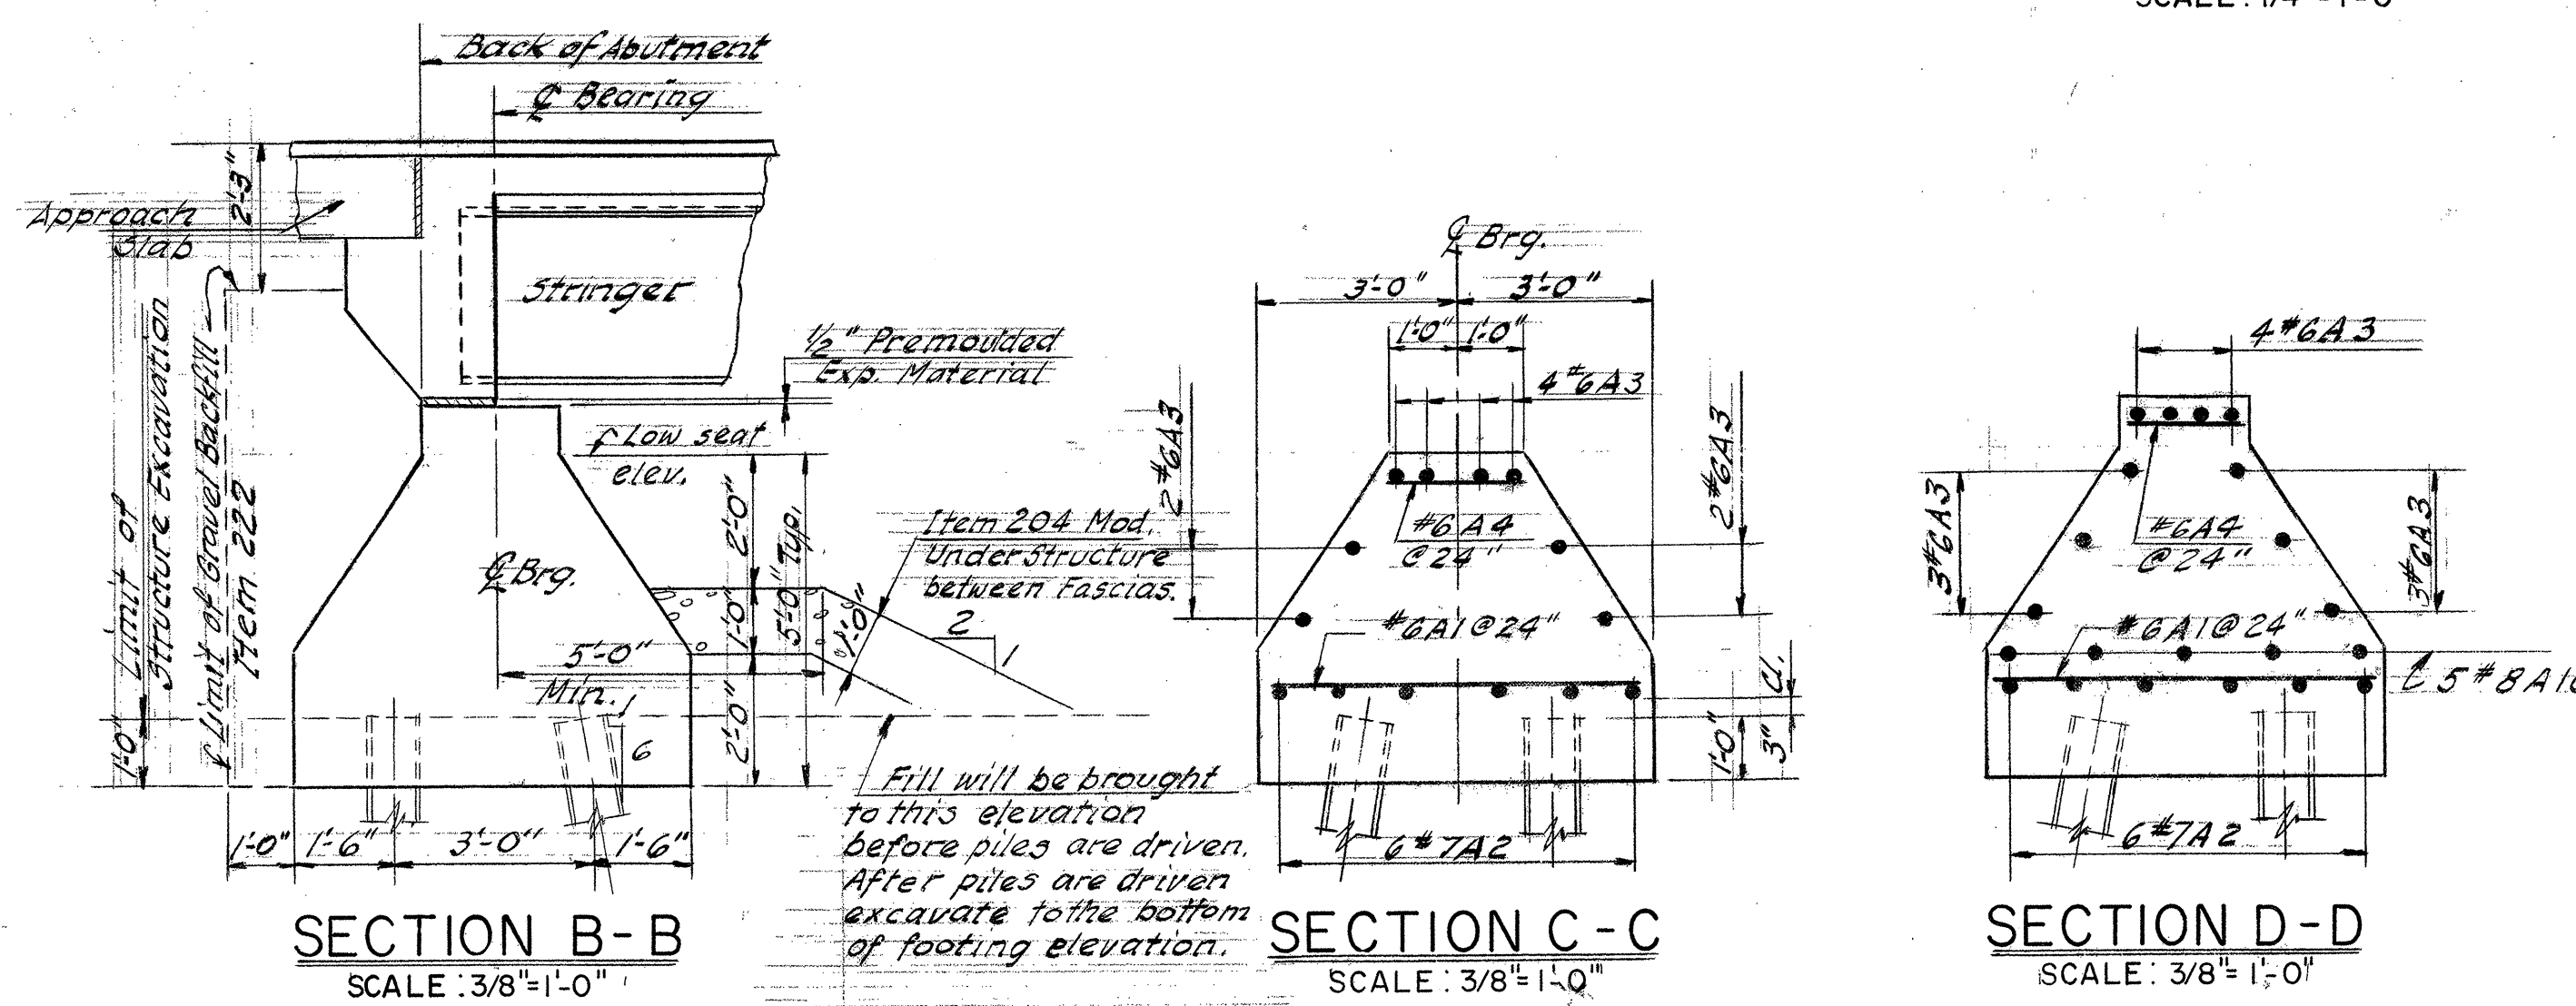

**SECTION B-B**  
SCALE: 3/8"=1'-0"

**SECTION C-C**  
SCALE: 3/8"=1'-0"

**SECTION D-D**  
SCALE: 3/8"=1'-0"

FINAL AD		ITEM #	ITEM	UNIT	WEST ABUTMENT			EAST ABUTMENT		
W. Abut.	E. Abut.				NEAT	OVERRUN	TOTAL	NEAT	OVERRUN	TOTAL
29	107	107	Structure Excavation	C.Y.	29	3	32	29	3	32
0	0	222	Gravel Backfill	C.Y.	52	5	57	52	5	57
94	96	401-B	Class B Concrete (Mod.)	C.Y.	95	5	100	95	5	100
		402	Reinforcing Steel	Lb.	See bar schedule Sh. #			160		
10	10	407	Asphaltic - Asbestos Coating	S.Y.	21		21	21		21
0	0	503	Splices for Steel Piling	Ea.	5		5	5		5
1,410	1,127	504	Steel H Piling (12.8P 53)	L.F.	1,680		1,680	1,800		1,800

SOUTH BURLINGTON IM DECK(66)  
FOR REFERENCE ONLY - BRIDGE 68  
SHEET 66 OF 75

**STATE OF VERMONT**  
DEPARTMENT OF HIGHWAYS

INTERSTATE PROJECT IN THE TOWNS OF  
SOUTH BURLINGTON

**UNDERPASS STA. 2101+78.29**  
**BURLINGTON INTERCHANGE**  
**ABUTMENT DETAILS**

BOSWELL ENGINEERING CO. RIDGEFIELD PARK, N.J.

DRAWN BY A.M. IN CHARGE A.J.L.  
CHECKED BY M.J.C. DATE SCALE AS SHOWN  
PROJECT NO. I 89 - 3 (12) SHEET 156 OF 175