


* FIELD CONDITIONS GVERNED THE NEED TO RELOCATE THE CATV & VAOT HANDHOLDS TO CLEAR EXISTING & CWD H₂O LINE & OLD ABANDONED SHEET PILING. PLUS, A MASS OF EXISTING UNDERGROUND ELECTRIC CONDUITS WERE PRESENT.

** Holiday Inn Maintenance Cleared brush along Row Fence 10/02. Saw Left Remainder of Maple logs from clearing operations for Holiday Inn @ their Request (11/12/02)

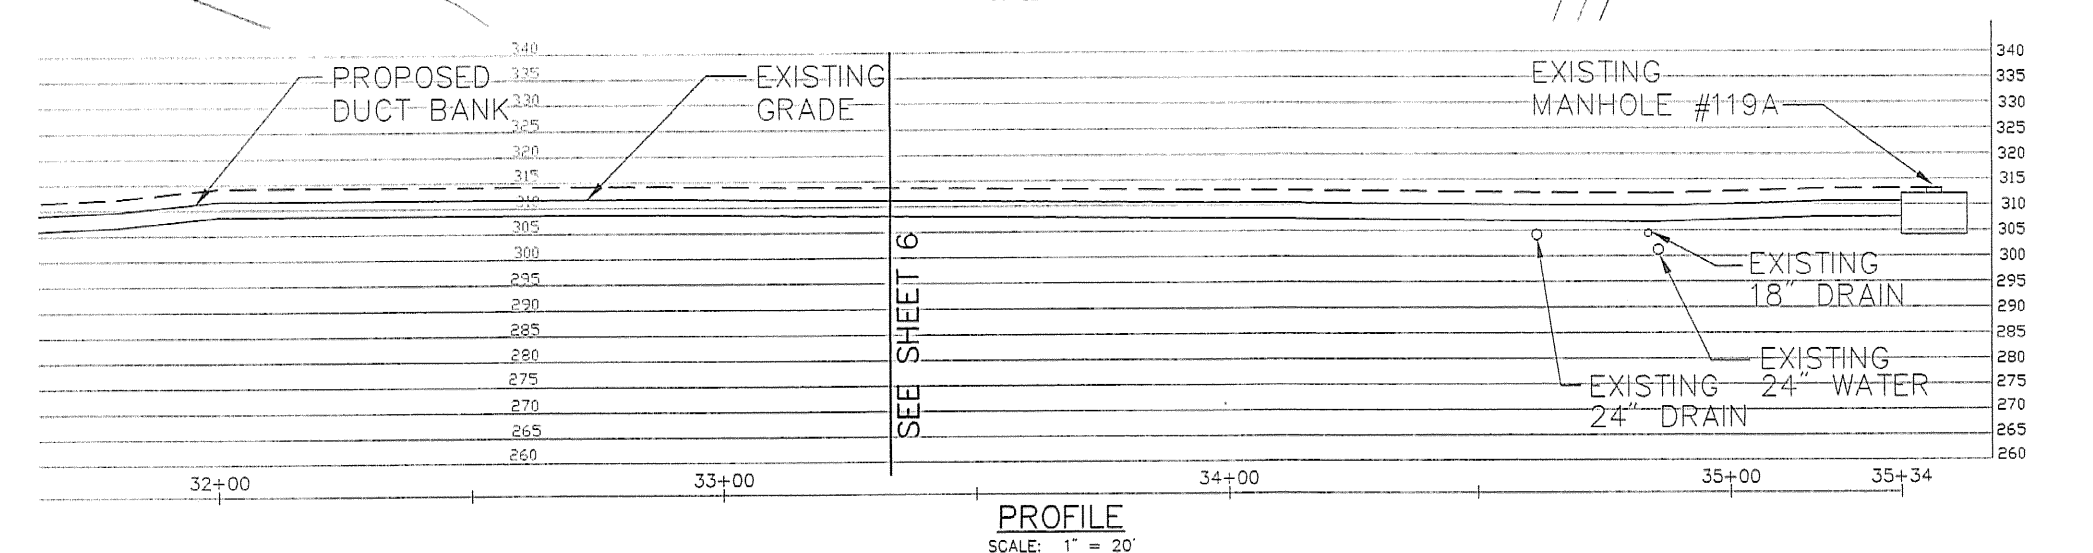

STATE OF VERMONT AGENCY OF TRANSPORTATION	
Town Of SOUTH BURLINGTON	Bridge No. 68
Highway No. U.S. 2	Lot Site
	Date Site
U.S. 2 OVER I-89	
TELECOMMUNICATIONS RELOCATION	
Designed By: M. WATERS	Drawn By: M. WATERS
Checked By: S. JOHNSON	Bridge Design Supervisor
	Date
PROJECT	PROJECT NO.
SOUTH BURLINGTON	IM DECK(36)
Mill Log Drawn No. VTRANS-GEN	Date 10/21/01
Bridge Sheet No. 1 of 3	Sheet 5 of 15

VANASSE HANGEN BRUSTLIN, INC

