



**PLAN**  
SCALE: 1" = 20'

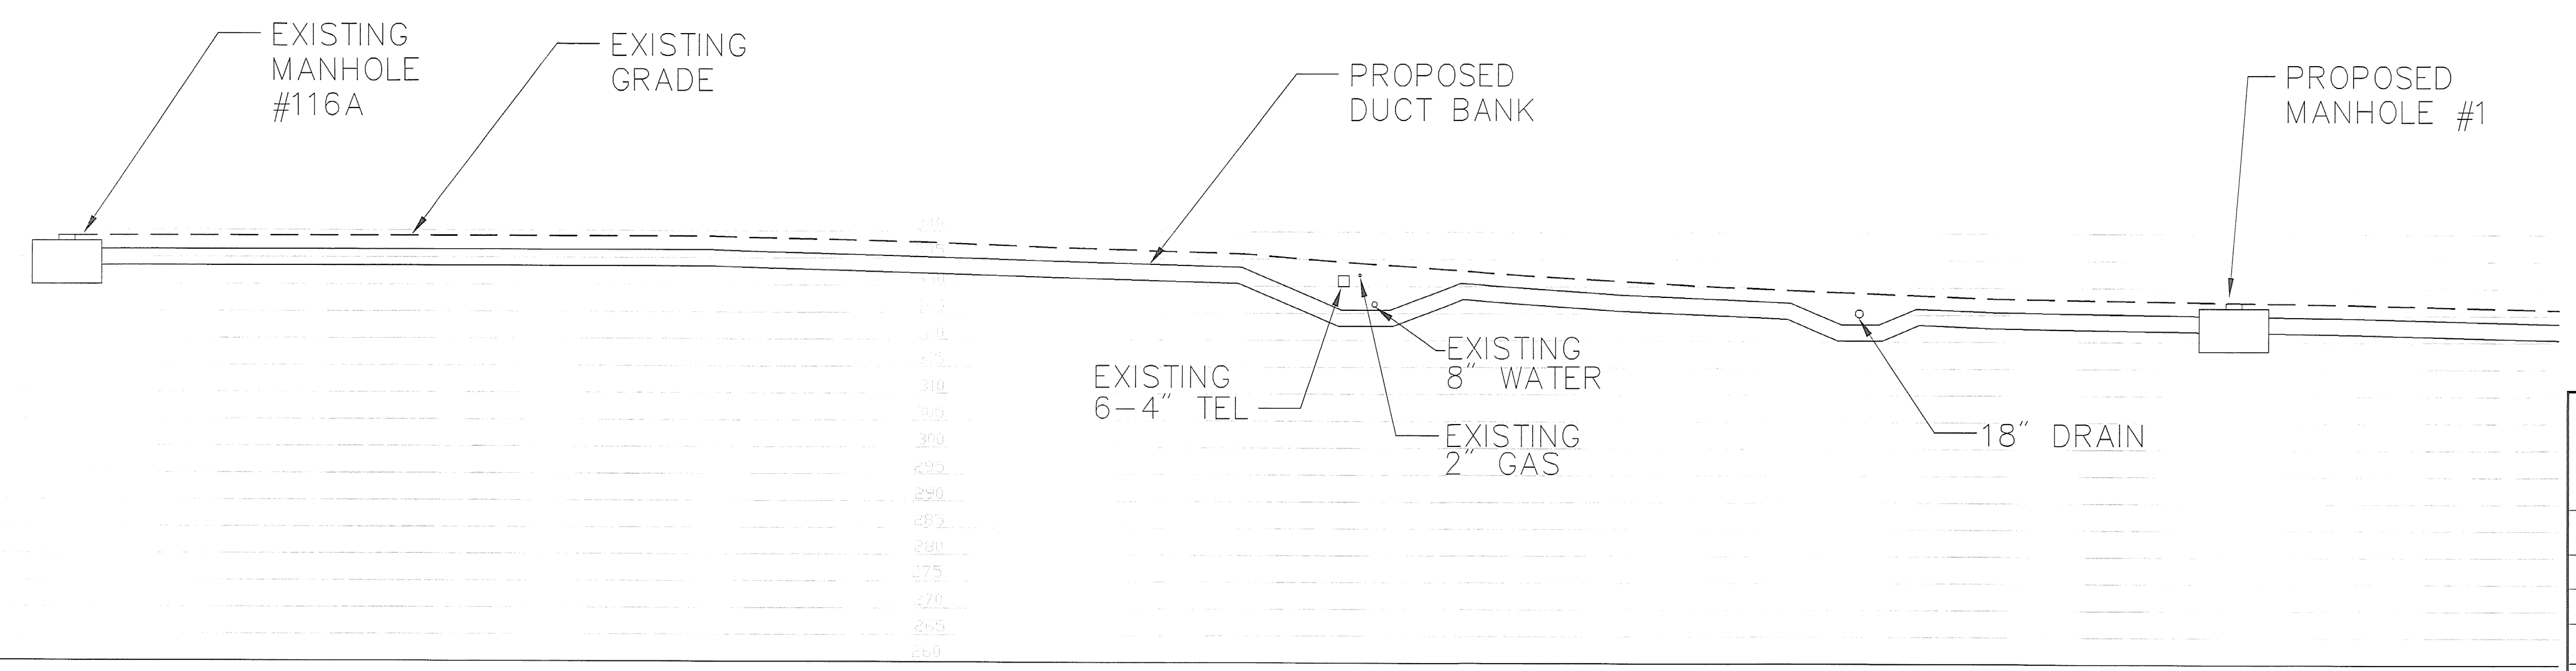

**PROFILE**  
SCALE: 1" = 20'

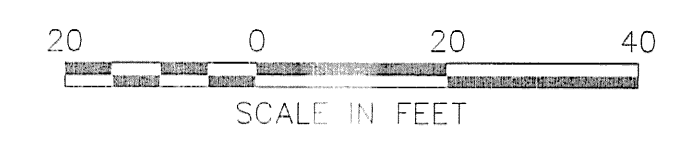

<b>STATE OF VERMONT AGENCY OF TRANSPORTATION</b>	
Town Of SOUTH BURLINGTON	Bridge No. 68
Highway No. U.S. 2	Log Sta. Surv. Sta.
U.S. 2 OVER I-89	
<b>TELECOMMUNICATIONS RELOCATION</b>	
Designed By M. HAYES	Drawn By M. HAYES
Checked By _____ Date _____	Bridge Design Supervisor S. JOHNSON Date _____
PROJECT SOUTH BURLINGTON	PROJECT NO. IM DECK(36)
VHB Cad Drawing No. VTRANS-GEN	Date 9/24/01
Bridge Sheet No. _____	Sheet 3 of 7

VANASSE HANGEN BRUSTLIN, INC.