


Robert Engineer on 3/11/01
only one diaphragm to be 30" in dia

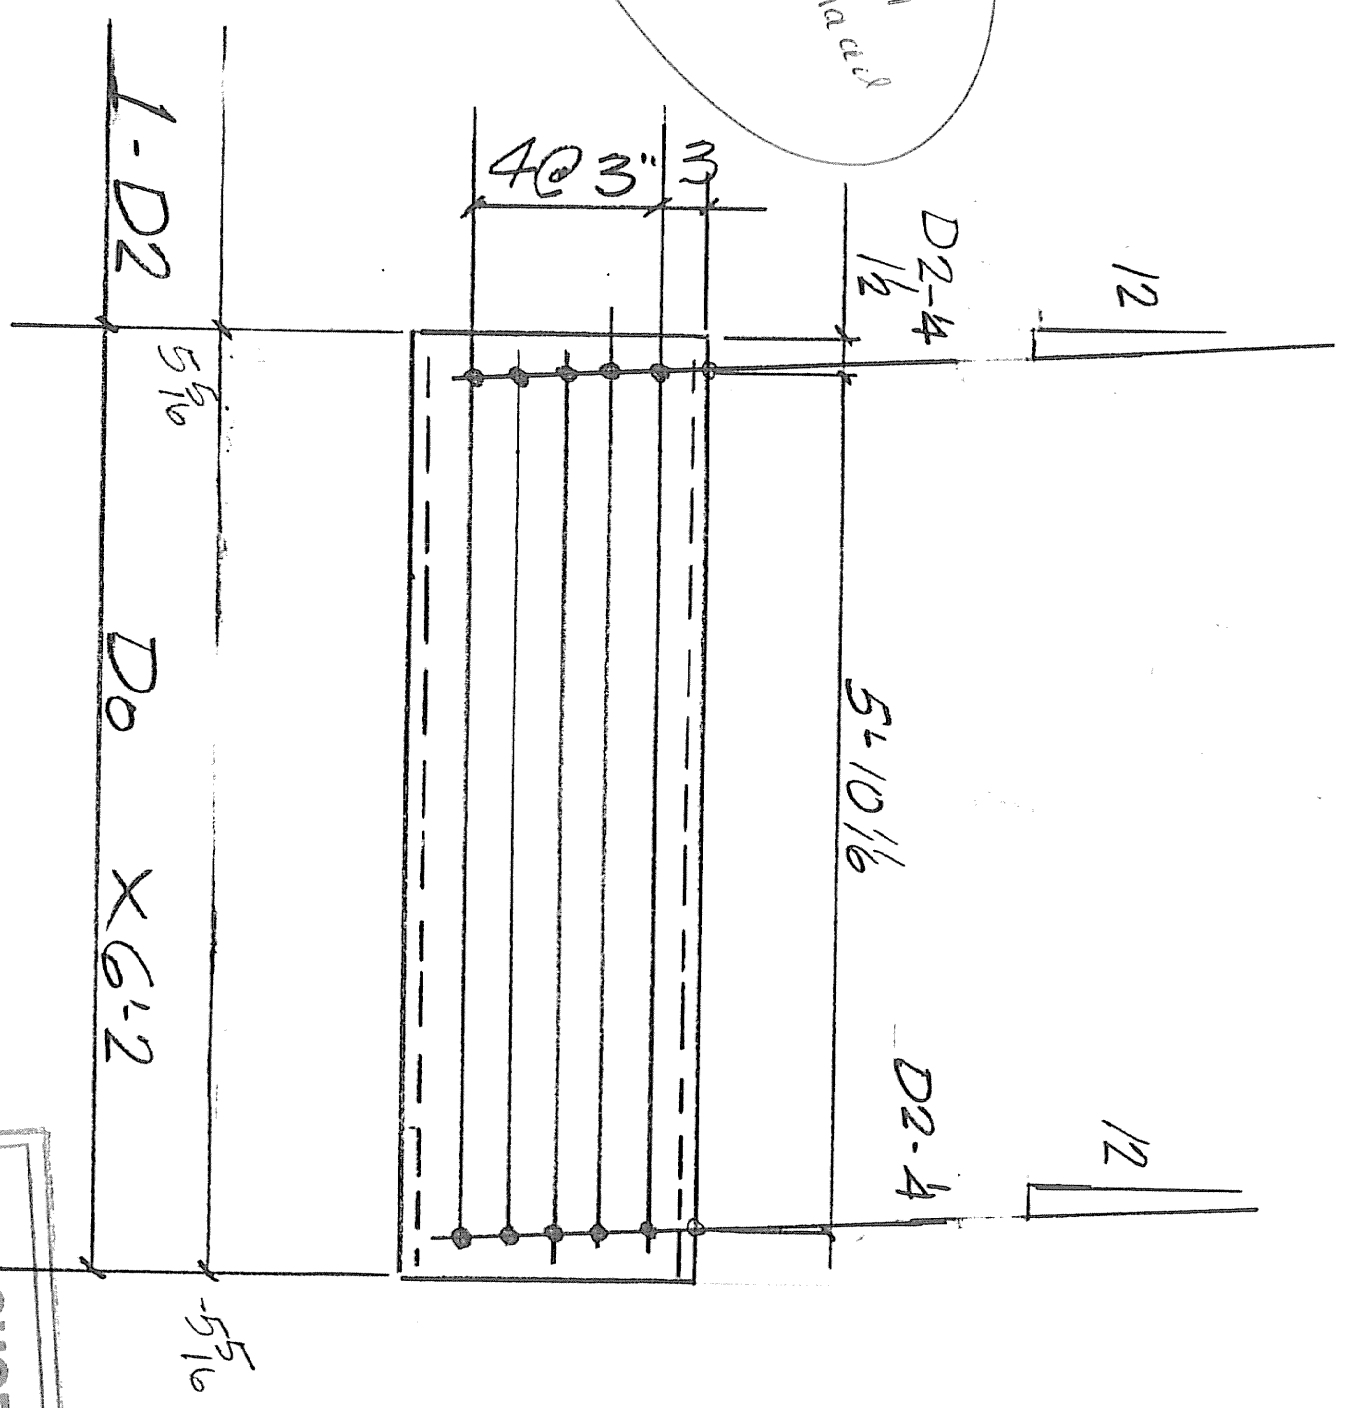

SHOP DRAWING REVIEW

REVISIONS AS REQUIRED BY THE CONSTRUCTION CONTRACT DOCUMENTS AND APPROVED, BUT NOT NECESSARILY ACCEPTED, BY THE ENGINEER, SHALL BE THE RESPONSIBILITY OF THE CONTRACTOR. THE CONTRACTOR SHALL BE RESPONSIBLE FOR OBTAINING ALL NECESSARY PERMITS AND APPROVALS FROM THE LOCAL AUTHORITIES. THE CONTRACTOR SHALL BE RESPONSIBLE FOR OBTAINING ALL NECESSARY PERMITS AND APPROVALS FROM THE LOCAL AUTHORITIES. THE CONTRACTOR SHALL BE RESPONSIBLE FOR OBTAINING ALL NECESSARY PERMITS AND APPROVALS FROM THE LOCAL AUTHORITIES.

DATE: 3/11/01

BY: [Signature]

ITEM NO.	DESCRIPTION	QTY	UNIT	REMARKS	WGT
1	MC 18 X 42.7	6	2	D2	
10	3" A307 BOLTS GALV	24		FIELD W/ NUTS	

PAY ITEM 506.60

SHOP COAT - PRIMER
PER SUP SPEC 513

DESCRIPTION: NEW DIAPHRAGMS

JOB: U.S. 2 OVER I-89

CUSTOMER: J.A. Mc DONALD

CASCO BAY STEEL STRUCTURES, INC.

75 SPRING HILL ROAD SACO, MAINE 04072

PHONE (207) 282-7360 FAX (207) 282-1179

DATE: 9-00

BY: JPE

CHKD BY: [Signature]

APPROV BY: [Signature]

DATE: 9-00

REV: 1/1