


PARTIAL PLAN

SCALE: 1"=10'-0"
(PHASE 1 & 2 SHOWN, PHASE 3 & 4 SIMILAR)

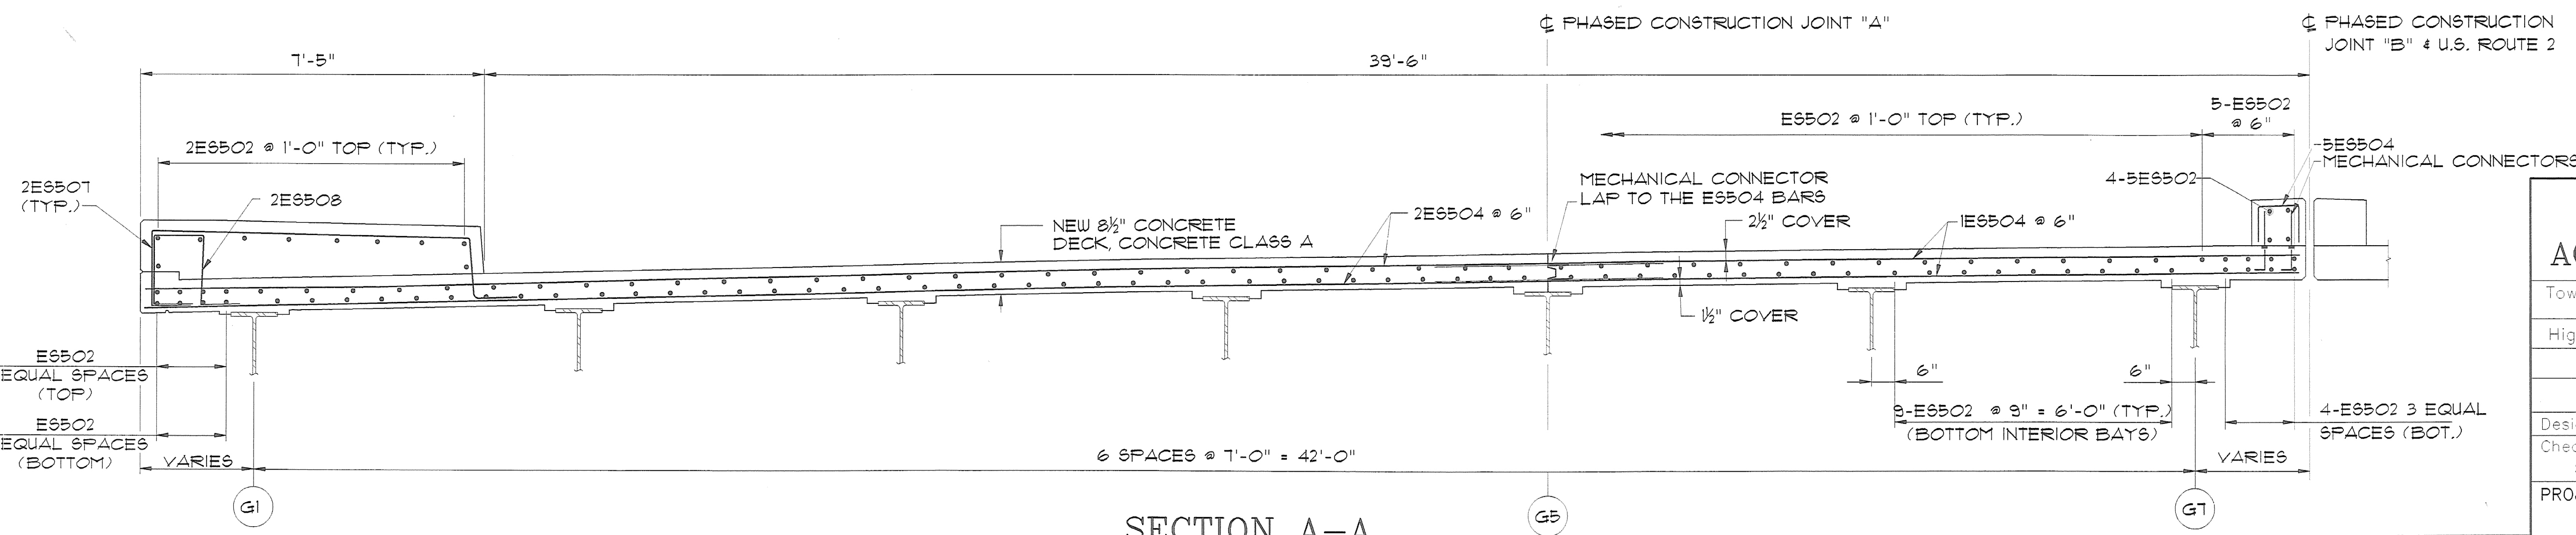

SECTION A-A

SCALE: 1/2"=1'-0"

SHEETS 11A, 11B AND 11C SHOW DECK REPLACEMENT REINFORCING. REFER TO OTHER CONTRACT SHEETS FOR ADDITIONAL INFORMATION. CONFLICTS BETWEEN THESE DRAWINGS AND OTHER CONTRACT DRAWINGS SHALL BE BROUGHT TO THE ATTENTION OF THE RESIDENT ENGINEER.

**STATE OF VERMONT
AGENCY OF TRANSPORTATION**

Town Of SOUTH BURLINGTON Bridge No. 68
Highway No. U.S. 2 Log Sta. Surv. Sta.

U.S. 2 OVER I-89

DECK REINFORCEMENT PLAN

Designed By A. ROBINSON Drawn By M. LANDREY
Checked By S. JOHNSON Date 5/9/01 Bridge Design Supervisor Date 5/9/01

PROJECT SOUTH BURLINGTON PROJECT NO. IM DECK (36)

VHB Cod Drawing No. 50929FRM Date 5/9/01
Bridge Sheet No. Sheet 11A of 75

VANASSE HANGEN BRUSTLIN, INC.