


BILL OF MATERIAL			
Mk.	Qty.	Description	Total wgt.

①* - DENOTES SPECIAL WING WALL POST SEE SECTION "N" PAGE 2/2
 VERIFIED BY FIELD MEASUREMENTS 9/25/00

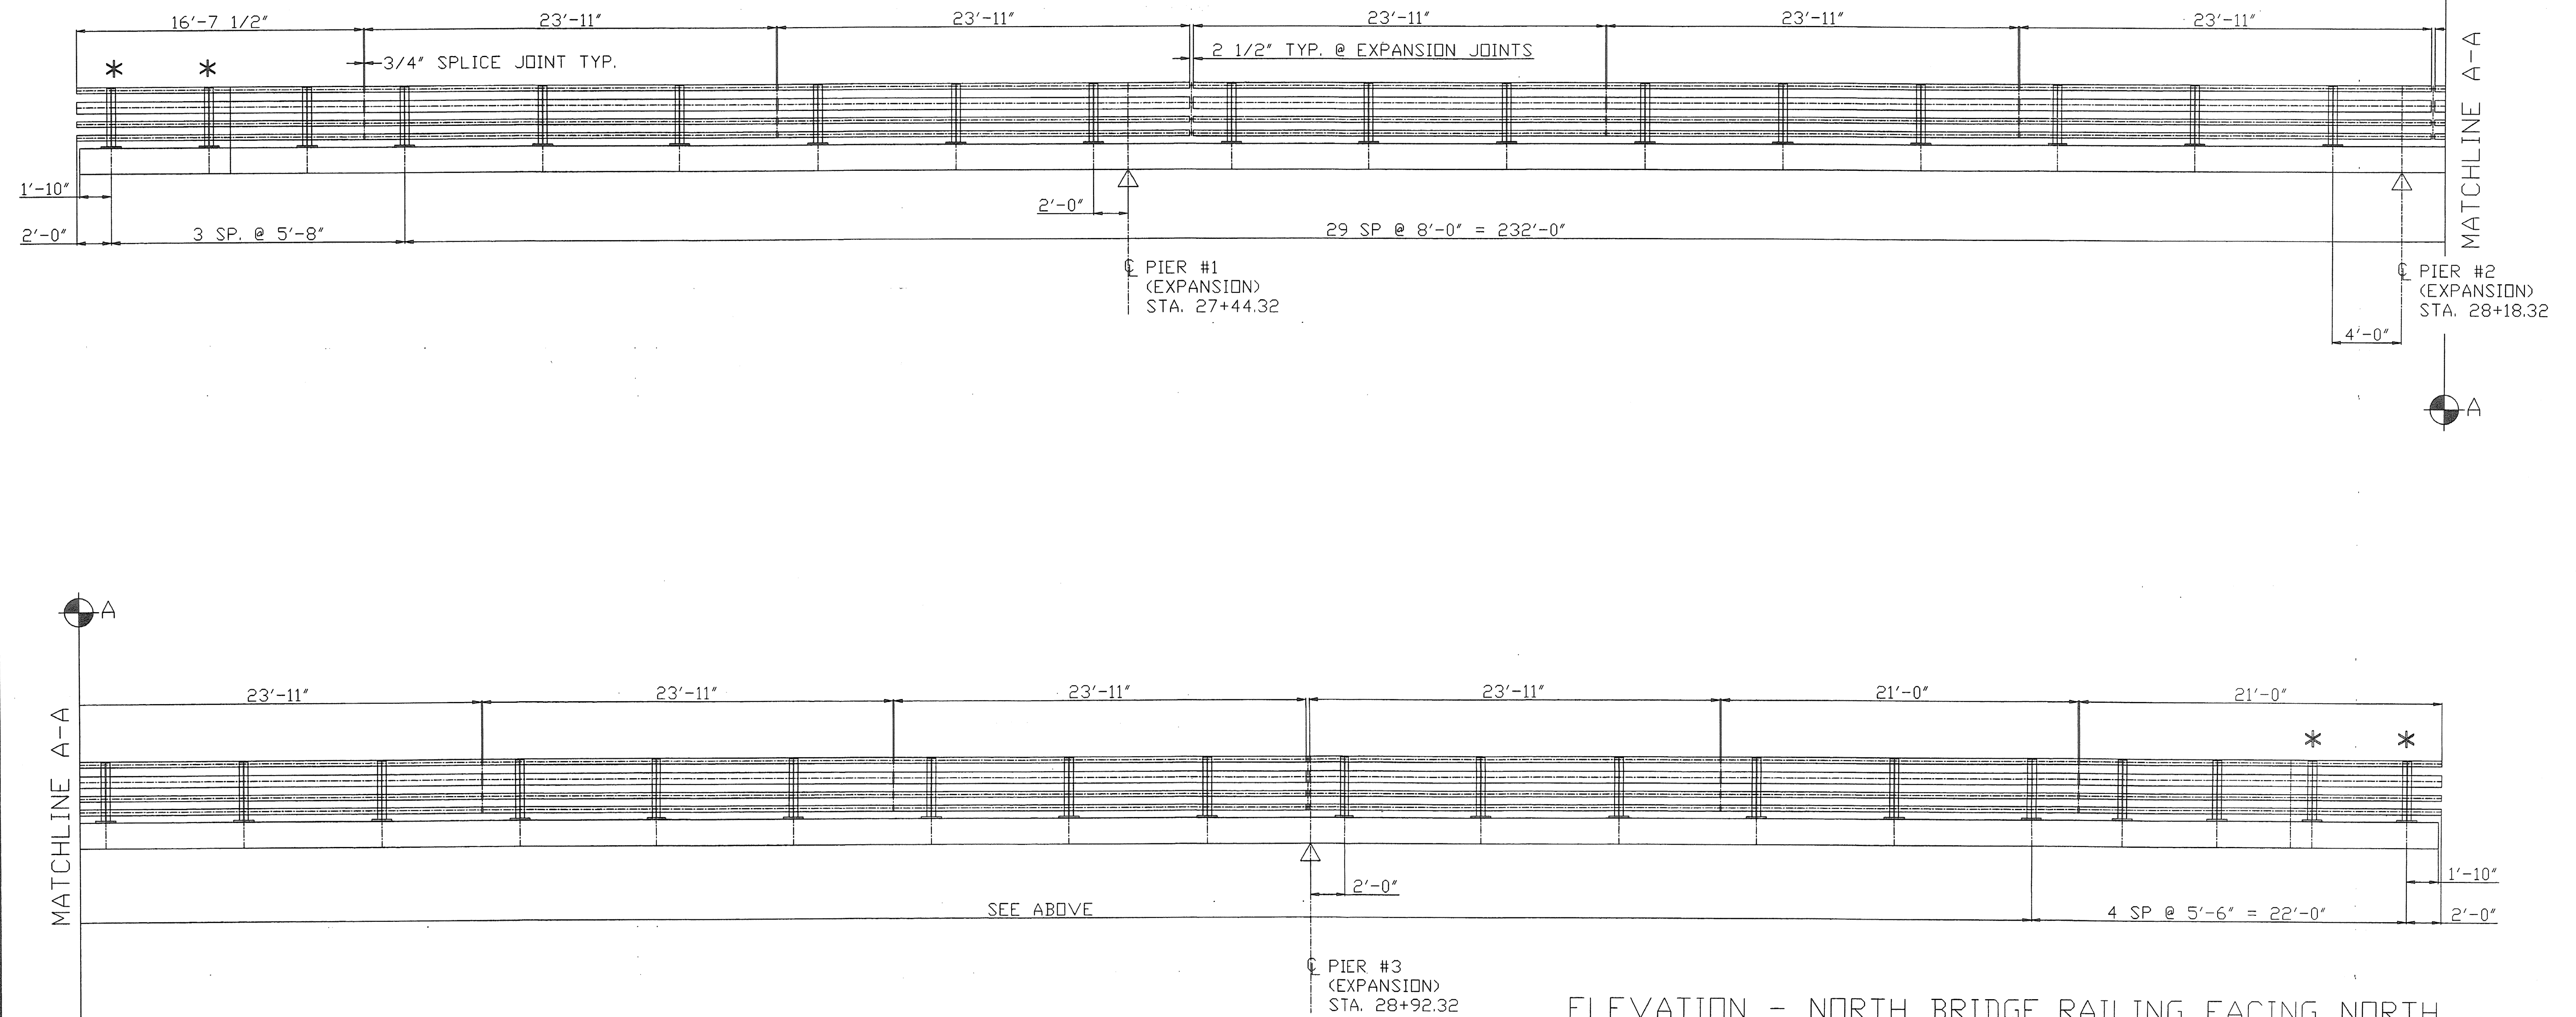

ELEVATION - NORTH BRIDGE RAILING FACING NORTH
SOUTH BRIDGE RAILING SIMILAR
TOTAL PAY LIMIT ITEM 525.34(BRIDGE RAILING - 4 RAIL) = 550 LF

THE BRIDGE RAIL LAYOUT SHOWN IS BASED ON INFORMATION FROM EXISTING PLANS.
 THE CONTRACTOR SHALL VERIFY THE PROPOSED BRIDGE RAIL LAYOUT PRIOR TO THE
 FABRICATION OF BRIDGE RAIL.

REVISIONS		
No.	Remarks	Date
0	Initial submittal	8/7/00
1	misc corrections, field verification	10/6/00

SHOP DRAWING REVIEW

REVIEWED AS REQUIRED BY THE CONSTRUCTION CONTRACT DOCUMENTS AND APPROVED, BUT ONLY FOR CONFORMANCE TO THE DESIGN CONCEPT OF THE WORK, AND SUBJECT TO FURTHER LIMITATIONS AND REQUIREMENTS CONTAINED IN THE CONSTRUCTION CONTRACT DOCUMENTS.

REJECTED REVISE AND RESUBMIT FURNISH AS CORRECTED

CORRECTIONS OR COMMENTS MADE ON THIS SHOP DRAWING SHALL BE THE RESPONSIBILITY OF THE SUBMITTER. THE CONTRACTOR SHALL BE RESPONSIBLE FOR OBTAINING THE NECESSARY APPROVALS FROM THE DESIGNER AND THE OWNER. THE CONTRACTOR SHALL BE RESPONSIBLE FOR OBTAINING THE NECESSARY APPROVALS FROM THE DESIGNER AND THE OWNER. THE CONTRACTOR SHALL BE RESPONSIBLE FOR OBTAINING THE NECESSARY APPROVALS FROM THE DESIGNER AND THE OWNER.

VHB Versarose Hagan Brunell, Inc.
 Engineers, Planners and Surveyors
 Six Basking Farms, Kilmuckee Rd.
 Berlin, NH 03570 603-244-0888

Job Number: 50929
 Reviewed By: ASB
 Date: 1-19-01

HIGHWAY SAFETY CORP.
 GLASTONBURY, CT

ITEM 525.34 - BRIDGE RAILING - NETC 4 RAIL

CITY OF SOUTH BURINGTON
 US ROUTE 20VER I-89 @ EXIT 14
 IM DECK(36) BRIDGE #68

GENERAL CONTRACTOR
 SUB CONTRACTOR F.R. LAFAYETTE, INC.

DRAWN P. VUKAS
 CHECKED *[Signature]*
 DATE 07-23-00
 SCALE NONE
 HSC REFERENCE NO. 1213
 SIZE D REVISION 1
 SHEET NO. 1 of 2