


STATE OF VERMONT
AGENCY OF TRANSPORTATION



PROPOSED IMPROVEMENT

CITY OF SOUTH BURLINGTON
COUNTY OF CHITTENDEN

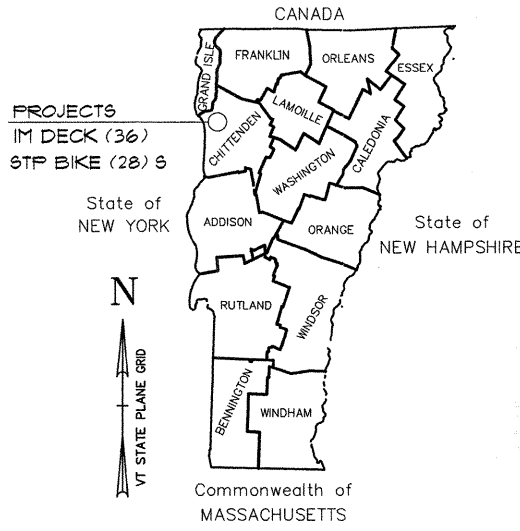

LOCATION MAP

IM DECK (36)

ROUTE NO. : 1-89

PROJECT LOCATION:

PROJECT DESCRIPTION:

LENGTH OF STRUCTURE:

LENGTH OF PROJECT:

BRIDGE NO. : 68

U.S. 2 (WILLISTON RD.) OVER 1-89

INSTALL TRAFFIC CONTROL, REHABILITATE

STRUCTURE, REMOVE TRAFFIC CONTROL

261.00'

1723.00'

STP BIKE (28) S

PROJECT LOCATION:

PROJECT DESCRIPTION:


LENGTH OF PROJECT:

U.S. 2 (WILLISTON RD.) OVER 1-89

CONSTRUCT SIDEWALK AND BIKEWAY ALONG

U.S. 2 BETWEEN STA. 21400 AND 36461


1561.00'

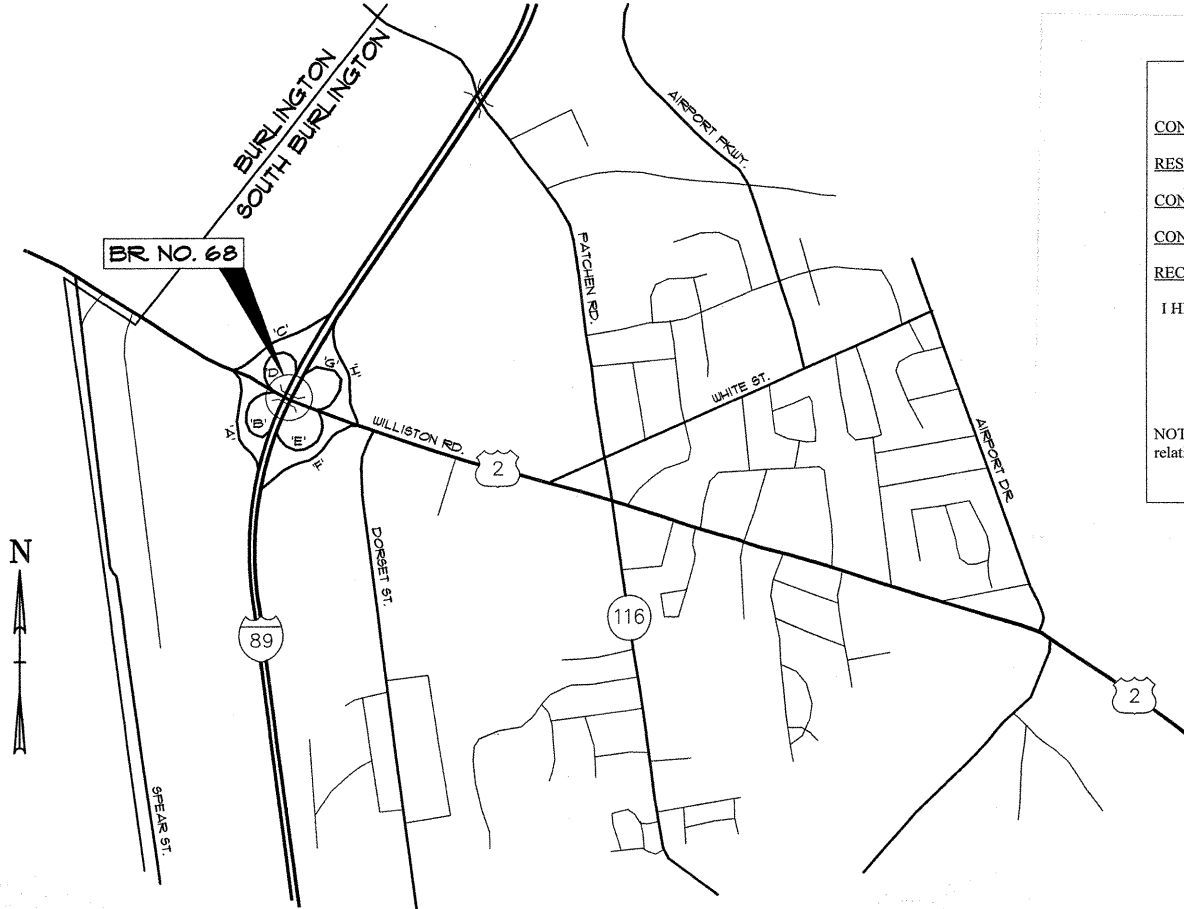

RECORD PLANS

CONTRACTOR:	J.A. McDONALD - LYNDON CTR. VT.
RESIDENT ENGINEER:	ROBERT SUCKERT
CONSTRUCTION BEGAN:	JUNE 12, 2009
CONSTRUCTION COMPLETE:	APRIL 23, 2014
RECORD PLANS BY:	R. SUCKERT, D. HOSKING & N. GARRACIE
I HEREBY CERTIFY THAT ALL THE CONSTRUCTION REQUIRED BY THIS SET OF DRAWINGS HAS BEEN ACCOMPLISHED AS INDICATED HEREIN.	
BY:	RESIDENT ENGINEER
DATE:	6-2-09

NOTE: Any further information concerning final quantities, amounts or other details relative to this project may be found at Central File in the electronic archives.

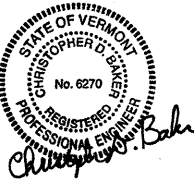

THESE PLANS ARE SUBJECT TO SUCH ENGINEERING CHANGES AS MAY BE REQUIRED BY THE FEDERAL HIGHWAY ADMINISTRATION OR THE CHIEF ENGINEER. CONSTRUCTION IS TO BE CARRIED ON IN ACCORDANCE WITH THESE PLANS AND THE STANDARD SPECIFICATIONS FOR CONSTRUCTION DATED 1990, AS APPROVED BY THE FEDERAL HIGHWAY ADMINISTRATION ON MARCH 15, 1990 FOR USE ON THIS PROJECT, INCLUDING ALL SUBSEQUENT REVISIONS AND SUCH REVISED SPECIFICATIONS AND SPECIAL PROVISIONS AS ARE INCORPORATED IN THESE PLANS.

APPROVED: DATE: 3/1/14

DIRECTOR OF PROJECT DEVELOPMENT

DEPARTMENT OF TRANSPORTATION

FEDERAL HIGHWAY ADMINISTRATION

APPROVED: DATE: 3/1/14

DIVISION ADMINISTRATOR

PROJECT: SOUTH BURLINGTON IM DECK(36)

SOUTH BURLINGTON STP BIKE (28)S

SHEET 1 OF 75 SHEETS

CONVENTIONAL SIGNS	
COUNTY LINE	---
TOWN LINE	---
LIMITS OF ACCESS	---
POINT OF ACCESS	X
FENCE LINE	---
STONE WALL	---
TRAVELED WAY	---
GUARD RAIL	---
RAILROAD	---
SURVEY LINE	---
OVERLY	---
POWER POLE	---
TELEPHONE POLE	---
TREES	---
CONTROL OF ACCESS	---
PROPERTY LINE	---
R.O.W. TAKING LINE	---
SLOPE RIGHTS	---
TOP OF CUT	---
TOE OF SLOPE	---

DATUM: N/A

HORIZONTAL: N/A

VANASSE HANGEN BRUSTLIN, INC.