



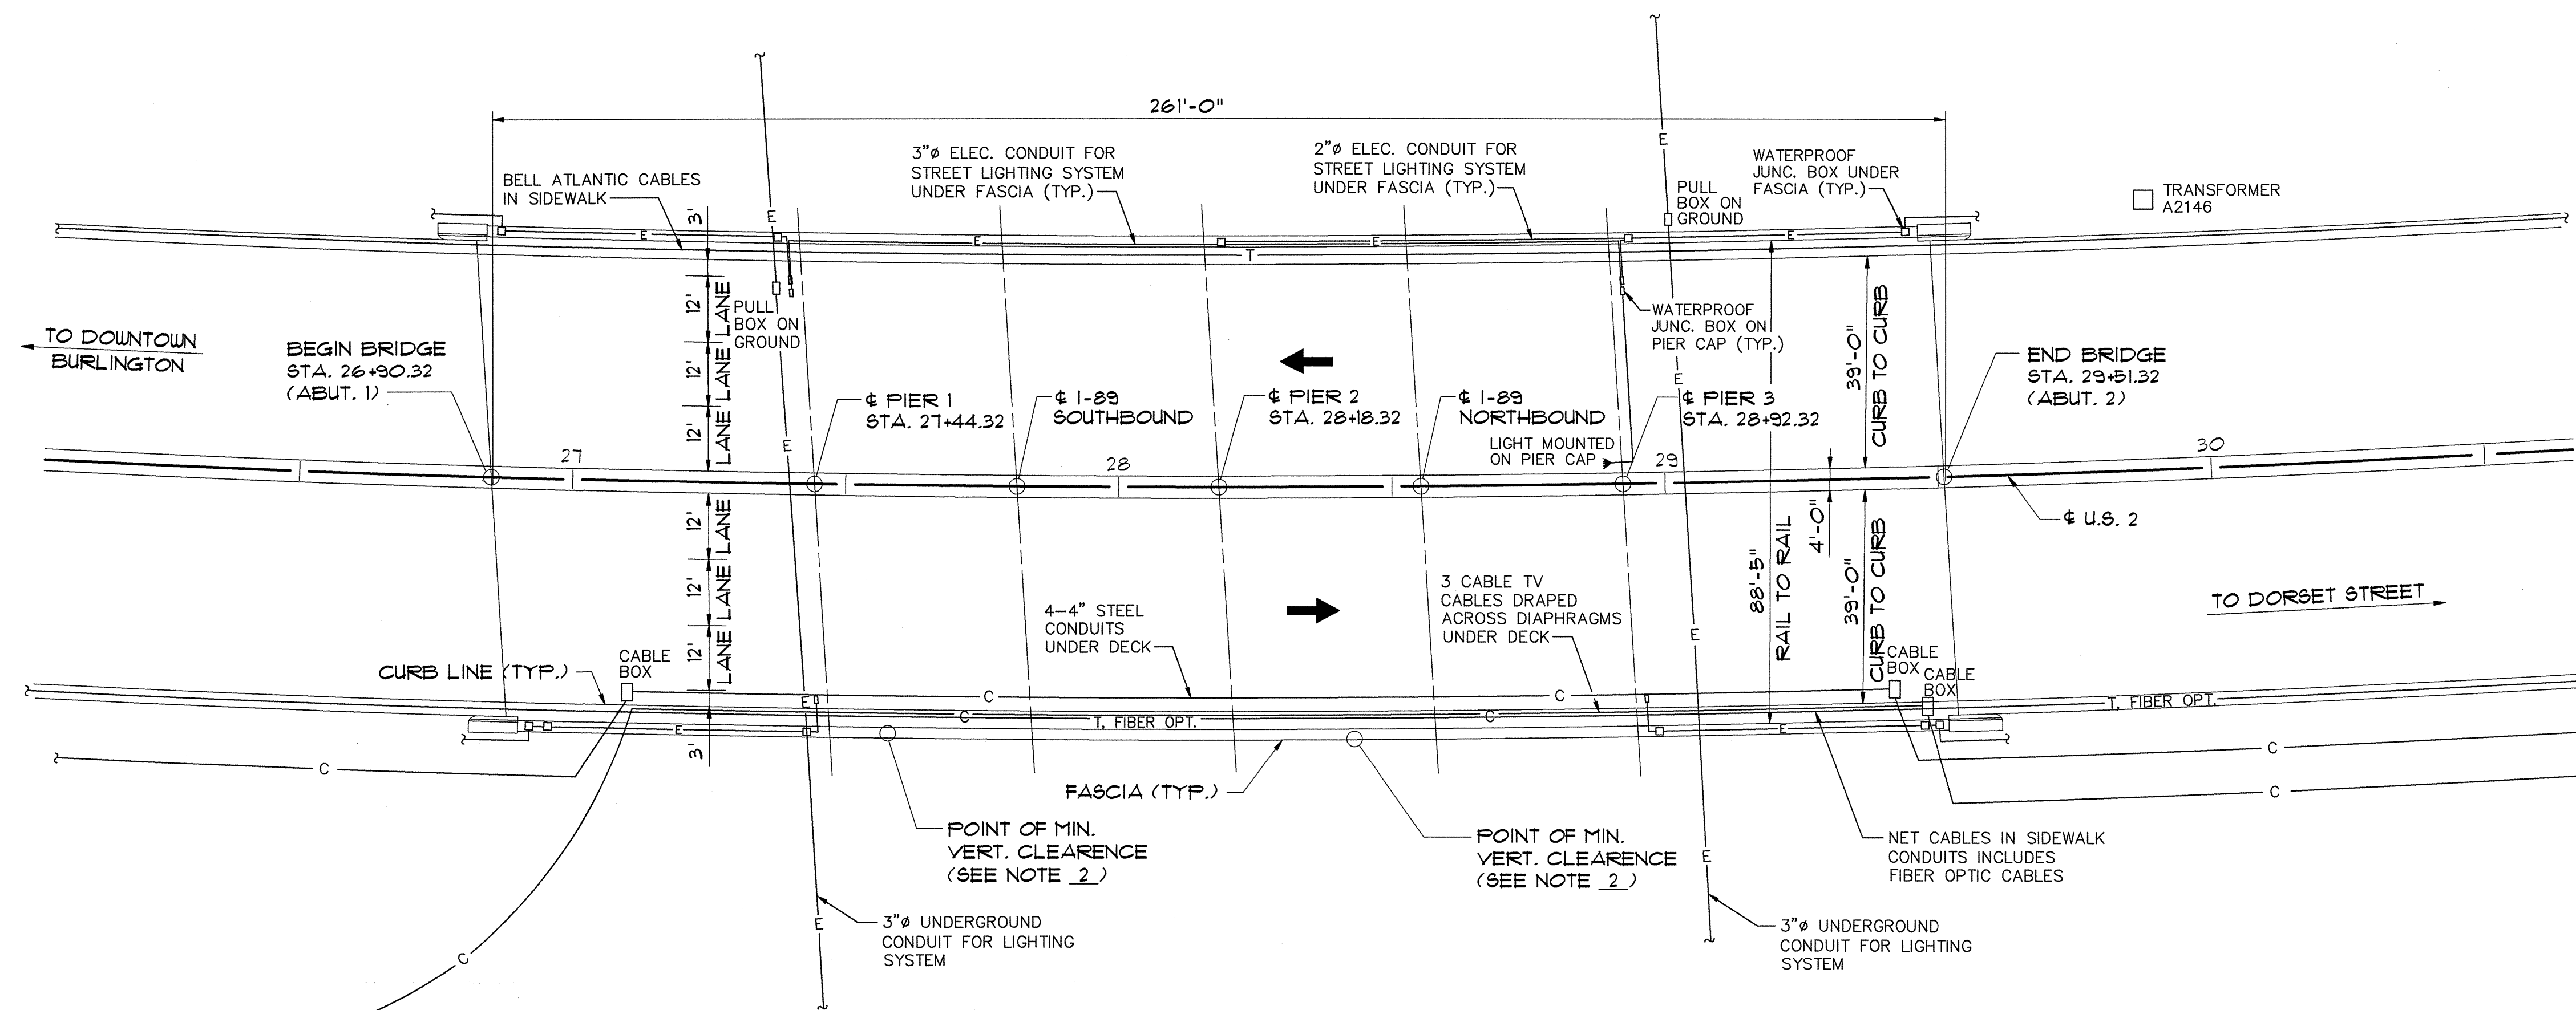

EXISTING PLAN

SCALE: 1"=20'

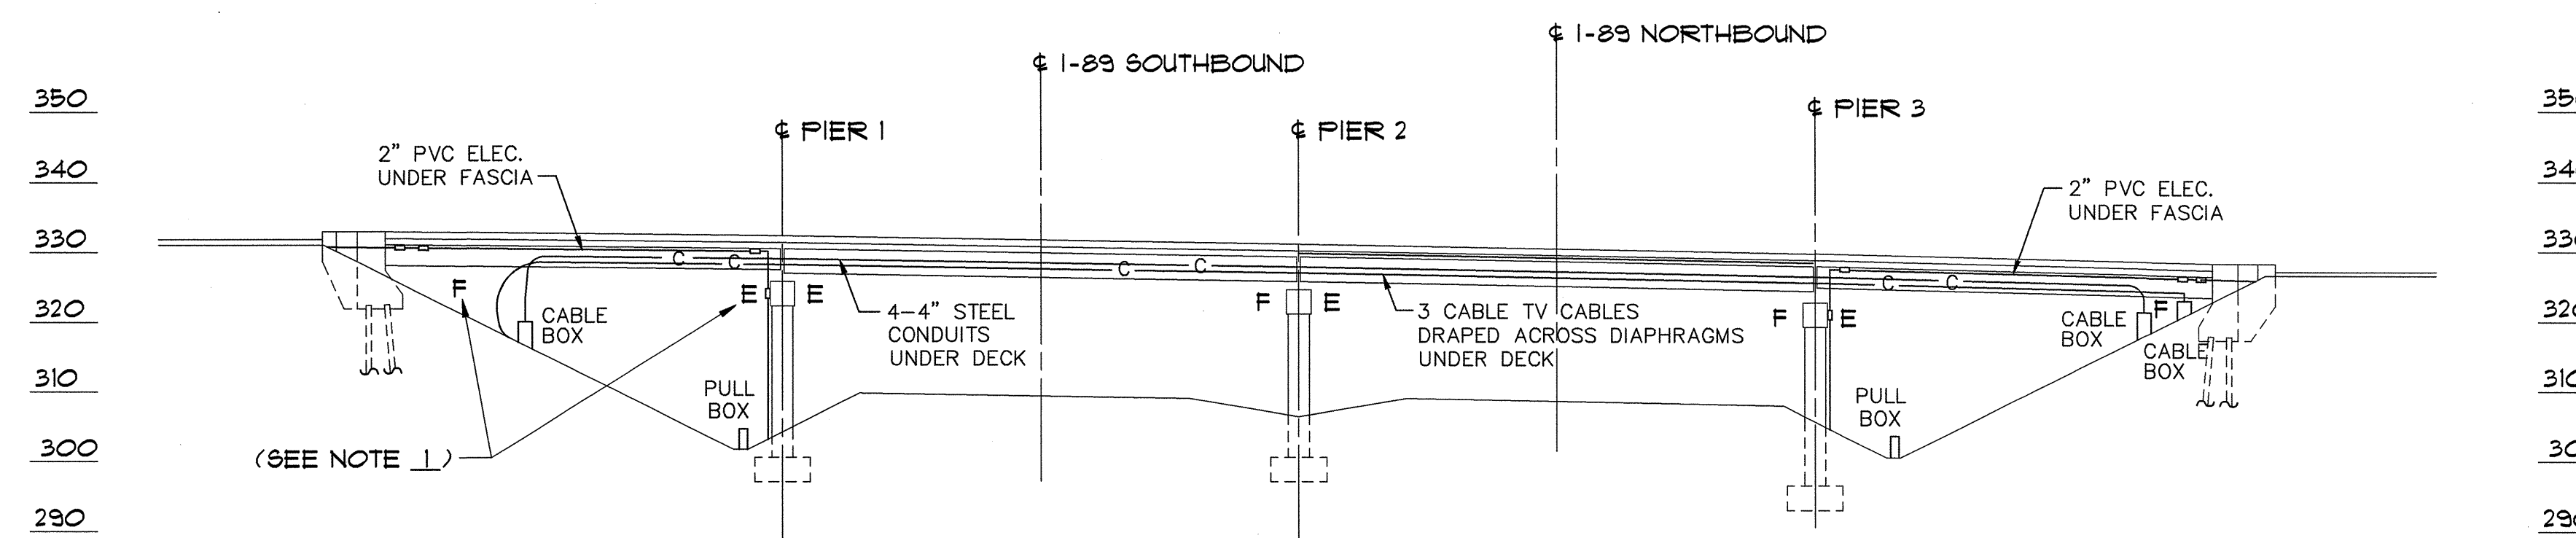

ELEVATION

SCALE: 1"=20'

NOTES:

1. ABUTMENT 1 CHANGED FROM EXPANSION TO FIXED. PIER 1 CHANGED FROM FIXED TO EXPANSION.
2. THE MINIMUM VERTICAL CLEARANCE IN THE PROPOSED CONDITION WILL BE THE SAME AS THE EXISTING.

STATE OF VERMONT AGENCY OF TRANSPORTATION

Town Of	SOUTH BURLINGTON	Bridge No. 68
Highway No.	U.S. 2	Log Sta.
		Surv. Sta.

U.S. 2 OVER I-89

EXISTING PLAN & ELEVATION

Designed By	T.S. BRYANT	Drawn By	B.J. MASSE
Checked By	A. SETAS	Date	1/00
		Bridge Design Supervisor	C.D. BAKER Date 1/00

PROJECT	SOUTH BURLINGTON	PROJECT NO.	IM DECK (36)
VHB Cad Drawing No.	50929FE	Date	1/00
Bridge Sheet No.		Sheet	6A of 75

VANASSE HANGEN BRUSTLIN, INC.