
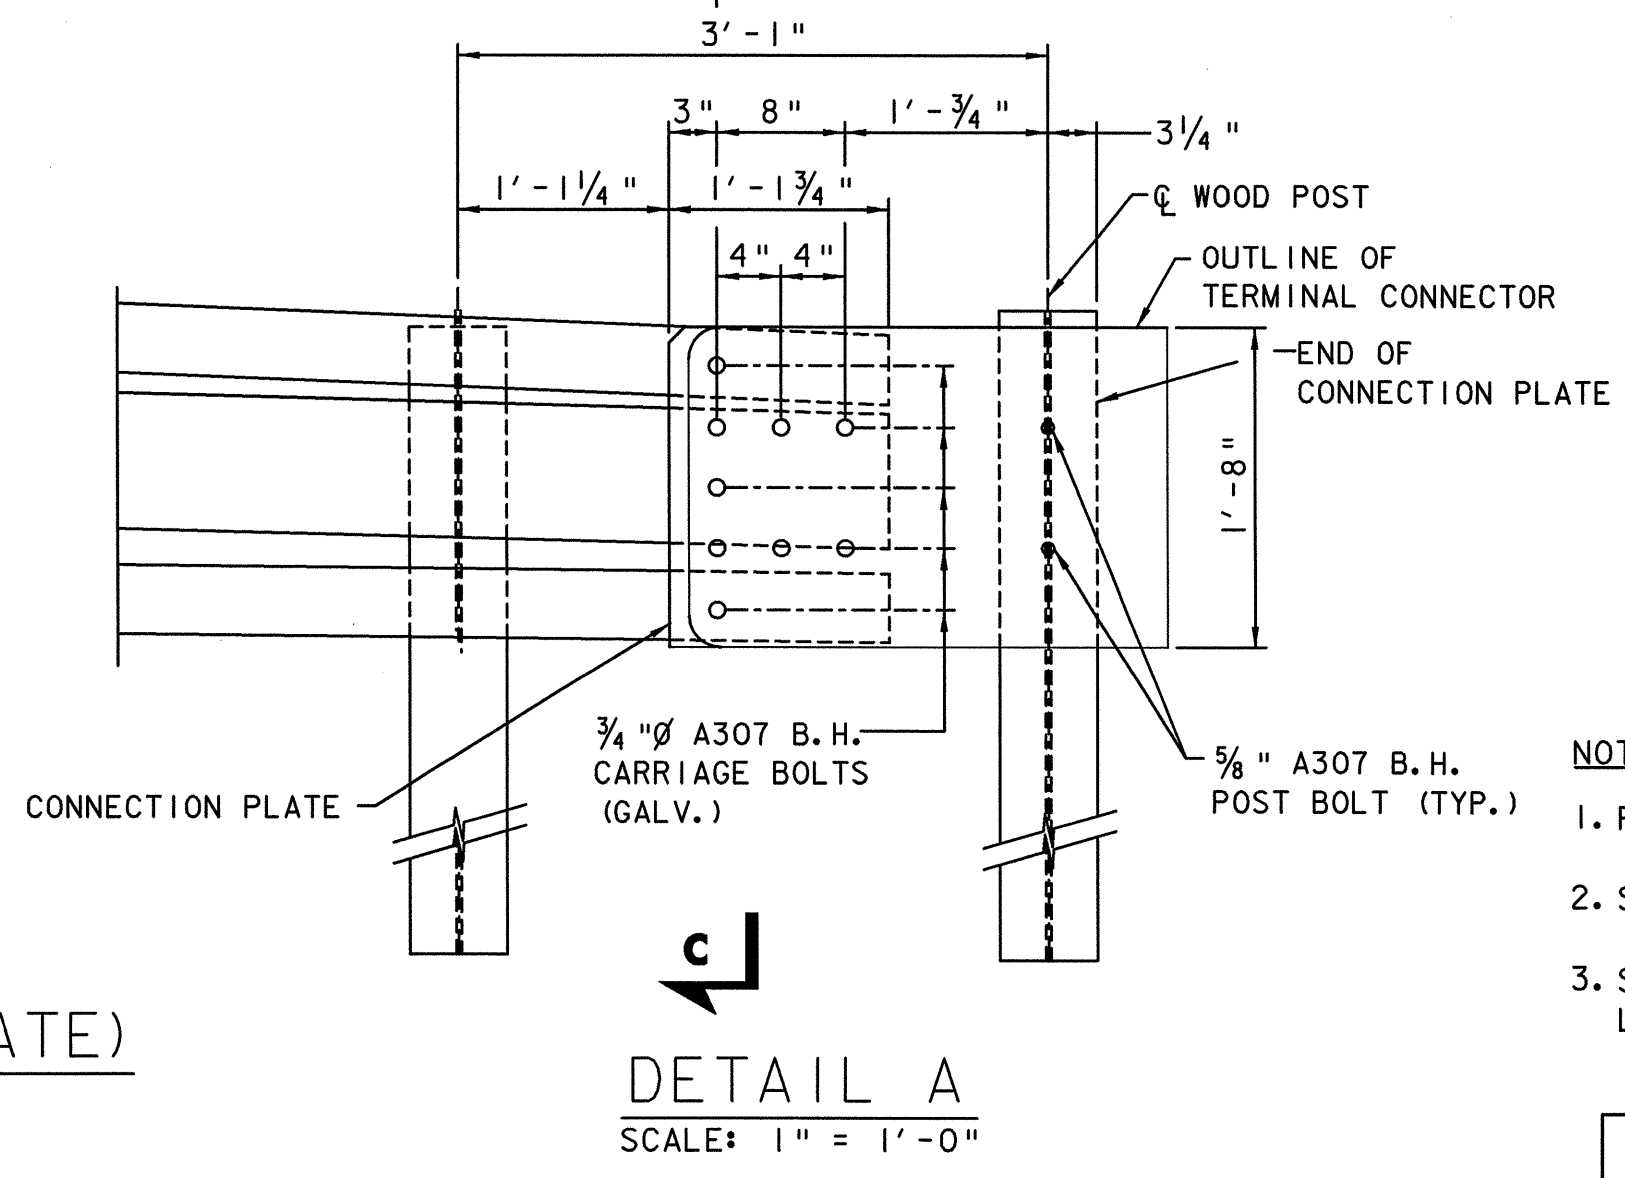
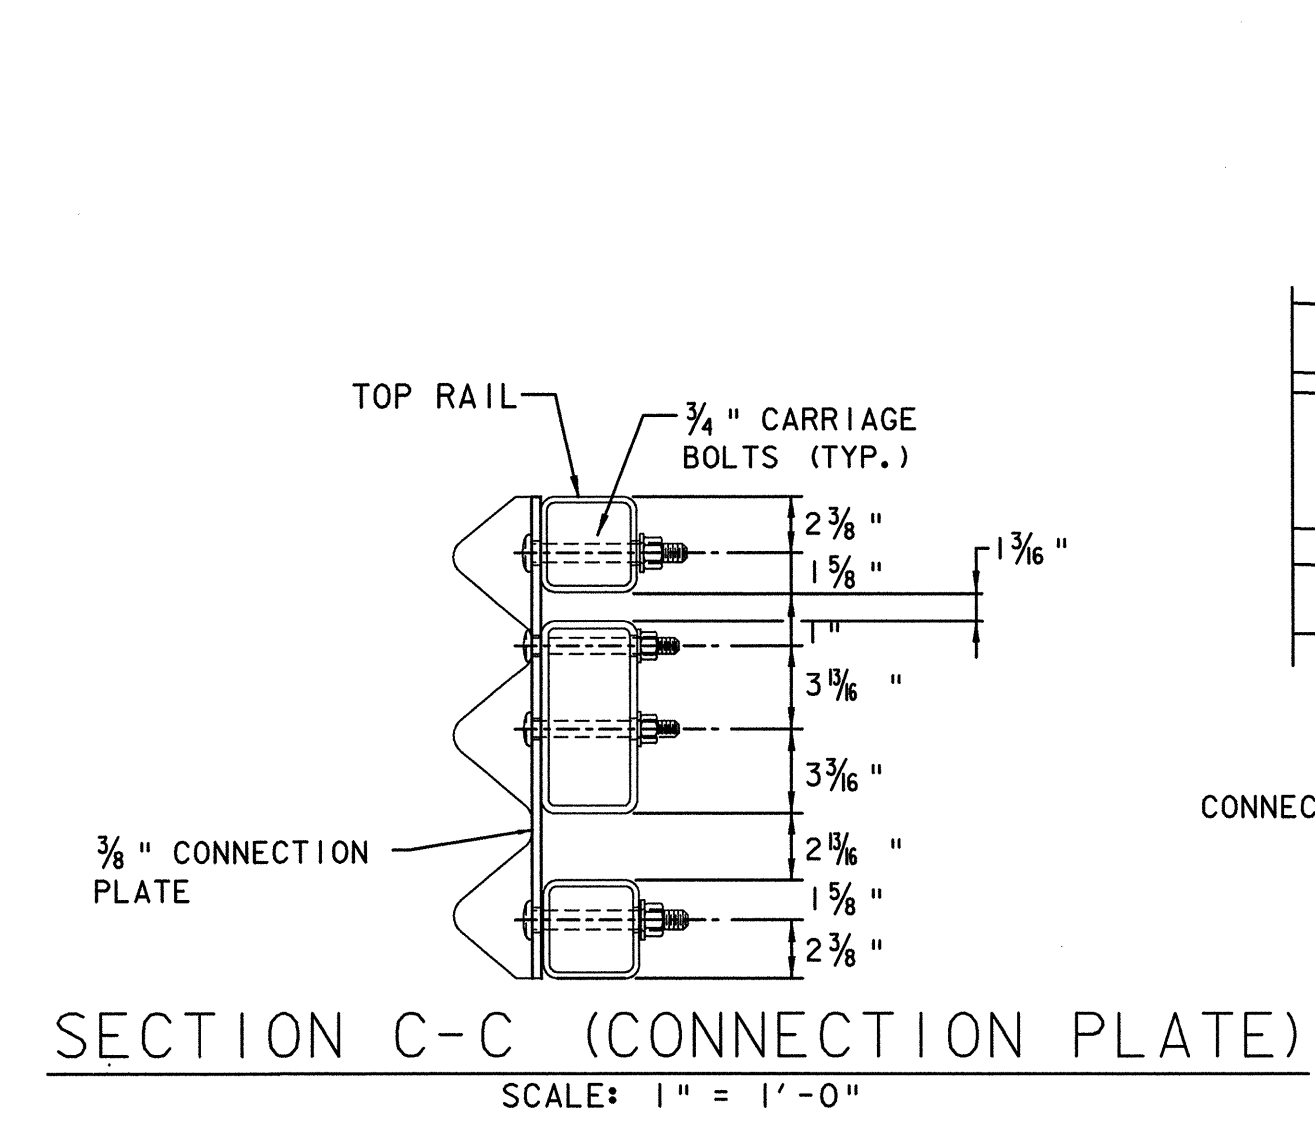
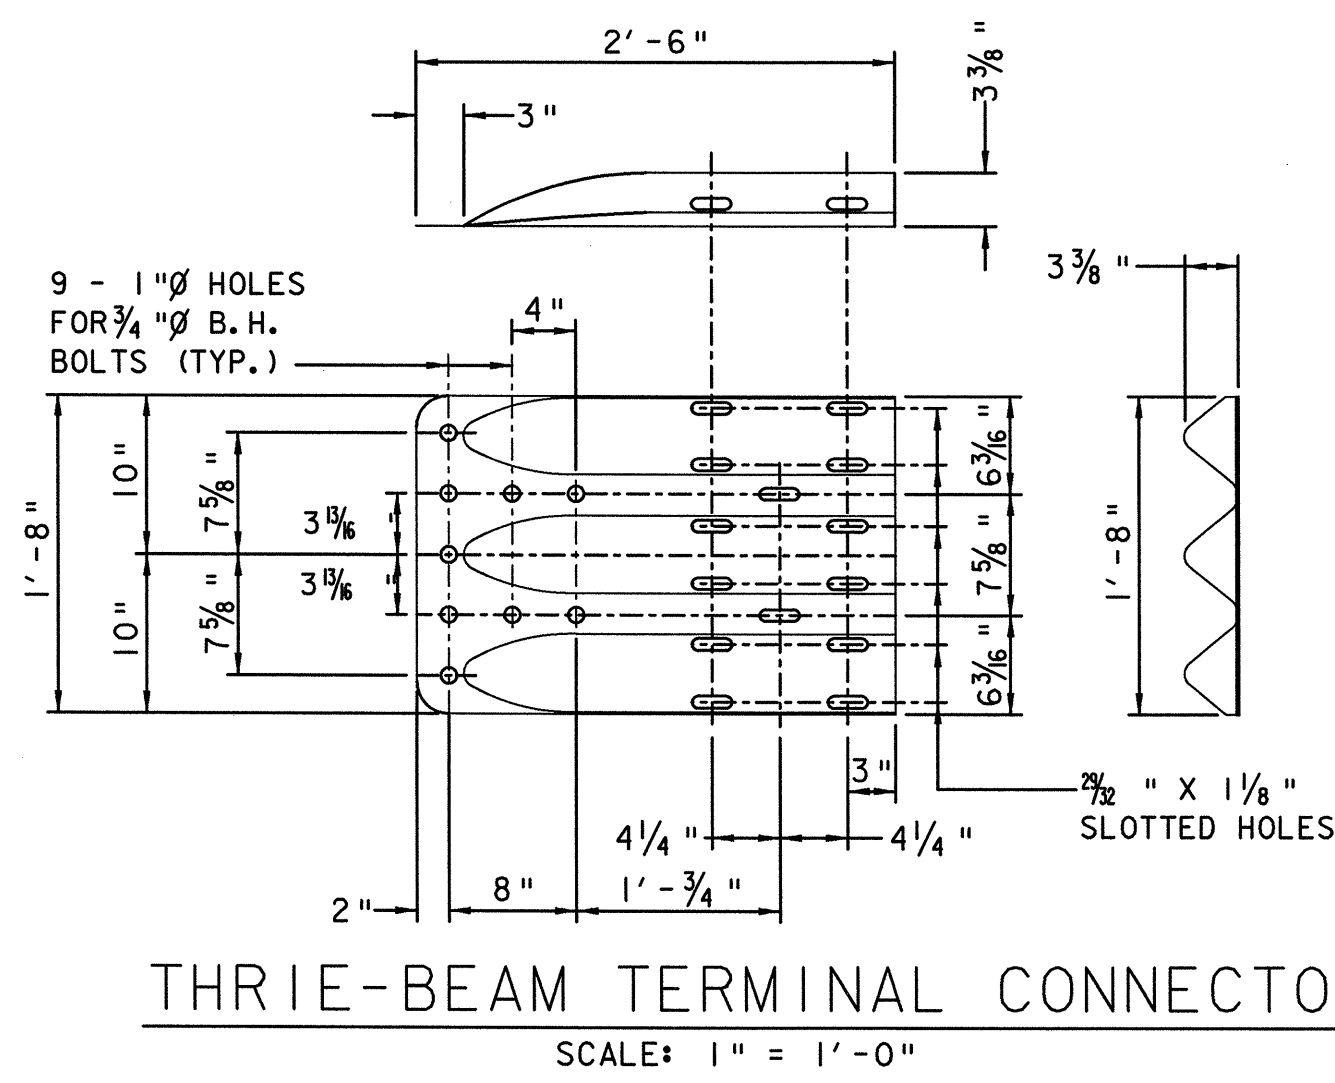
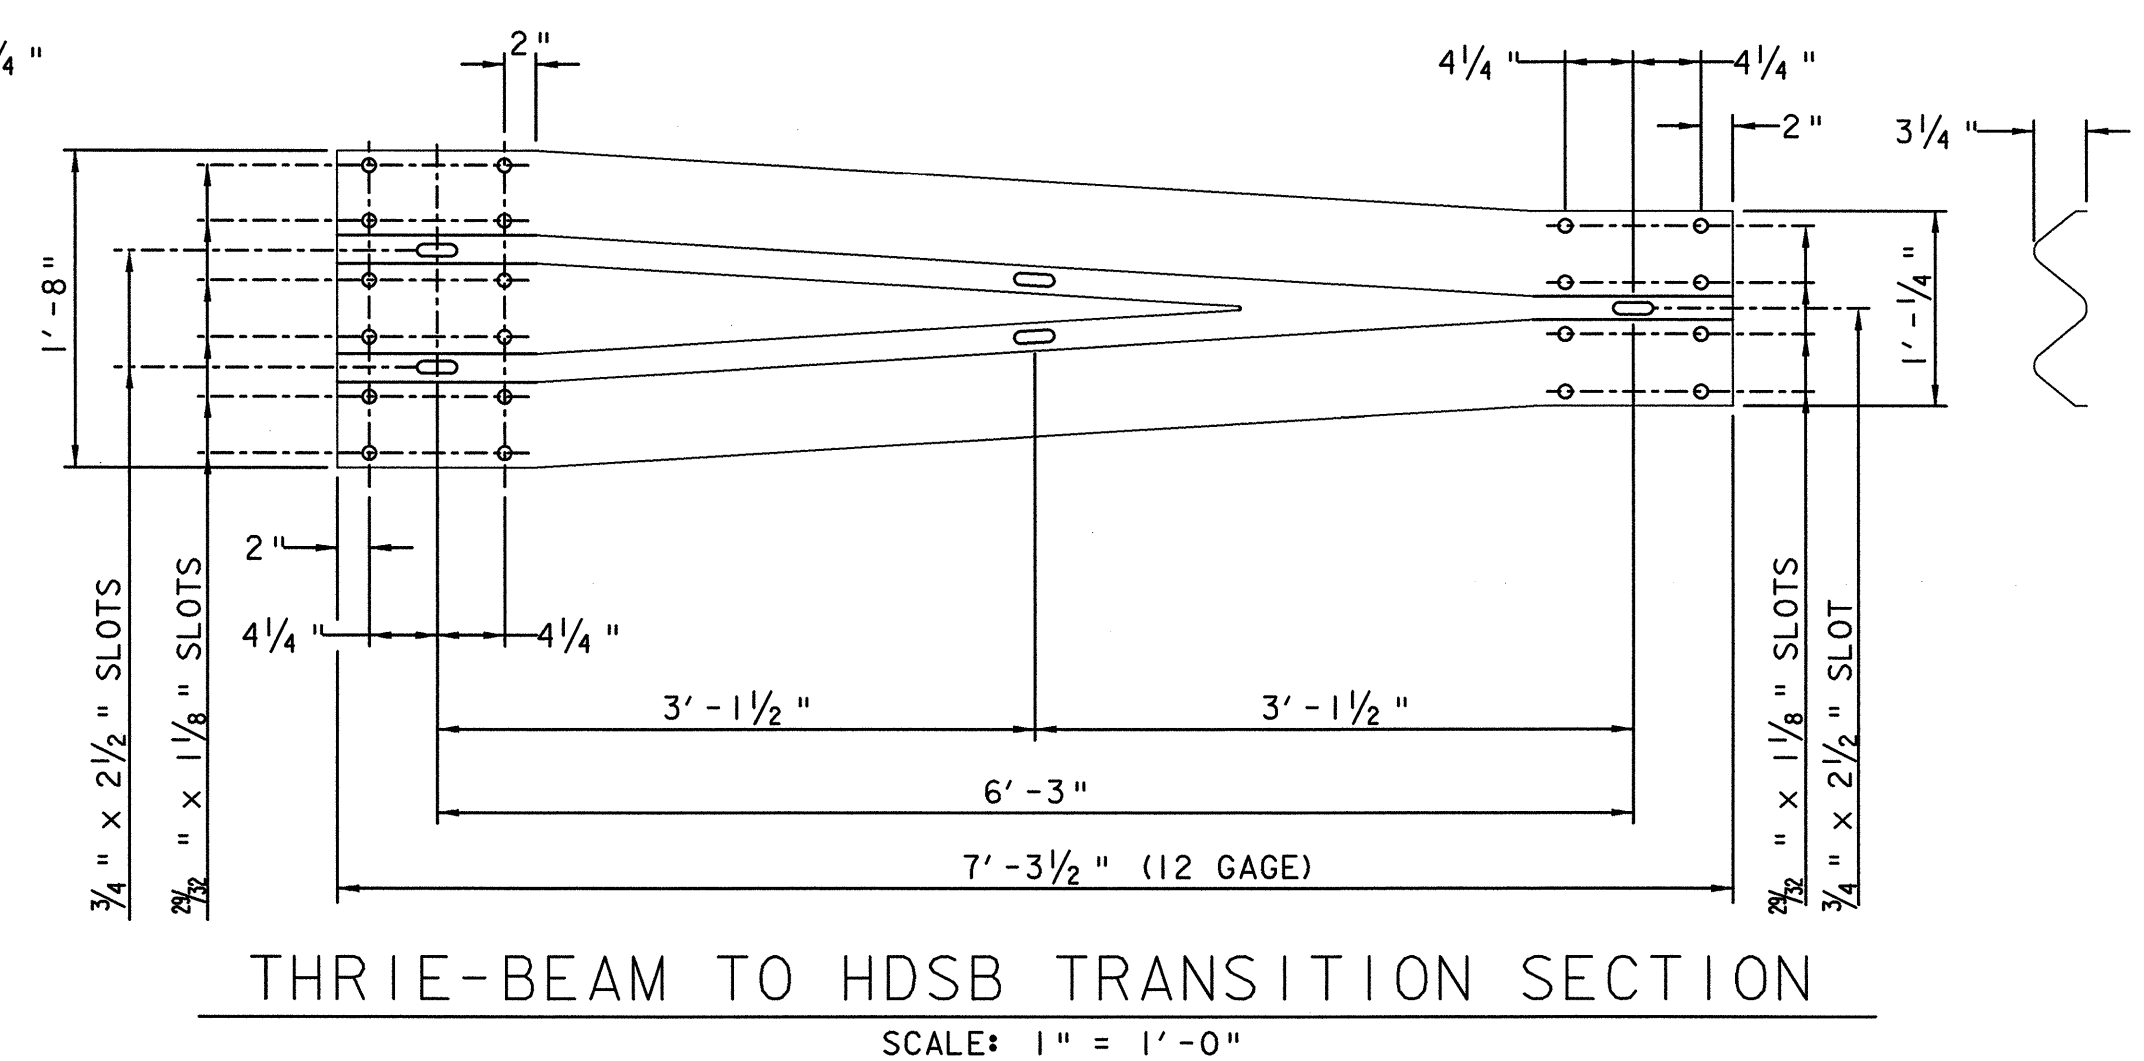
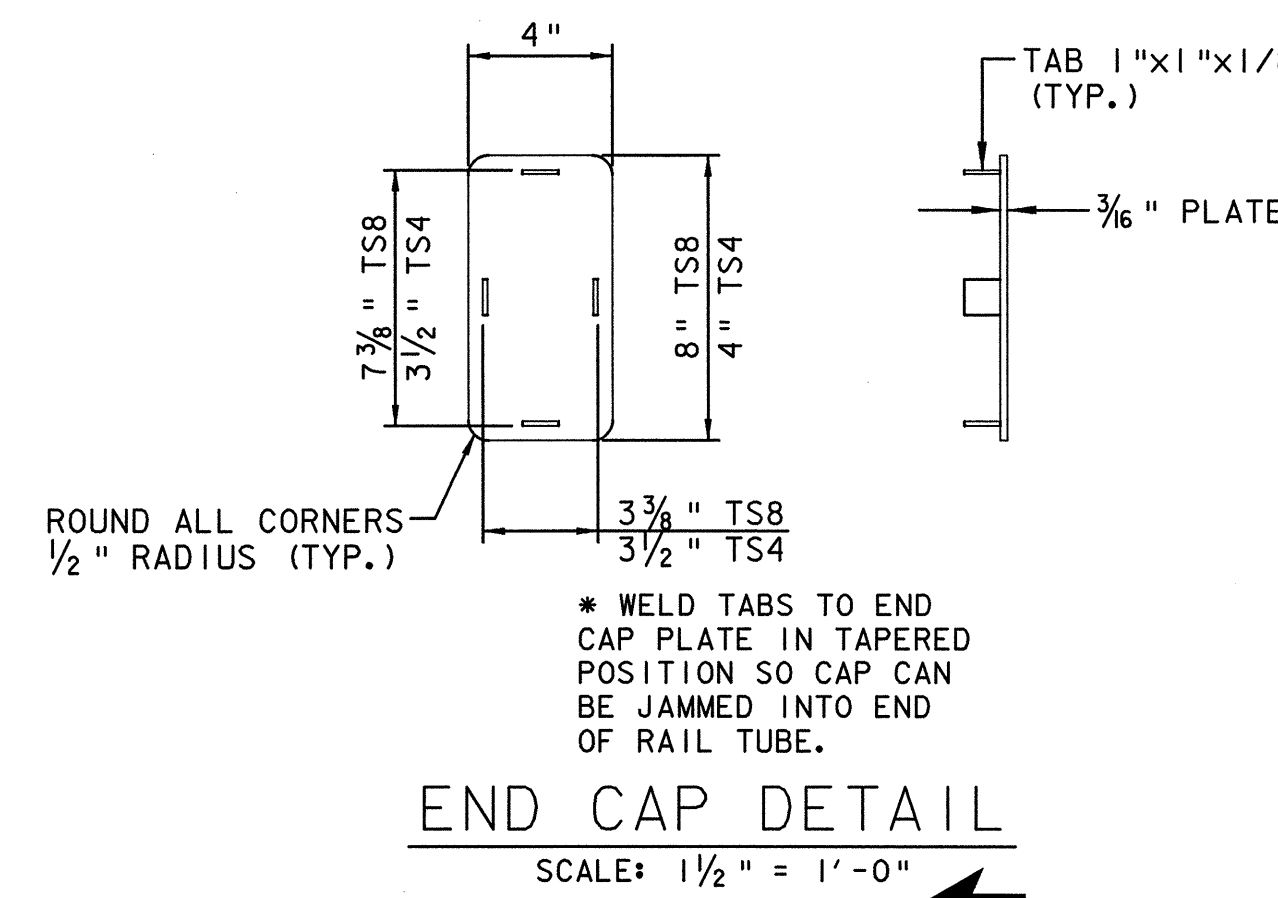
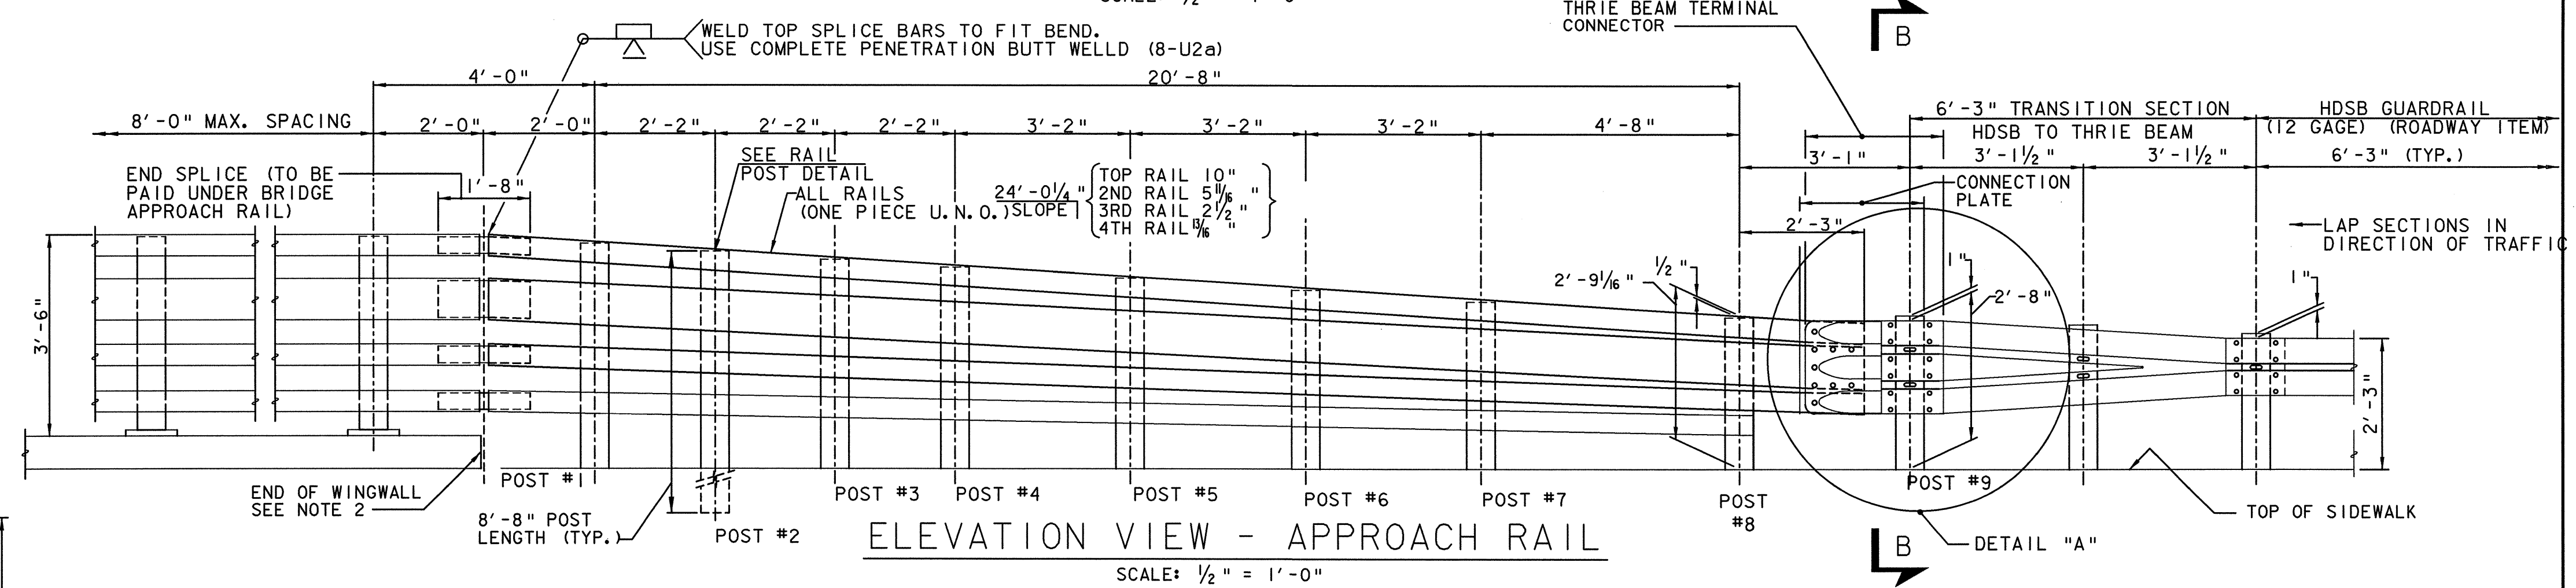
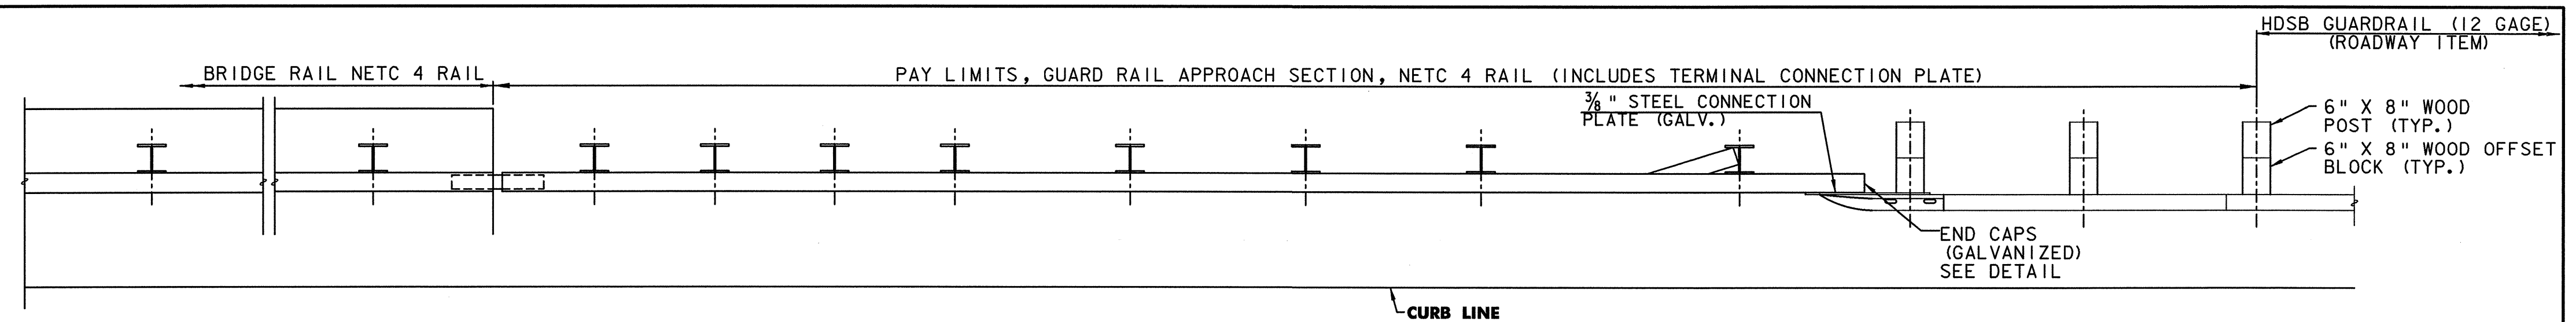
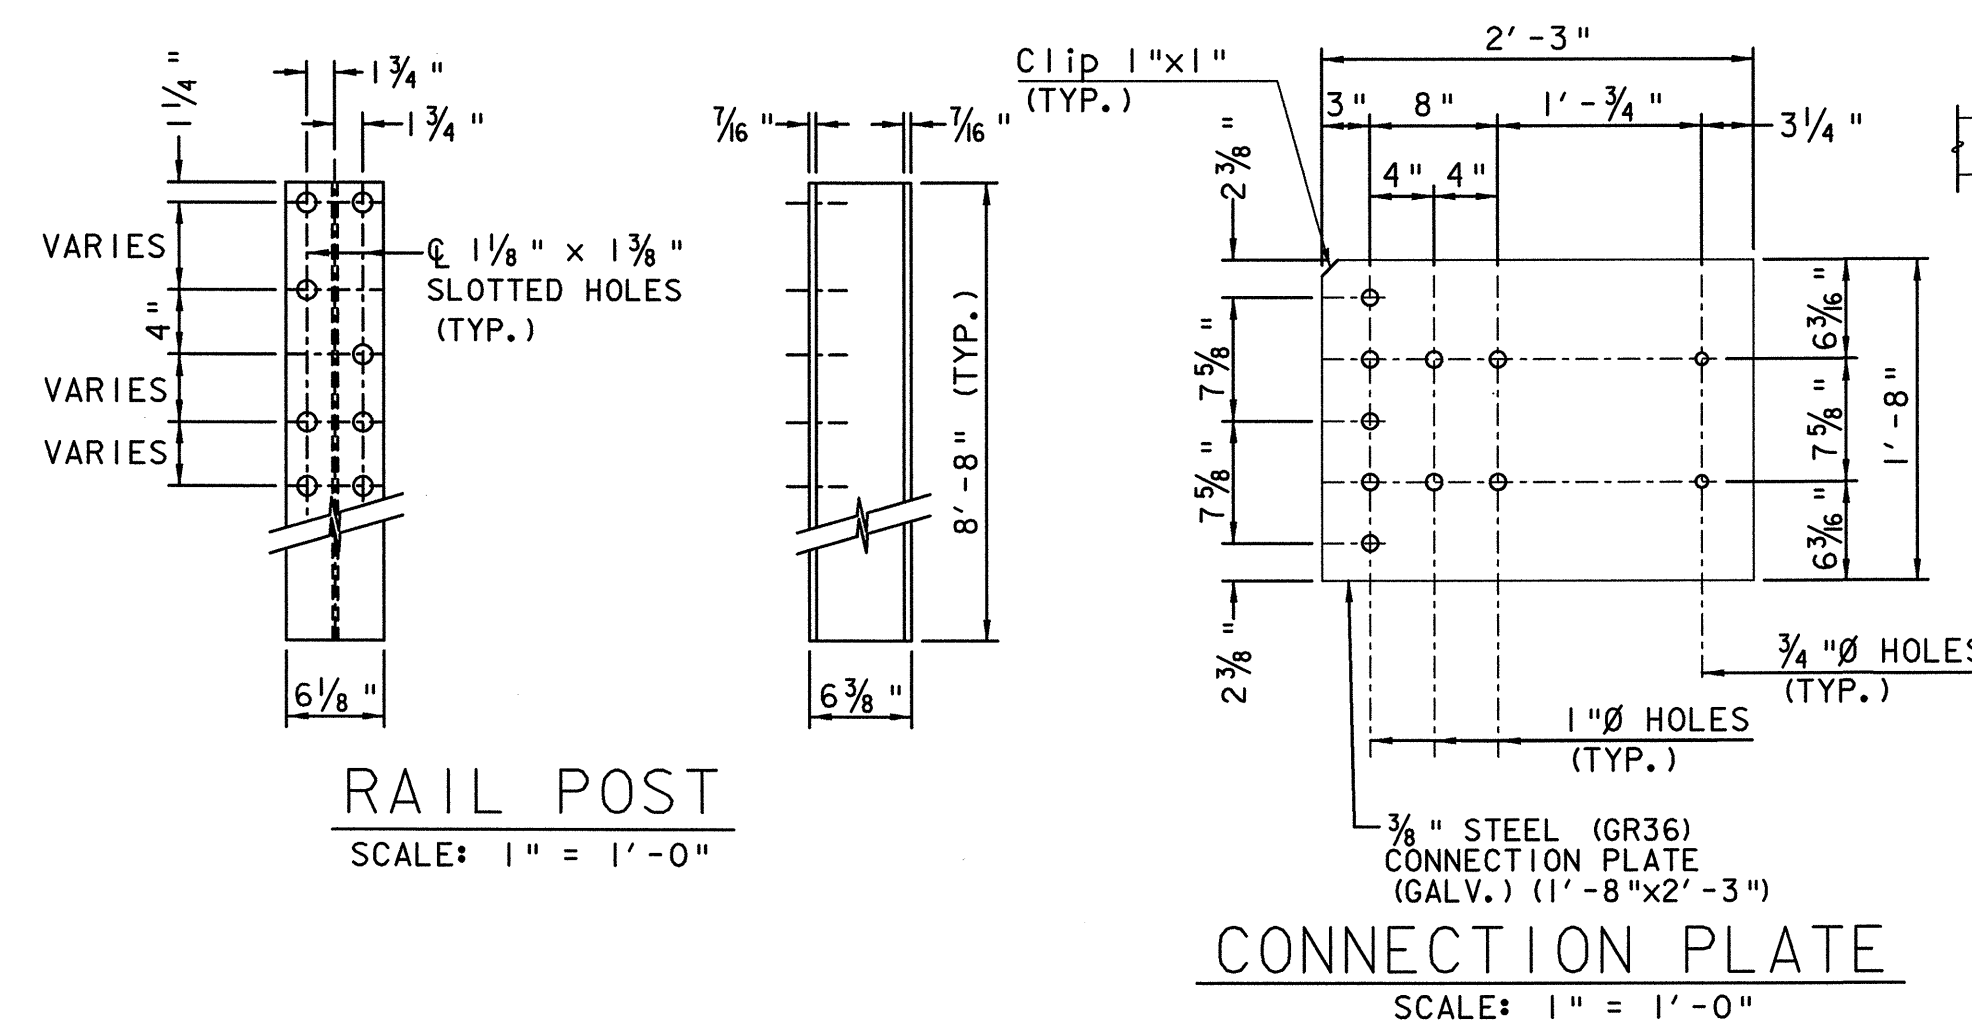


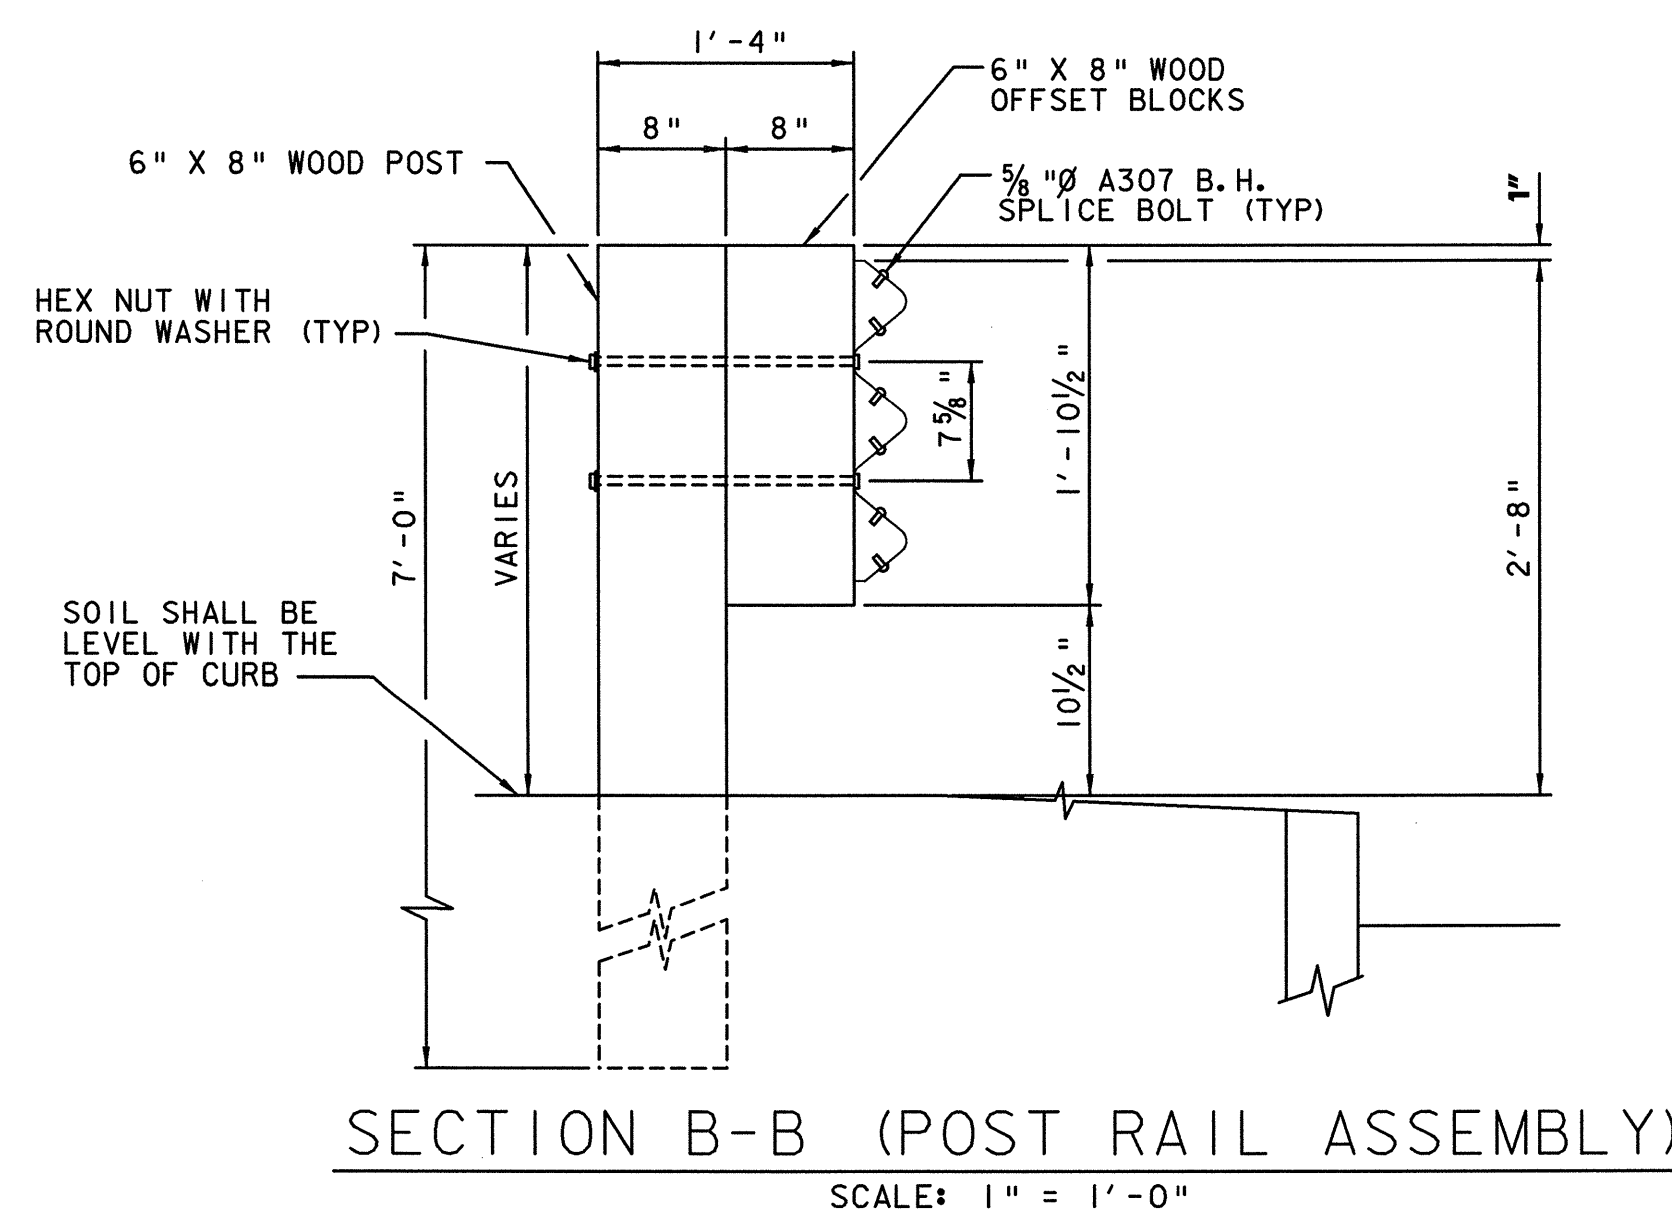

- NOTES:**
1. FOR NOTES SEE SHEET 24.
 2. SEE EXISTING PLANS FOR LOCATION OF WINGWALL.
 3. SEE SHEET 26 FOR BRIDGE AND APPROACH RAIL LAYOUT.

STATE OF VERMONT AGENCY OF TRANSPORTATION	
Town Of SOUTH BURLINGTON	Bridge No. 68 Log Sta.
Highway No. U.S. 2	Surv. Sta.
U.S. 2 OVER I-89	
GUARD RAIL APPROACH SECTION, N.E.T.C. 4 RAIL	
Designed By VAOT	Drawn By C. L. CILLEY
Checked By VAOT	Date 1/00
Bridge Design Supervisor	
Project SOUTH BURLINGTON	Date IM DECK (36)
VHB Cod Drawing No. BR-122	Date 1/00
Bridge Sheet No.	Sheet 25 of 75