



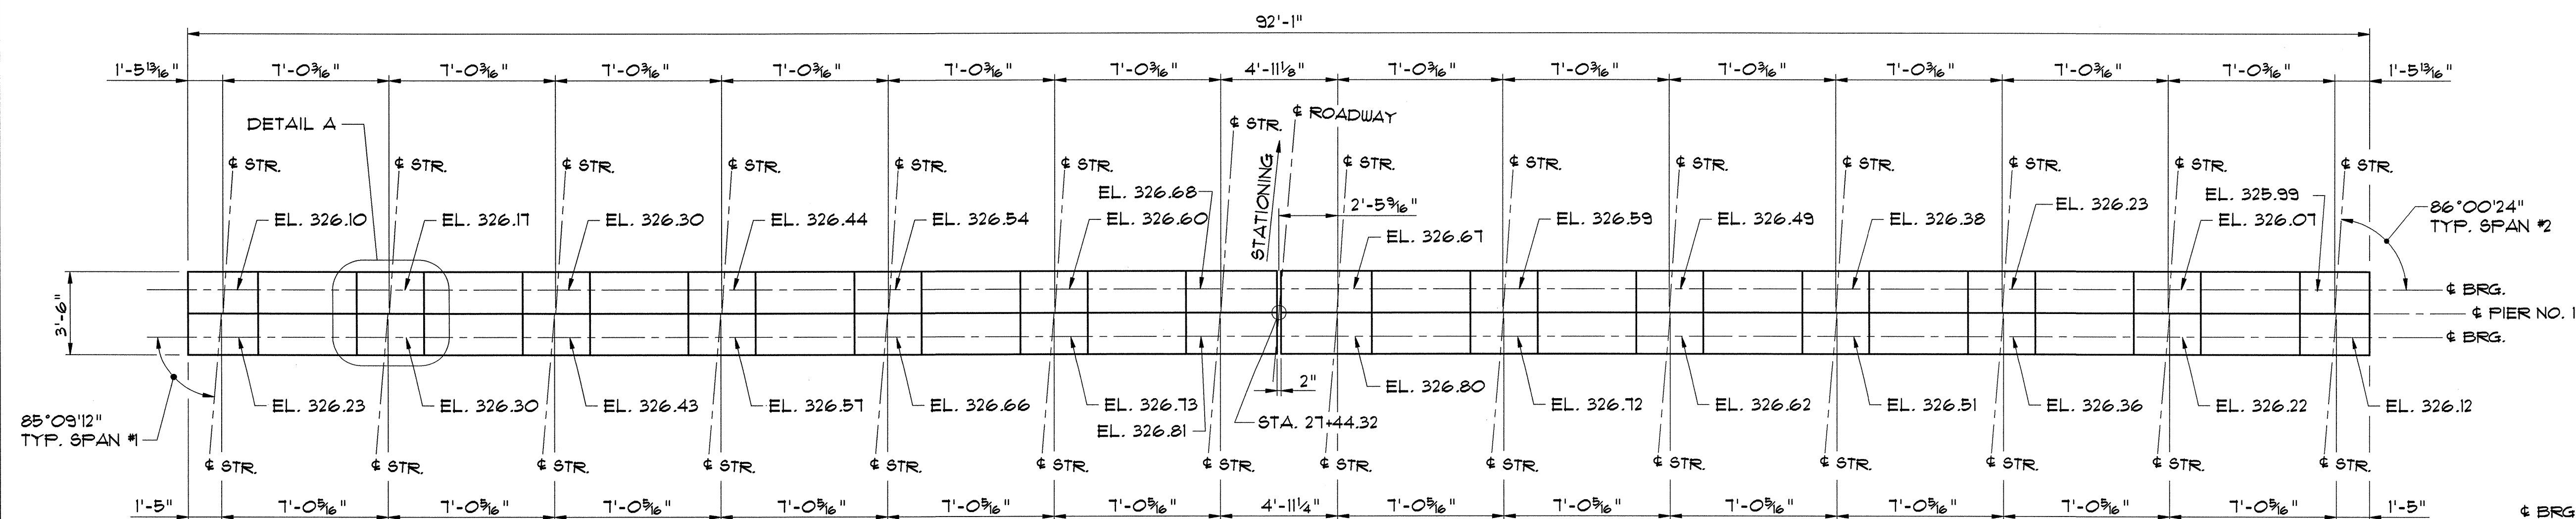


PIER NO. 1 CAP PLAN

SCALE: 1/4" = 1'-0"

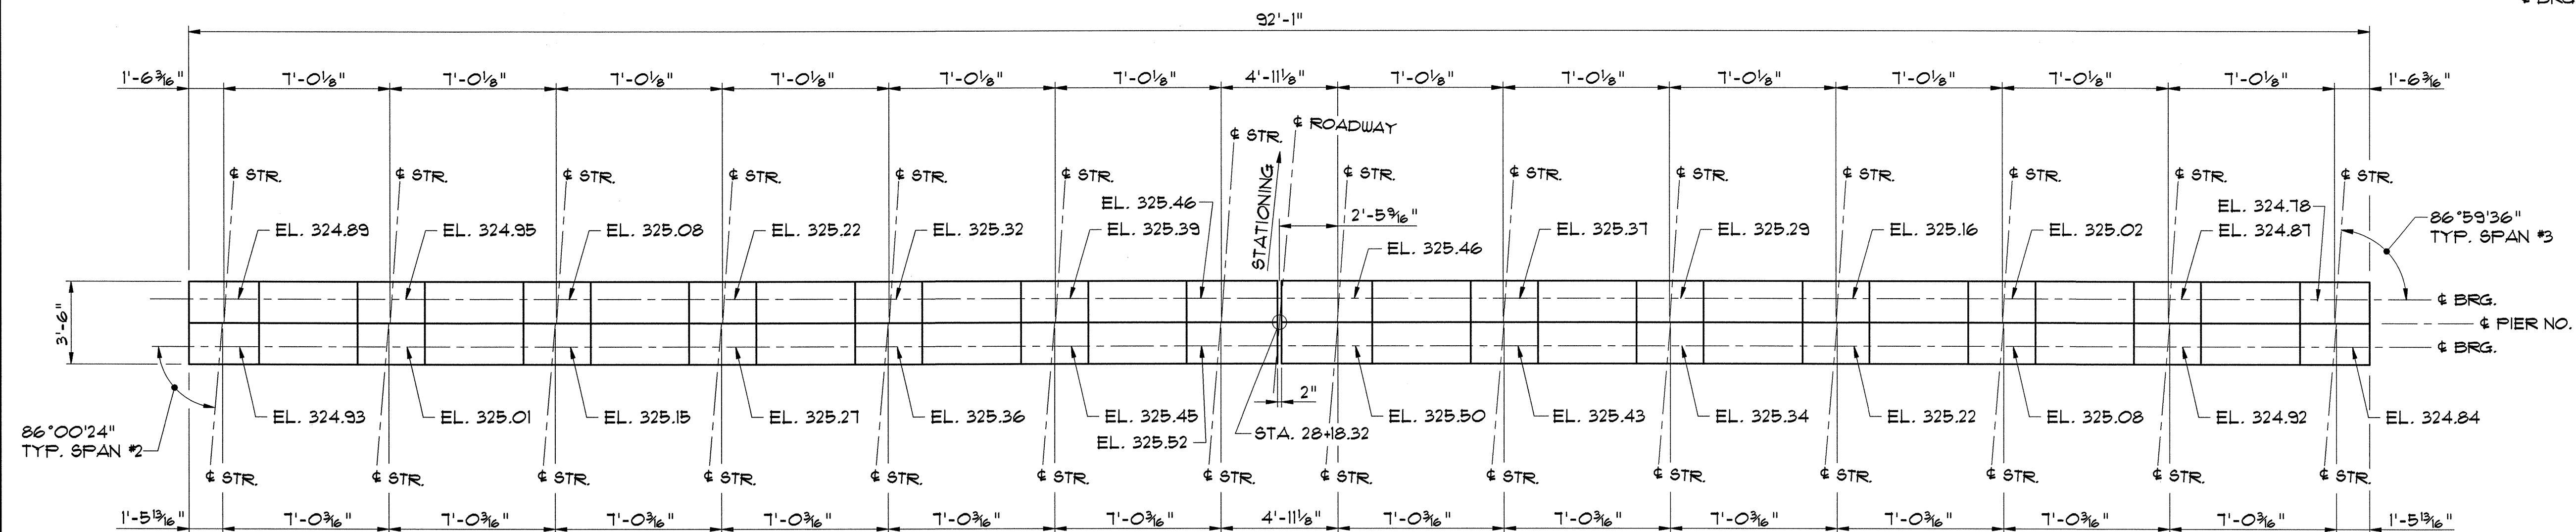


PIER NO. 2 CAP PLAN

SCALE: 1/4" = 1'-0"

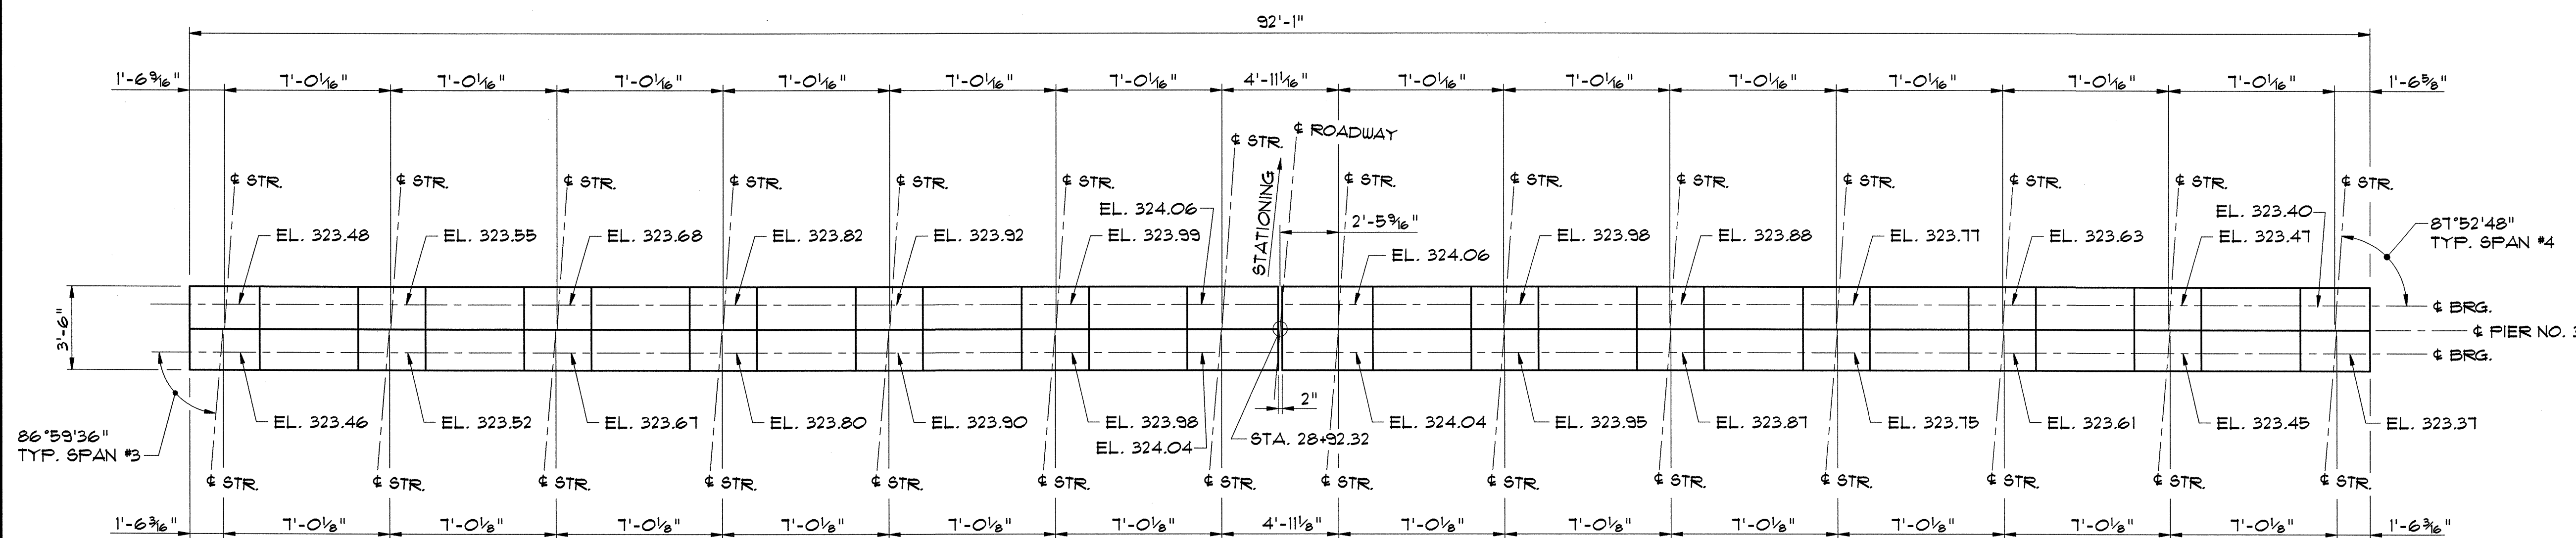

PIER NO. 3 CAP PLAN

SCALE: 1/4" = 1'-0"

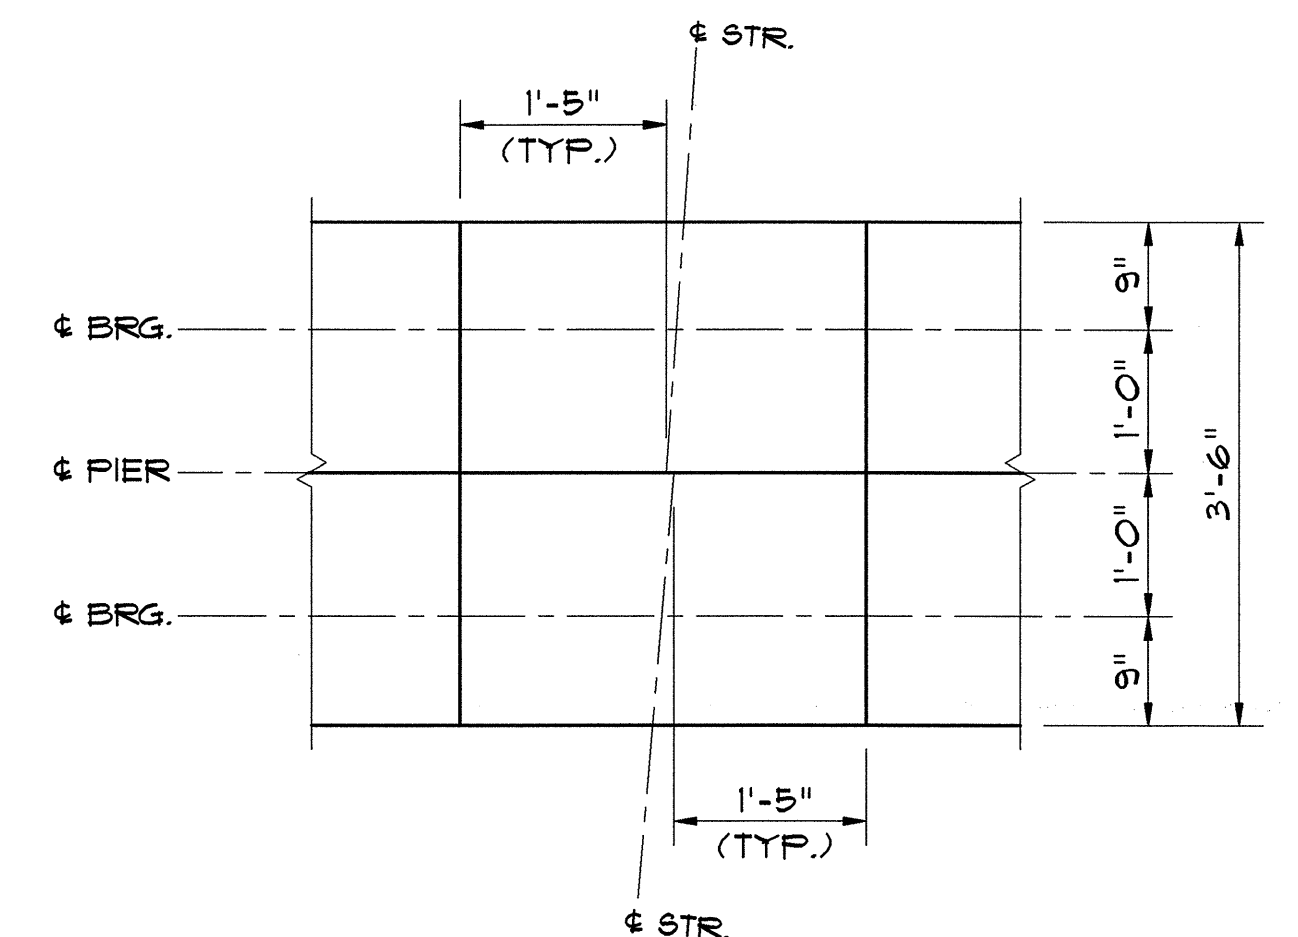

DETAIL A

SCALE: 3/4" = 1'-0"

STATE OF VERMONT AGENCY OF TRANSPORTATION

Town Of SOUTH BURLINGTON	Bridge No. 68
Highway No. U.S. 2	Log Sta.
	Surv. Sta.

U.S. 2 OVER I-89
PIER CAP PLAN

Designed By S.M. HODGDON	Drawn By B.J. MASSE
Checked By T.S. BRYANT 1/00	Bridge Design Supervisor C.D. BAKER Date 1/00

PROJECT SOUTH BURLINGTON	PROJECT NO. IM DECK (36)
--------------------------	--------------------------

VHB Cad Drawing No. 50929FRPL	Date 1/00
Bridge Sheet No.	Sheet 30 of 75

VANASSE HANGEN BRUSTLIN, INC.