



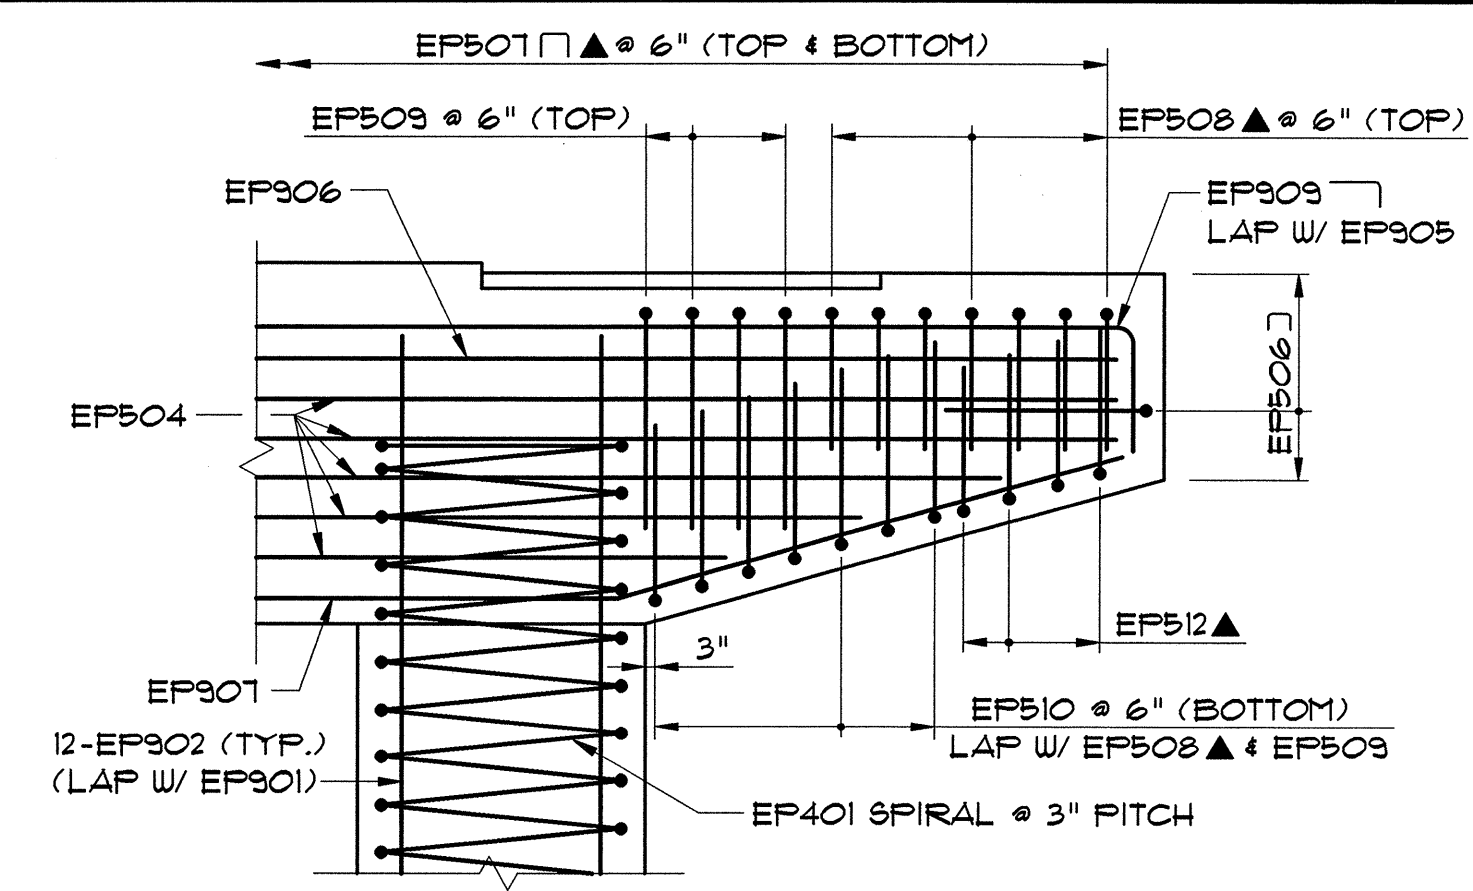


PIER CAP PLAN
SCALE: 1/4" = 1'-0"

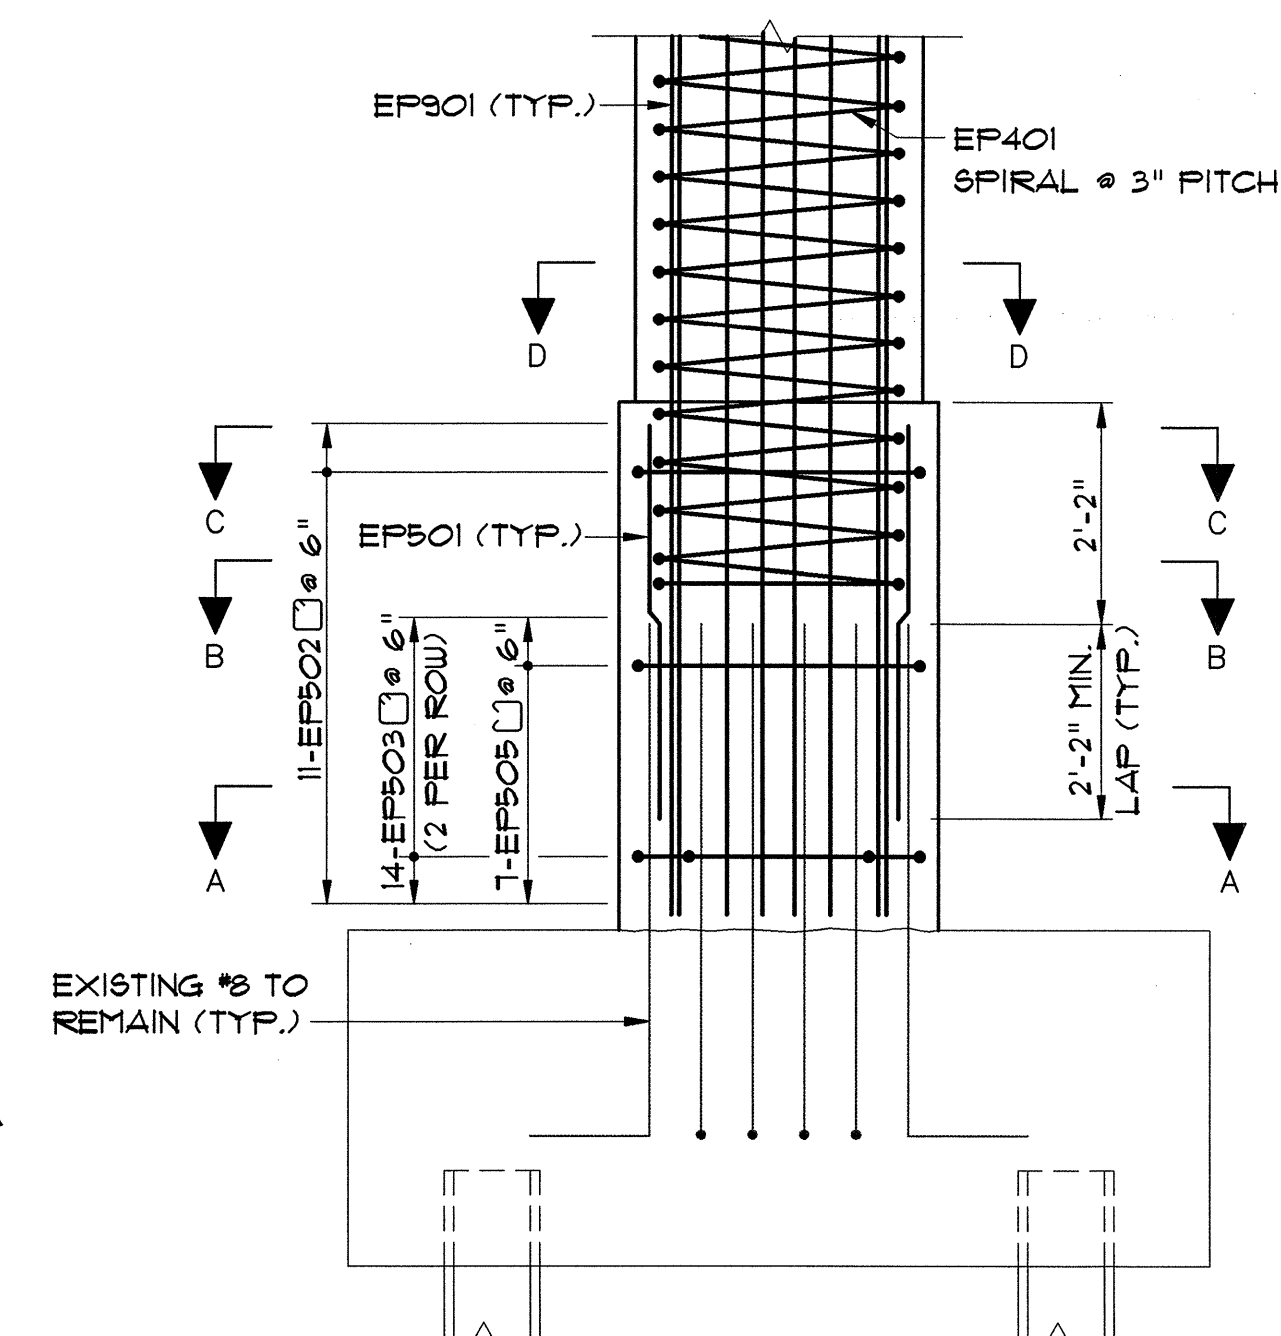


SECTION G-G
SCALE: $\frac{1}{2}" = 1'-0"$

TYPICAL PIER REINFORCEMENT
SCALE: 1/4" = 1'-0"

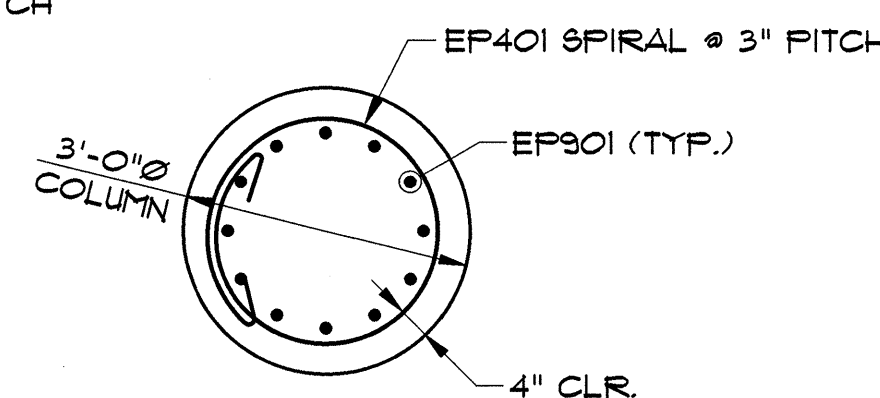

SECTION D-D
SCALE: $\frac{1}{2}" = 1'-0"$

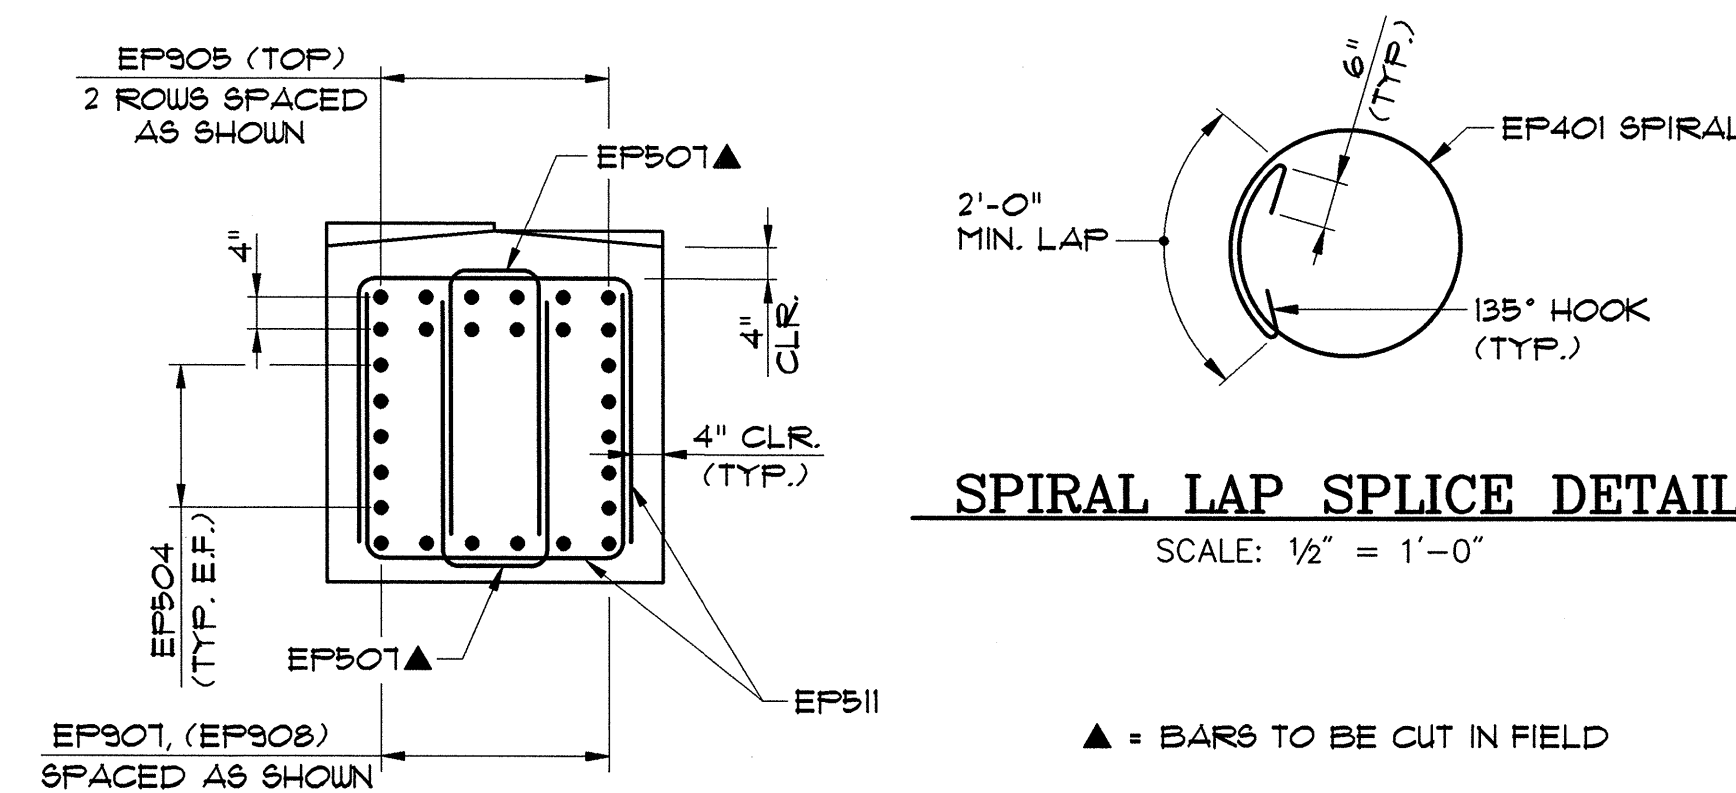

▲ = BARS TO BE CUT IN FIELD

1. NO LAP SPLICES IN THE COLUMN SPIRAL REINFORCEMENT SHALL BE ALLOWED WITHIN THE LIMITS SHOWN. ALL COLUMN SPIRAL REINFORCEMENT LAP SPLICES SHALL BE AS SHOWN ON SPIRAL LAP SPLICE DETAIL.
2. NOTE NOT USED.
3. SEE BRIDGE SHEET 9 FOR REINFORCEMENT NOTES.
4. SEE BRIDGE SHEETS 22 AND 23 FOR BEARING ANCHOR BOLTS LAYOUT.

	PROJECT SOUTH BURLINGTON	PROJECT NO. IM DECK(36)
C.	VHB Cad Drawing No. 50929PREF	Date 1/00
	Bridge Sheet No.	Sheet 31 of 75

VANASSE HANGEN BRUSTLIN, INC.