


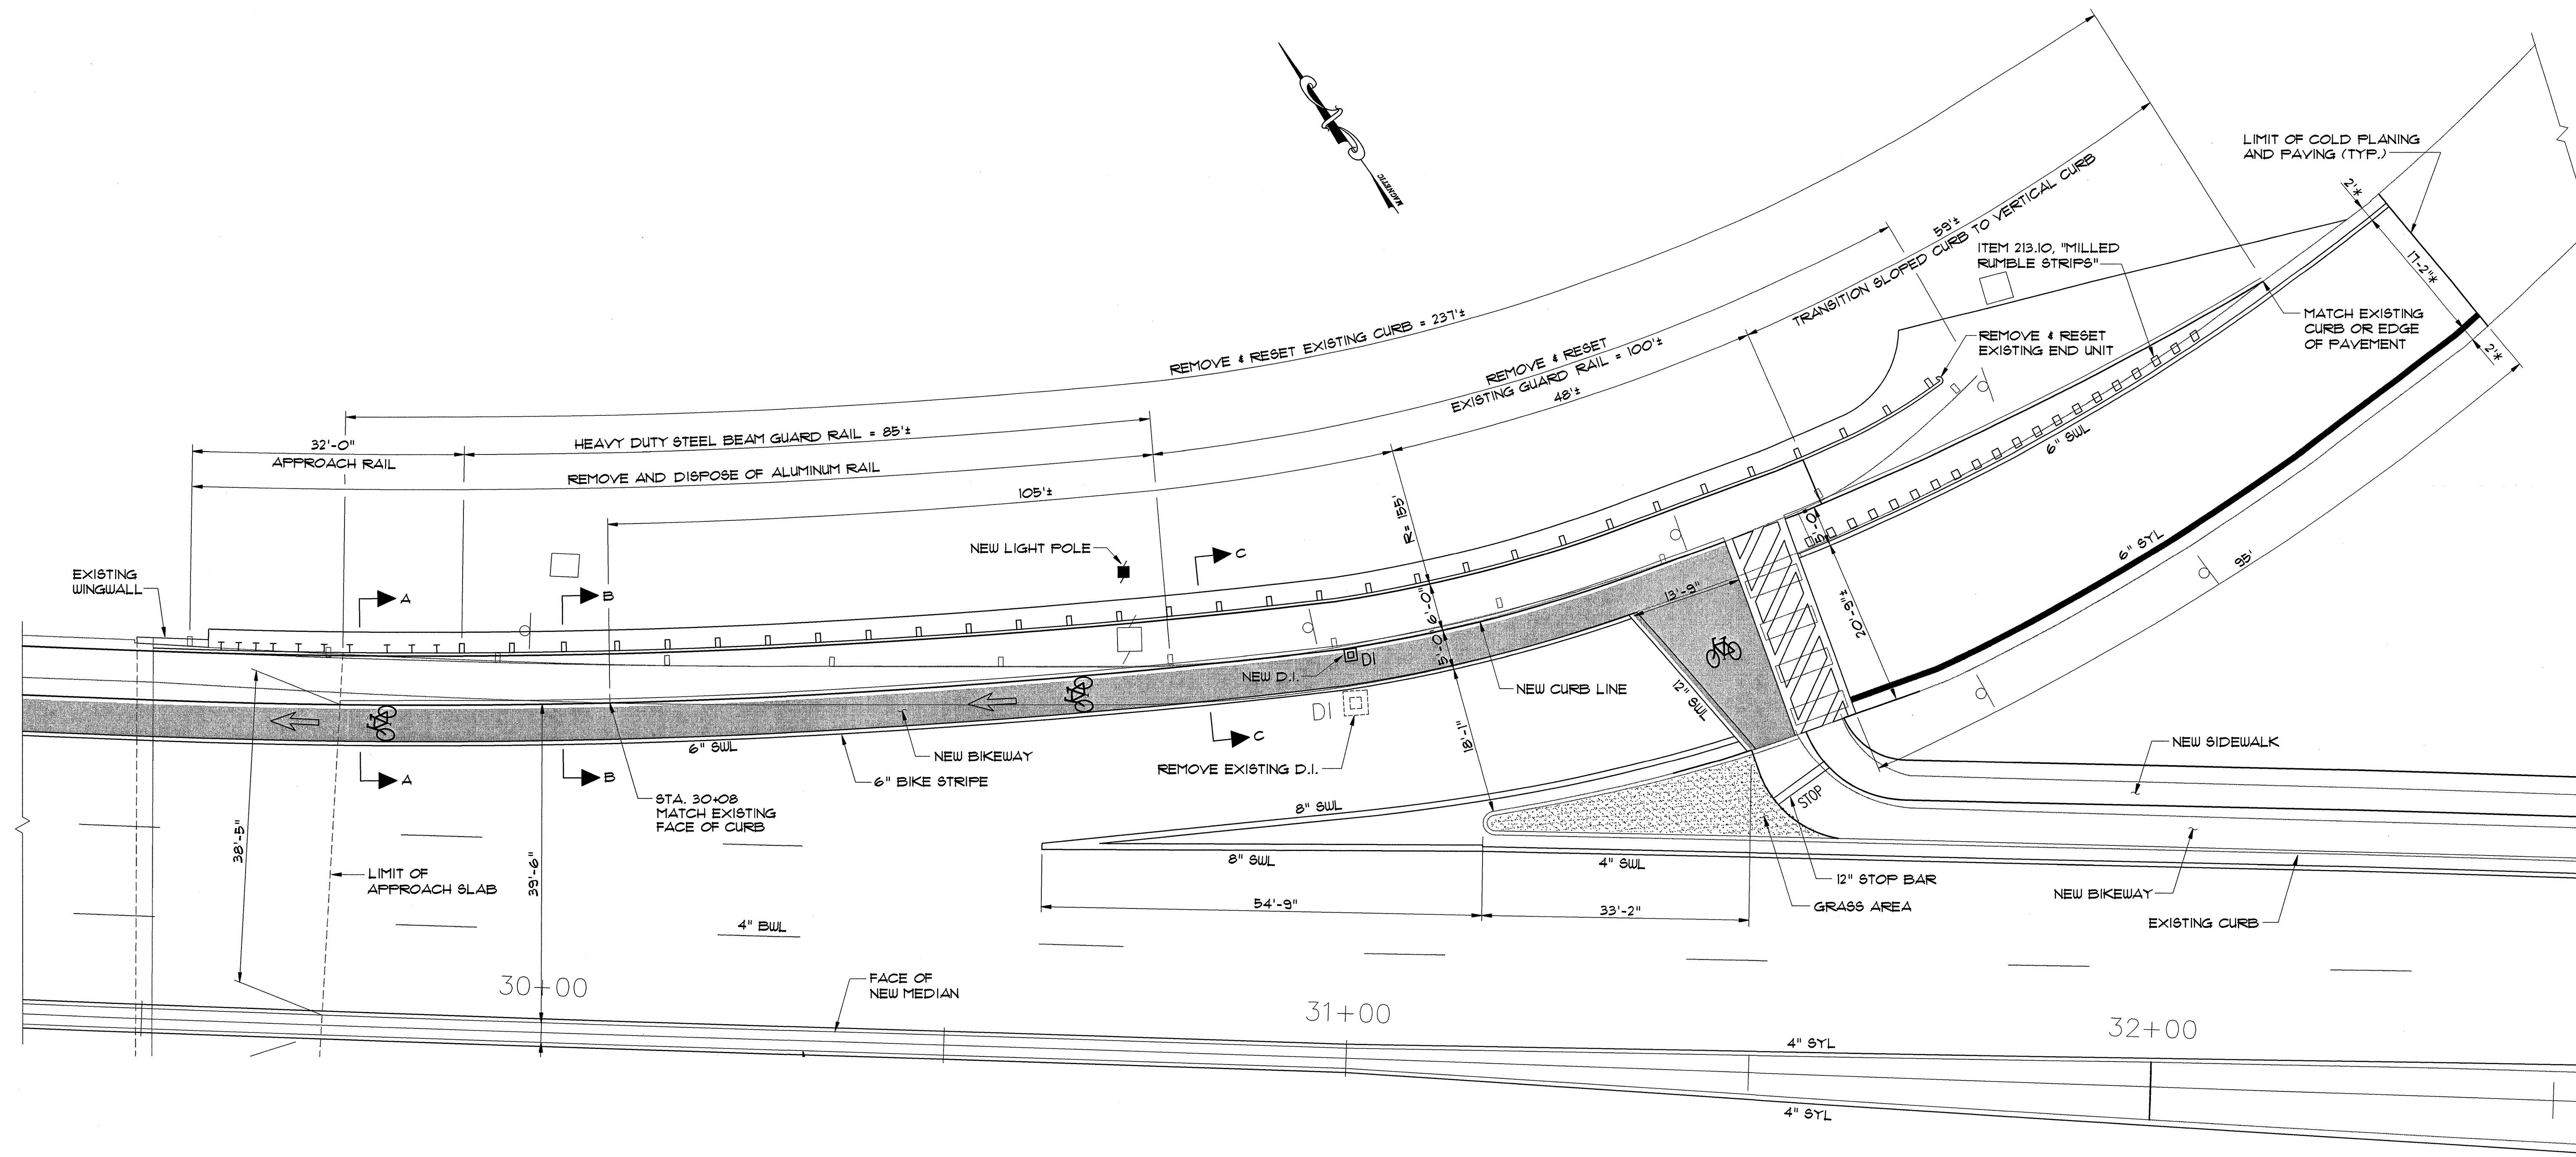

*MATCH EXISTING PAVEMENT MARKINGS


RAMP G

SCALE: 1' = 10'

■ = INDICATES LIMIT OF
ITEM 646.25. SEE
SHEET 34 FOR TYPICAL DETAIL.

STRIPING LEGEND:

SWL = SOLID WHITE LINE
SYL = SOLID YELLOW LINE
BWL = BROKEN WHITE LINE

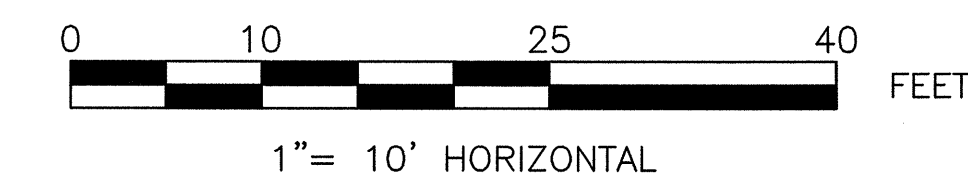

SHEET NOTES:

- SEE SHEET 41 FOR LEGEND.
- CURB AND PAVEMENT SHALL BE PLACED AS DIRECTED BY THE ENGINEER FROM LIMIT OF COLD PLANING ON RAMP TO NEW CROSSWALK SO THAT THE ROADWAY WILL DRAIN PROPERLY. THIS WORK SHALL BE SUBSIDIARY TO THE CURB AND PAVEMENT ITEMS.
- PAVEMENT MARKINGS FOR BIKE SYMBOL AND ARROWS SHALL BE PAID FOR AS ITEM 646.50, "DURABLE LETTER OR SYMBOL. SEE SPECIAL PROVISIONS FOR DETAILS.
- SEE SHEET 34 FOR SECTIONS A-A, B-B, AND C-C.
- INFORMATION SHOWN ON THE PLANS IS BASED ON EXISTING DRAWINGS AND LIMITED SURVEY. THE CONTRACTOR SHALL FIELD VERIFY THE LAYOUT OF THE PROPOSED CURB, SIDEWALK, AND GUARD RAIL. ANY ADJUSTMENTS TO THE LAYOUT THAT ARE REQUIRED SHALL BE BROUGHT TO THE ATTENTION OF THE ENGINEER PRIOR TO EXCAVATION OR PAVEMENT/CURB REMOVAL. ALL COSTS FOR THIS WORK SHALL BE SUBSIDIARY TO ALL OTHER ITEMS IN THE CONTRACT.

STATE OF VERMONT AGENCY OF TRANSPORTATION

Town Of	SOUTH BURLINGTON	Bridge No.	68
Highway No. U.S.	2	Log Sta.	
		Surv. Sta.	

U.S. 2 OVER I-89

BIKEWAY PLAN RAMP G

Designed By	S.M. HODGSON	Drawn By	B.J. MASSE
Checked By	T.S. BRYANT	Date	2/00
		Bridge Design Supervisor	C.D. BAKER
		Date	2/00

PROJECT	SOUTH BURLINGTON	PROJECT NO.	STP BIKE (28)S
VHB Cad Drawing No.	50963RAMP	Date	2/00

Bridge Sheet No.		Sheet	52 of 75
------------------	--	-------	----------

VANASSE HANGEN BRUSTLIN, INC.