


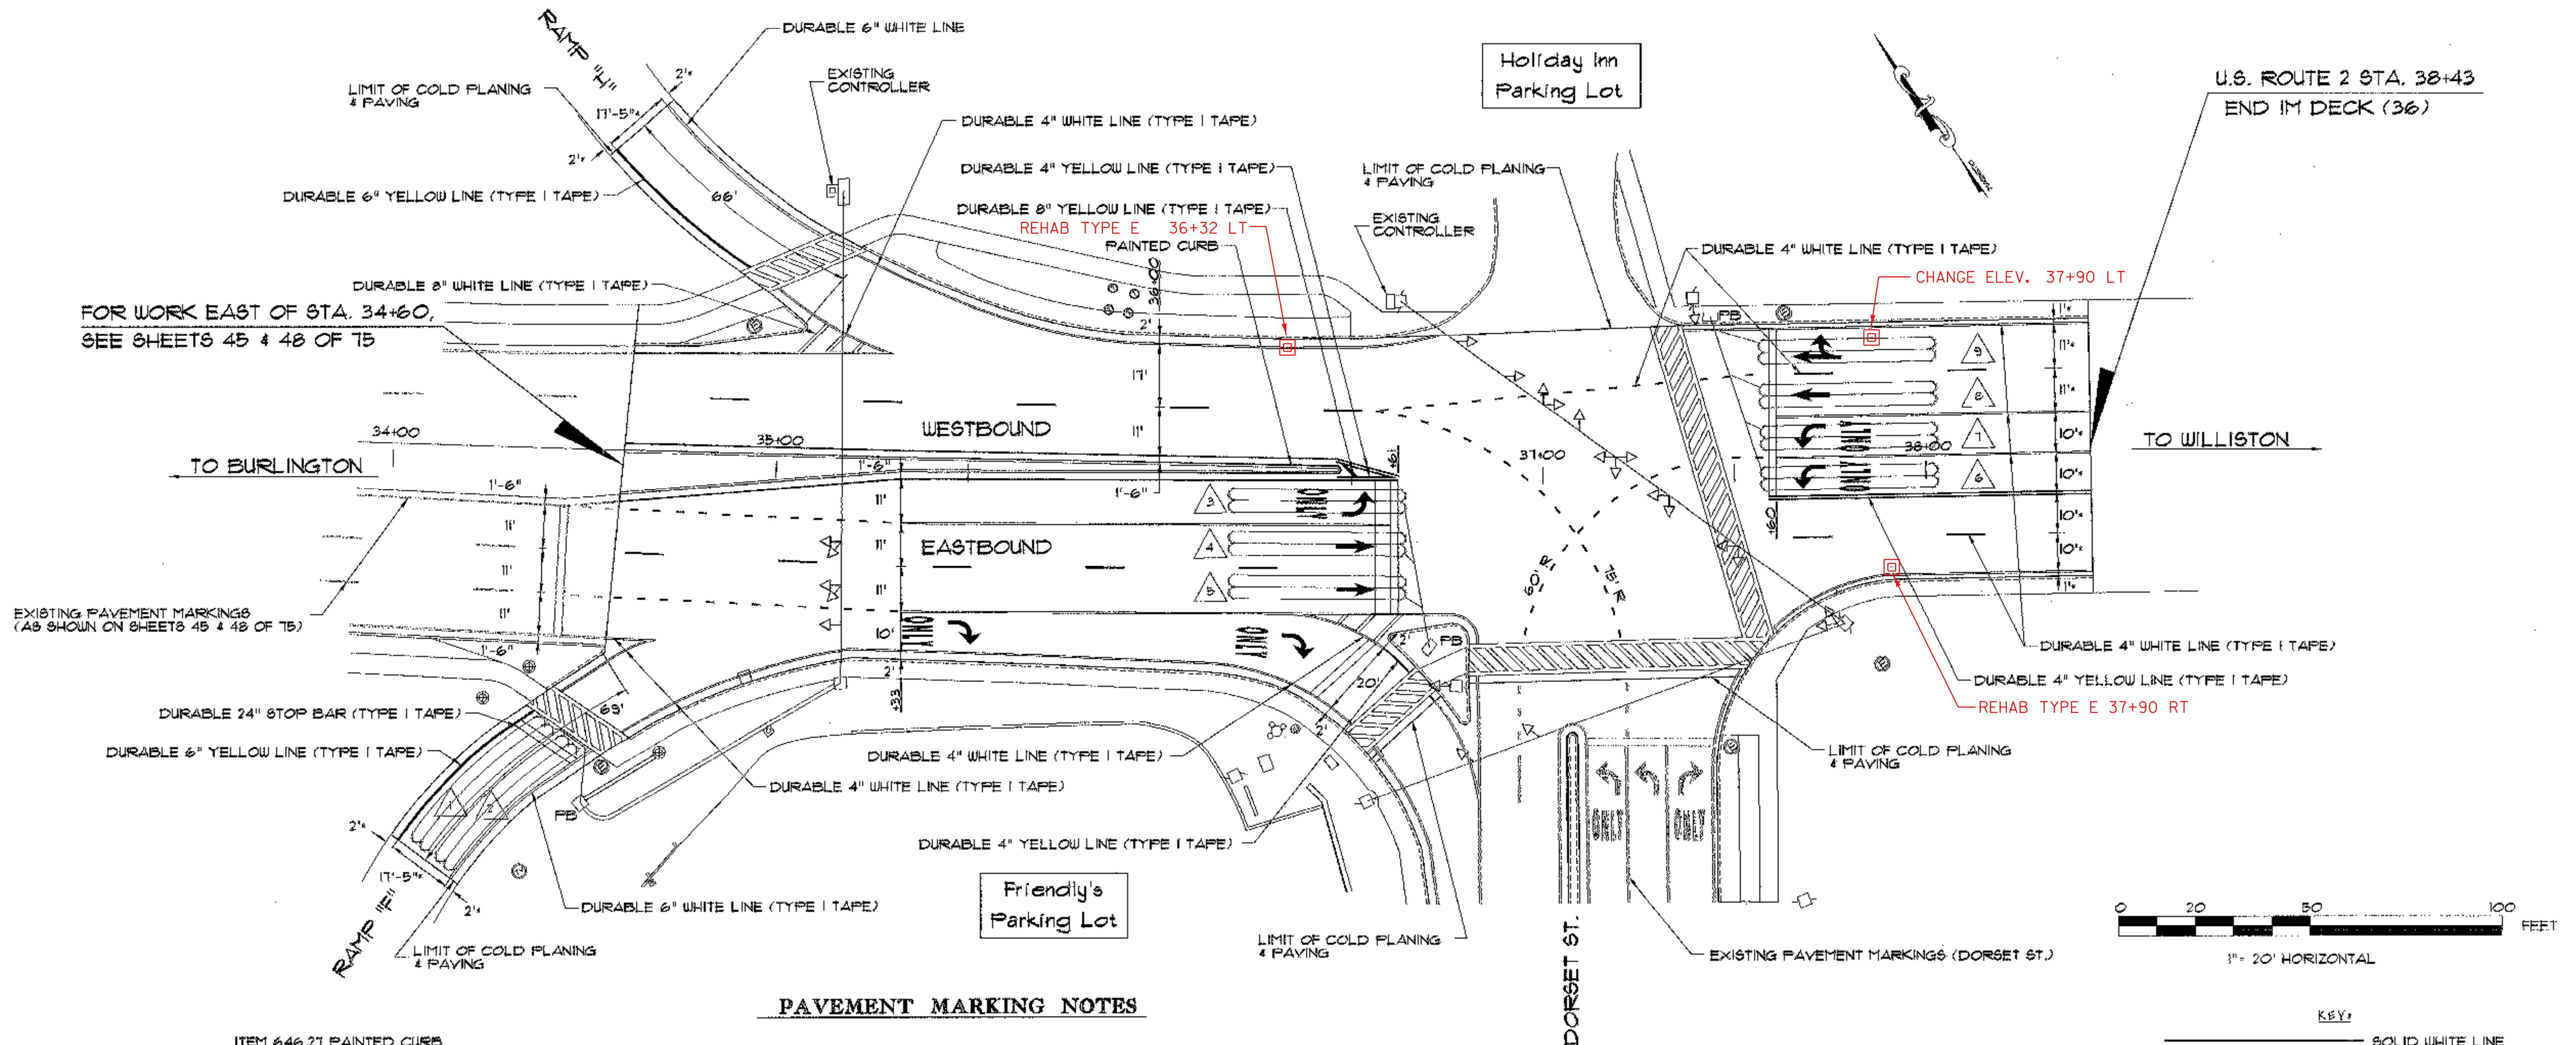

### PAVEMENT MARKING NOTES

**ITEM 646.21 PAINTED CURB**  
STA. 36+17, TO 36+47, LT. & RT. (ISLAND)

**ITEM 646.40 DURABLE 4" WHITE LINE (TYPE I TAPE)**  
**ITEM 646.60 TEMPORARY 4" WHITE LINE**

STA. 34+60, LT. TO STA. 36+55, LT. (DASHED)  
STA. 34+60, RT. TO STA. 35+33, RT. (DOTTED)  
STA. 34+60, RT. TO STA. 36+60, RT. (DASHED)  
STA. 34+45, RT. TO STA. 35+20, RT. (SOLID - RAMP "F")  
STA. 34+63, LT. TO STA. 35+30, LT. (SOLID - RAMP "H")  
STA. 35+20, RT. TO STA. 36+50 (EDGE LINE)  
STA. 35+20, LT. TO STA. 36+74, LT. (EDGE LINE)  
STA. 35+33, RT. TO STA. 36+60, RT. (LANE LINE)  
STA. 35+33, RT. TO STA. 36+82, RT. (LANE LINE)  
STA. 36+55, LT. TO STA. 37+53, LT. (DOTTED)  
STA. 36+55, LT. TO STA. 37+20, RT. (DOTTED)  
STA. 36+54, RT. TO STA. 37+53, LT. (DOTTED)  
STA. 37+37, LT. TO STA. 38+43, LT. (EDGE LINE)  
STA. 37+53, RT. TO STA. 38+43, RT. (EDGE LINE)  
STA. 37+61, LT. TO STA. 38+43, LT. (LANE LINES X3)  
STA. 37+61, RT. TO STA. 38+43, RT. (DASHED)

**ITEM 646.41 DURABLE 4" YELLOW LINE (TYPE I TAPE)**  
**ITEM 646.61 TEMPORARY 4" YELLOW LINE**

STA. 34+60 TO STA. 36+62, LT. & RT. (ISLAND)  
STA. 36+58, RT. TO STA. 36+71, RT. (ISLAND)  
STA. 37+53 TO STA. 38+43, RT. (DOUBLE SOLID CENTERLINE)

**ITEM 646.414 DURABLE 6" WHITE LINE (TYPE I TAPE)**  
**ITEM 646.614 TEMPORARY 6" WHITE LINE**

STA. 34+14, RT. TO STA. 34+51, RT. (RAMP "F")  
STA. 34+63, LT. TO STA. 35+11, LT. (RAMP "H")

**ITEM 646.415 DURABLE 6" YELLOW LINE (TYPE I TAPE)**  
**ITEM 646.615 TEMPORARY 6" YELLOW LINE**

STA. 34+02, RT. TO STA. 34+37, RT. (RAMP "F")  
STA. 34+57, LT. TO STA. 34+82, LT. (RAMP "H")

**ITEM 646.42 DURABLE 8" WHITE LINE (TYPE I TAPE)**  
**ITEM 646.62 TEMPORARY 8" WHITE LINE**

STA. 35+06, LT. TO STA. 35+23, LT. (DIAGONALS)  
STA. 36+46, RT. TO STA. 36+63, RT. (DIAGONALS)

**ITEM 646.43 DURABLE 8" YELLOW LINE (TYPE I TAPE)**  
**ITEM 646.63 TEMPORARY 8" YELLOW LINE**

STA. 36+50, LT. (DIAGONALS)

**ITEM 646.46 DURABLE 24" STOP BAR (TYPE I TAPE)**  
**ITEM 646.66 TEMPORARY 24" STOP BAR**

STA. 34+40, RT. (RAMP "F")  
STA. 36+50, RT.  
STA. 36+61, RT.  
STA. 37+60, LT.

**ITEM 646.50 DURABLE LETTER OR SYMBOL (TYPE I TAPE)**

STA. 35+37, RT. ("ONLY")  
STA. 35+49, RT. (ARROW)  
STA. 36+24, RT. ("ONLY")  
STA. 36+36, RT. (ARROW)  
STA. 36+40, RT. ("ONLY")  
STA. 36+51, RT. (2-ARROWS)  
STA. 36+52, RT. (ARROW)  
STA. 37+63, LT. (ARROW)  
STA. 37+63, RT. (ARROW)  
STA. 37+70, LT. (ARROW)  
STA. 37+72, LT. (2-ARROWS)  
STA. 37+81, LT. ("ONLY")  
STA. 37+81, RT. ("ONLY")

**ITEM 646.51 DURABLE CROSSWALK W/DIAGONAL LINES (TYPE I TAPE)**  
**ITEM 646.71 TEMPORARY CROSSWALK W/DIAGONAL LINES**

STA. 34+50, RT. (RAMP "F")  
STA. 35+06, LT. (RAMP "H")  
STA. 36+61, RT.  
STA. 36+81, RT. TO STA. 37+55, RT.  
STA. 37+33, LT. TO STA. 37+55, RT.

**ITEM 646.70 TEMPORARY LETTER OR SYMBOL**

STA. 35+49, RT. (ARROW)  
STA. 36+36, RT. (ARROW)  
STA. 36+51, RT. (2-ARROWS)  
STA. 36+52, RT. (ARROW)  
STA. 37+63, LT. (ARROW)  
STA. 37+63, RT. (ARROW)  
STA. 37+70, LT. (ARROW)  
STA. 37+72, LT. (2-ARROWS)

### NOTES:

- FOR ADDITIONAL STRIPING DETAILS SEE VTRANS STANDARDS E-191, E-192 & E-193
- FOR VEHICLE DETECTOR-LOOP INFORMATION, SEE SHEET 54B
- \* MATCH EXISTING PAVEMENT MARKINGS



### KEY:

— SOLID WHITE LINE  
— SOLID YELLOW LINE  
- - - DOTTED WHITE LINE  
--- DASHED WHITE LINE

## STATE OF VERMONT AGENCY OF TRANSPORTATION

|                                                 |                  |                          |              |
|-------------------------------------------------|------------------|--------------------------|--------------|
| Town Of                                         | SOUTH BURLINGTON | Bridge No.               | 68           |
| Highway No.                                     | U.S. 2           | Log Sta.                 |              |
|                                                 |                  | Surv. Sta.               |              |
| U.S. 2 OVER I-89                                |                  |                          |              |
| U.S. ROUTE 2 & DORSET ST. INTERSECTION (1 OF 3) |                  |                          |              |
| Designed By                                     | D-H              | Drawn By                 | D-H          |
| Checked By                                      | JLL              | Bridge Design Supervisor | Date         |
| PROJECT                                         | SOUTH BURLINGTON | PROJECT NO.              | IM DECK (36) |
| D-H Cad Drawing No.                             | DORSET ST.       | Date                     | 1/00         |
| Bridge Sheet No.                                |                  | Sheet                    | 54A of 75    |

