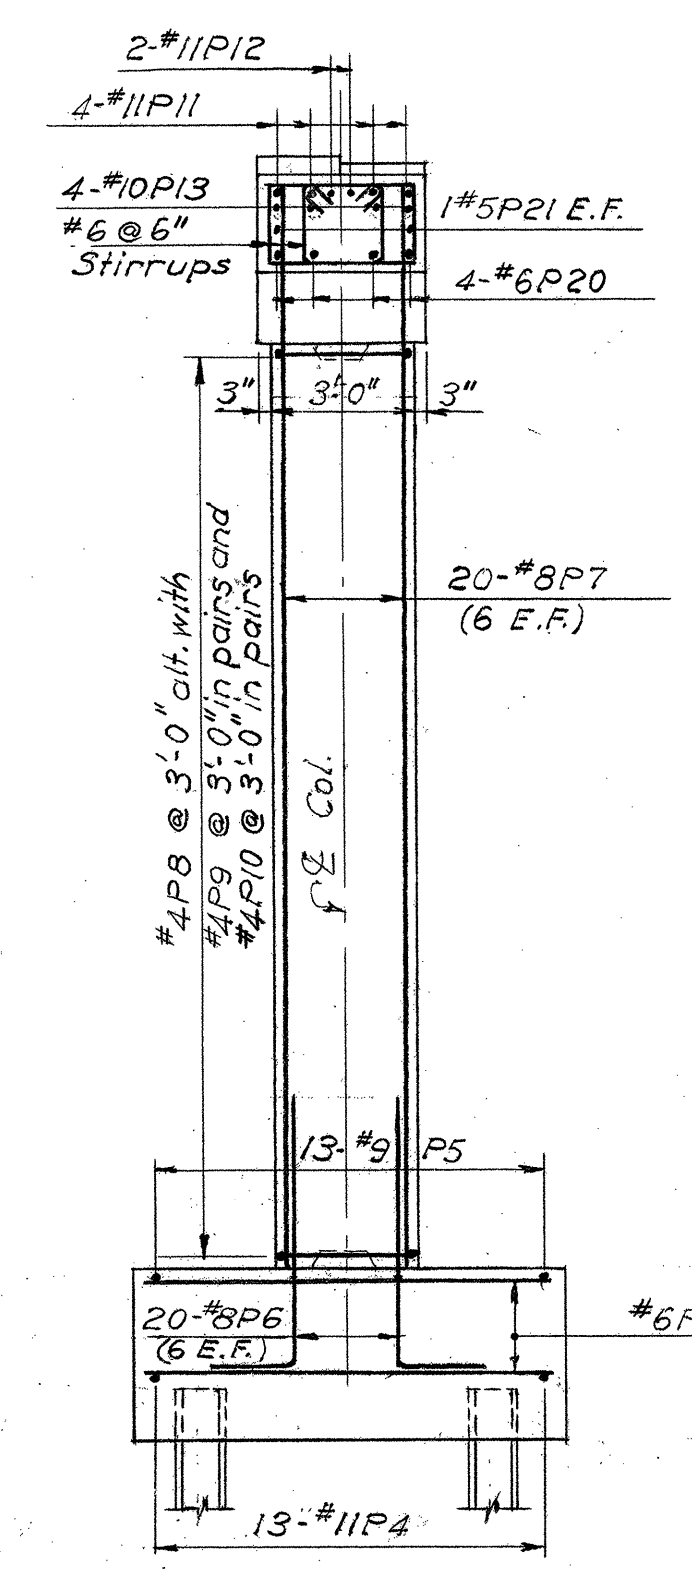
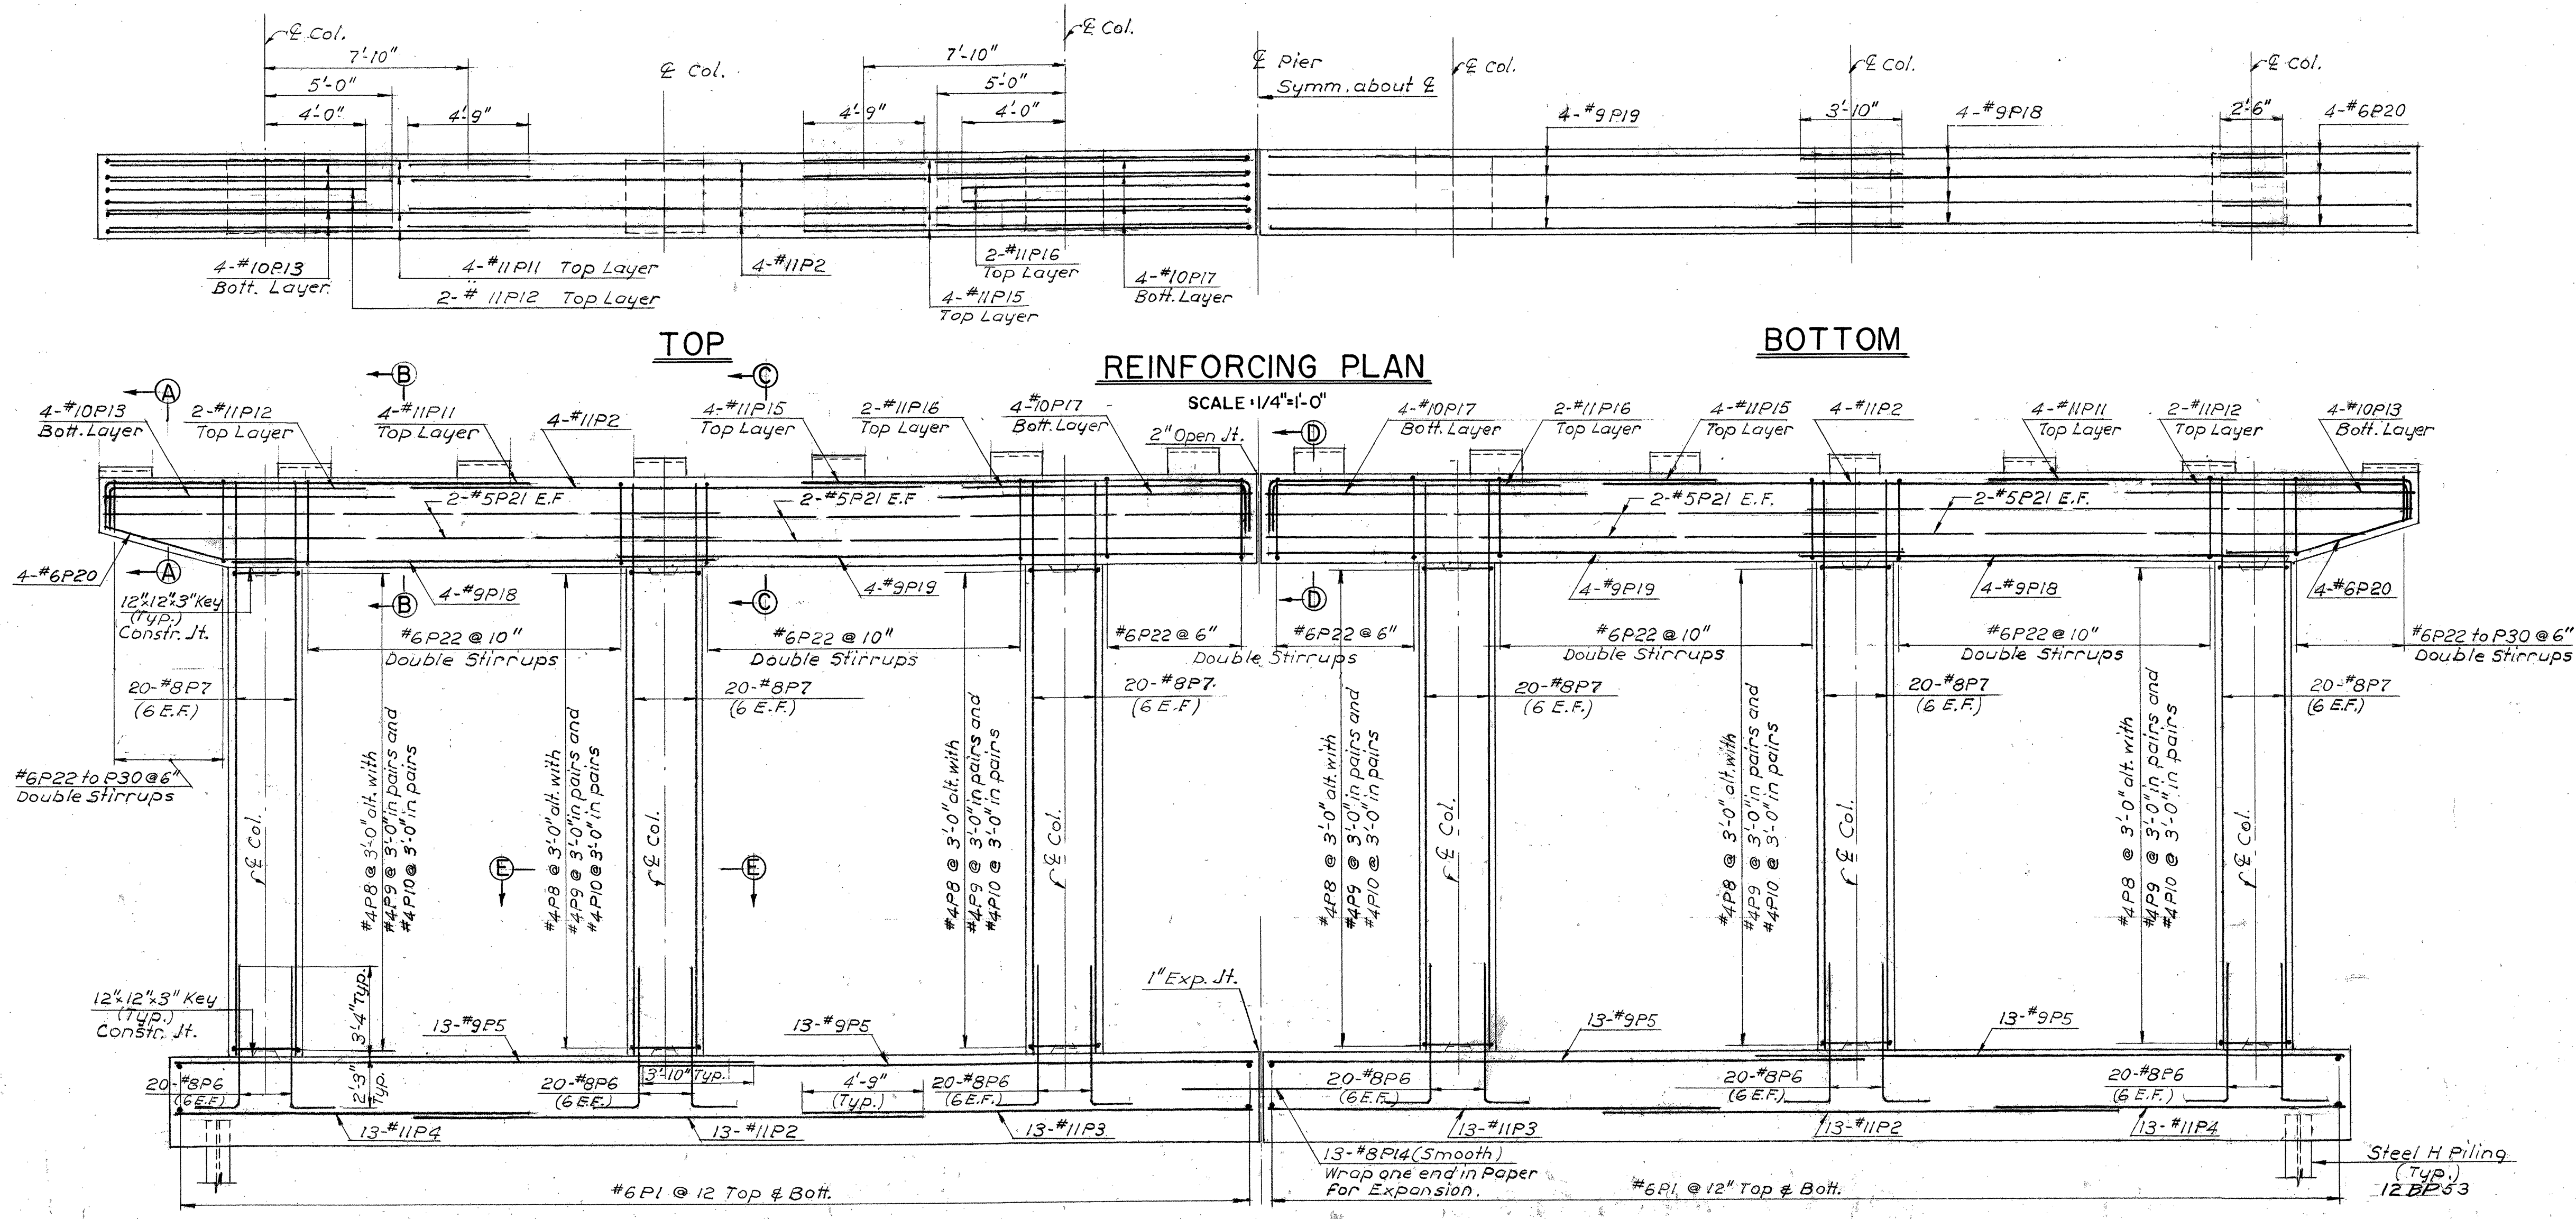


- NOTES:**
1. For General Notes see Br 1
 2. For Pier elevations and quantities, see Br 4
 3. For Pier Plans and Pile Plans, see Br 5

SOUTH BURLINGTON IM DECK(36)
FOR REFERENCE ONLY - BRIDGE 68
SHEET 65 OF 75

STATE OF VERMONT DEPARTMENT OF HIGHWAYS	
INTERSTATE PROJECT IN THE TOWNS OF SOUTH BURLINGTON.	
UNDERPASS STA.2101+78.29 BURLINGTON INTERCHANGE PIER DETAILS	
BOSWELL ENGINEERING CO. RIDGEFIELD PARK, N.J.	
DRAWN BY: D.S.	IN CHARGE: A.J.L.
CHECKED BY: M.J.C.	DATE:
PROJECT NO. I 89-3 (12)	SHEET 155 OF 175