



646.41 DURABLE 100 mm YELLOW LINE
(ALL LINES WILL INCLUDE C/L BREAKS
FOR TOWN HIGHWAYS) S=SOLID, D=DASHED
WINHALL:
STA. 5+175.000 - STA. 5+399.349 S - S
STA. 5+187.700 - STA. 5+392.000 LT (GORE EDGE LINES)

646.61 TEMPORARY 100 mm YELLOW LINE
(ALL LINES WILL INCLUDE C/L BREAKS
FOR TOWN HIGHWAYS) S=SOLID, D=DASHED
WINHALL:
STA. 5+175.000 - STA. 5+399.349 S - S
STA. 5+187.700 - STA. 5+392.000 LT (GORE EDGE LINES)

646.40 DURABLE 100 mm WHITE LINE
(ALL LINES WILL INCLUDE EDGE LINE BREAKS
AND RADIUS FOR TOWN HIGHWAYS)
WINHALL:
STA. 5+175.000 - STA. 5+399.349 LT AND RT
STA. 5+175.000 - STA. 5+187.700 SOLID 3.0 m LT
STA. 5+187.700 - STA. 5+248.000 DOTTED 3.0 m LT


646.60 TEMPORARY 100 mm WHITE LINE
(ALL LINES WILL INCLUDE EDGE LINE BREAKS
AND RADIUS FOR TOWN HIGHWAYS)
WINHALL:
STA. 5+175.000 - STA. 5+399.349 LT AND RT
STA. 5+175.000 - STA. 5+187.700 SOLID 3.0 m LT
STA. 5+187.700 - STA. 5+248.000 DOTTED 3.0 m LT

646.43 DURABLE 200 mm YELLOW LINE
WINHALL:
STA. 5+187.700 - STA. 5+392.000 LT (DIAGONAL LINES)
646.50 DURABLE LETTER OR SYMBOL
WINHALL:
STA. 5+182.660 LT, ARROW (1EA)
STA. 5+186.430 LT, "ONLY" (4 EA)

646.70 TEMPORARY LETTER OR SYMBOL
WINHALL:
STA. 5+182.660 LT, ARROW (1EA)

675.50 REMOVING SIGNS
AS SHOWN - 1

675.60 ERECTING SALVAGED SIGNS
AS SHOWN - 1

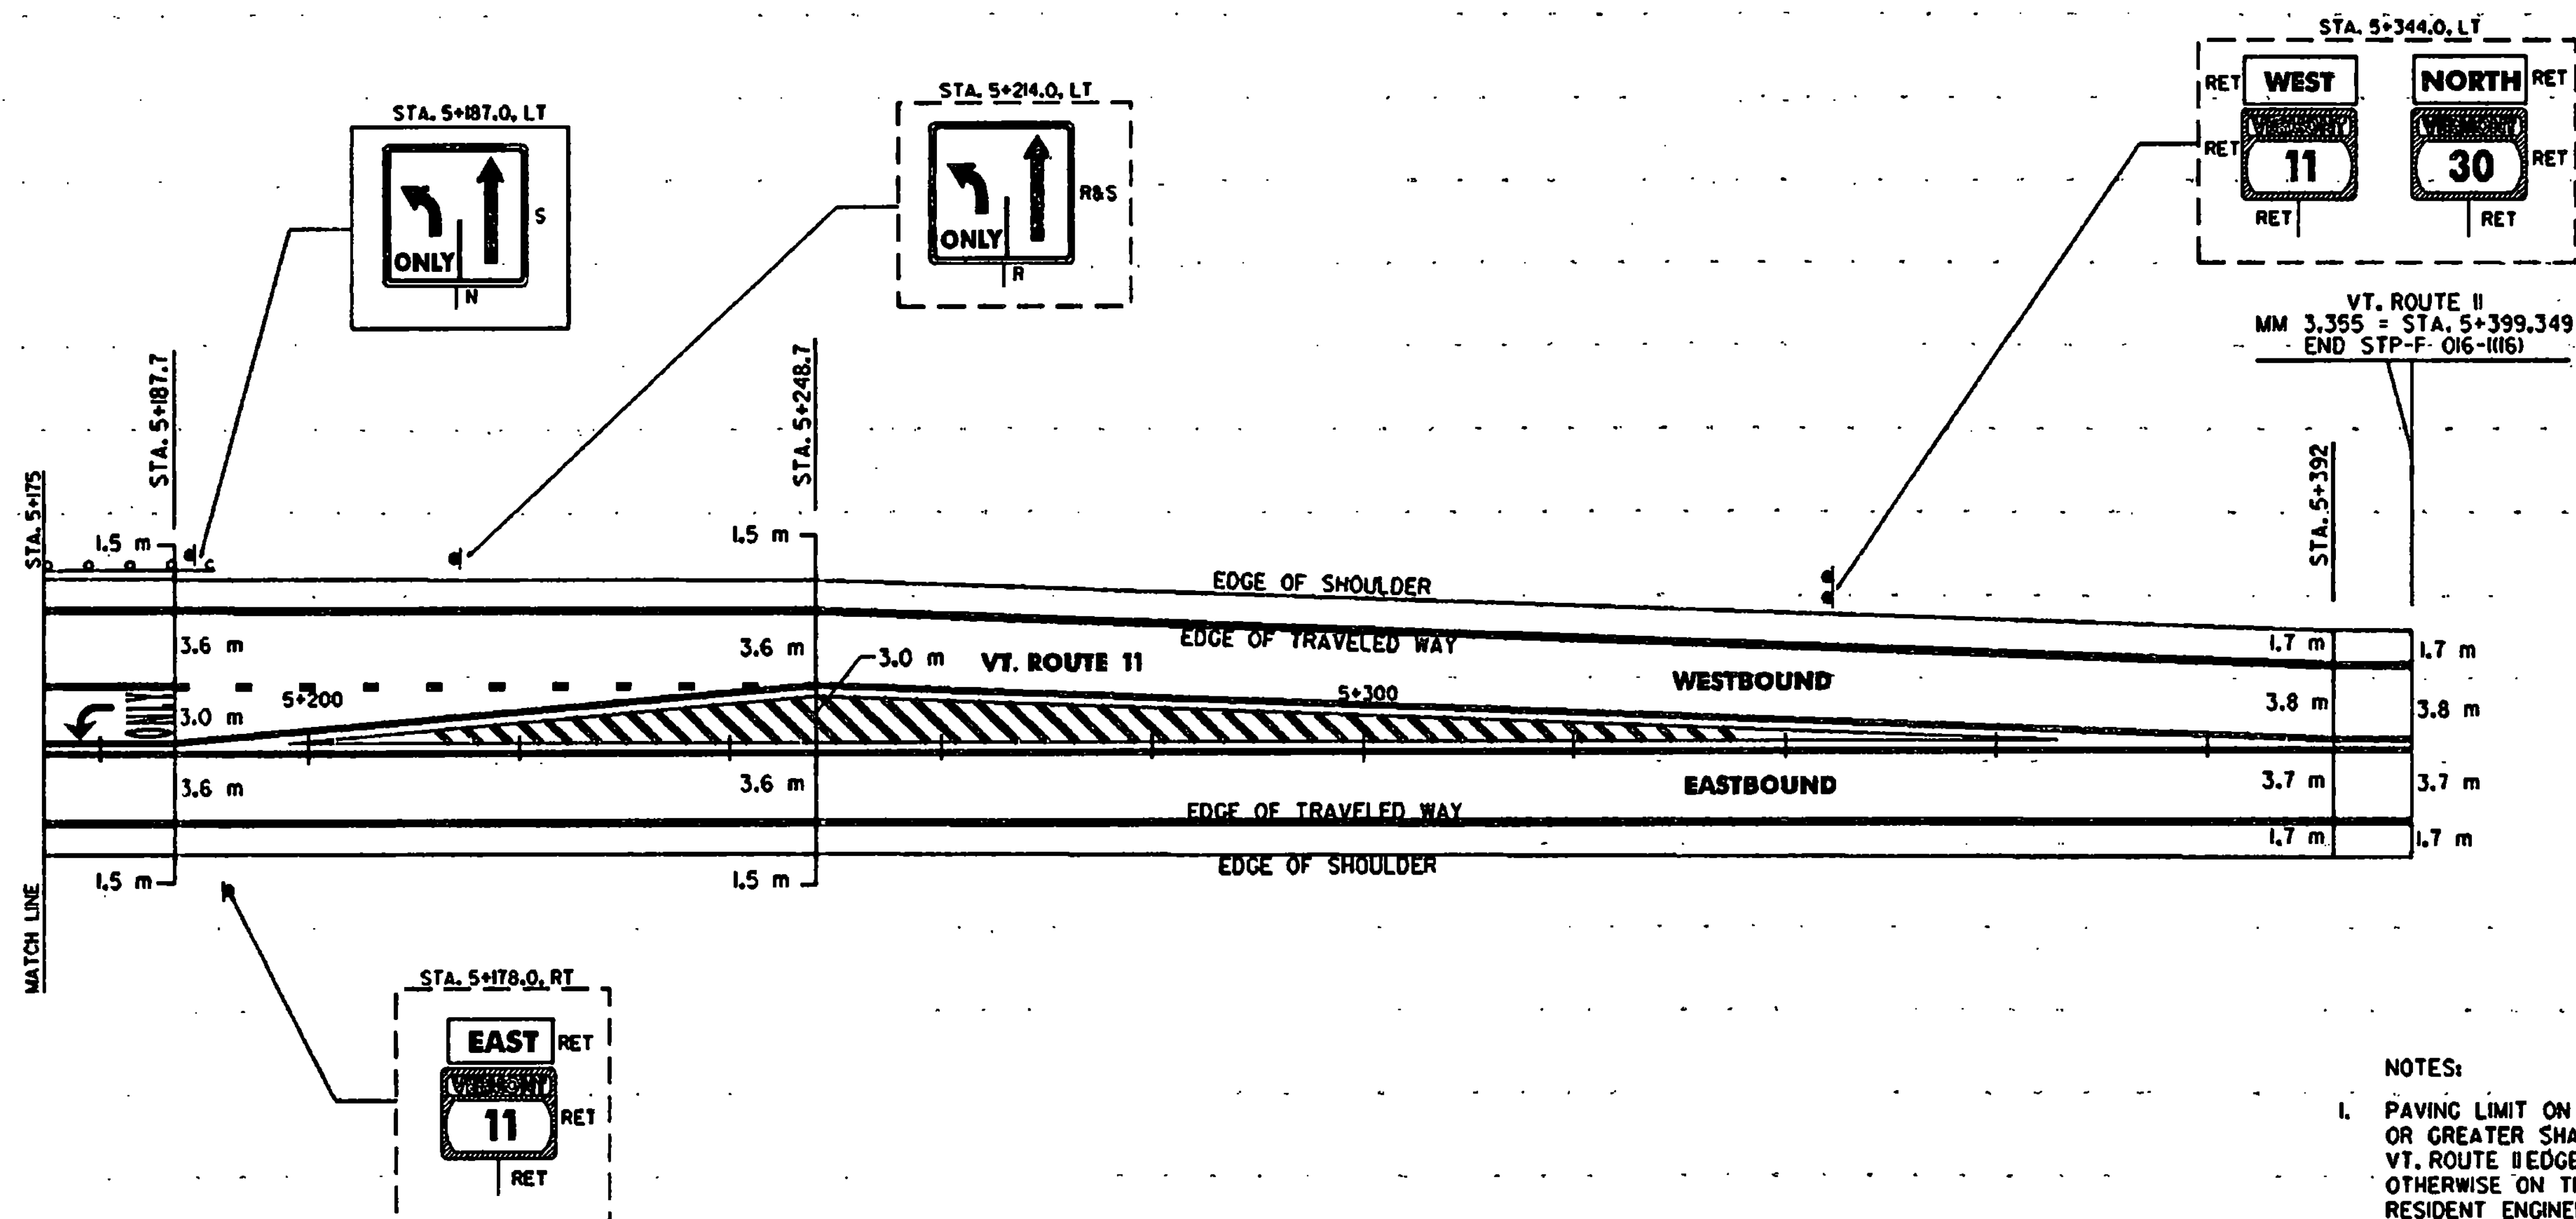

NOTES:

- PAVING LIMIT ON ALL TOWN HIGHWAYS 6.7 m WIDE OR GREATER SHALL BE MEASURED 15 m BACK FROM VT. ROUTE 11 EDGE OF SHOULDER UNLESS DENOTED OTHERWISE ON THE PLANS OR AS DIRECTED BY THE RESIDENT ENGINEER. PAVING LIMIT ON ALL TOWN HIGHWAYS LESS THAN 6.7 m WIDE SHALL BE MEASURED 4 m BACK FROM VT. ROUTE 11 EDGE OF SHOULDER OR AS OTHERWISE DIRECTED BY THE RESIDENT ENGINEER.
- ALL DESTINATION SIGNS ASSOCIATED WITH THE VT. ROUTE 11 INTERSECTION WITH VT. ROUTE 30 SHALL BE RETAINED IN THE FIELD BUT WERE OMITTED ON THESE PLANS FOR CLARITY.

621.20 STEEL BEAM GUARDRAIL (TYPE IV)

WINHALL:
STA. 5+175.0 - STA. 5+179.4 LT (4.4 m)

621.54 MODIFIED ECCENTRIC LOADER TERMINAL (TYPE IV)

WINHALL:
STA. 5+179.4 - STA. 5+190.8 LT

621.80 REMOVAL AND DISPOSAL OF GUARDRAIL

WINHALL:
STA. 5+175.0 - STA. 5+178.9 LT (3.9 m)

621.81 REMOVAL AND DISPOSAL OF GUIDEPOSTS

WINHALL:
STA. 5+180.0 LT (1EA)

SIGN LEGEND

R= REMOVE
S= SALVAGE
N= NEW
RET= RETAIN
B-B= BACK TO BACK
EXISTING= _____
NEW= _____

PAVING PROJECT LAYOUT

SURVEYED BY N/A DATE N/A
DRAWN BY K.H.D. DATE 11/97
SQUAD LEADER T.P.K.
DESIGN FILE NO. /pave/89b016/pb016.dgn
IPARM. FILE 0501610.TT DATE PLOTTED 20-JAN-1998
PROJ. NAME MANCHESTER - WINHALL
PROJ. NO. STP-F 016-1116
SHEET 18 OF 43 SHEETS