


TRAFFIC SIGN SUMMARY SHEET

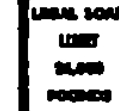

KILOMETER MARKER, STATION, OR SIGN NUMBER	SIGN LEGEND	SIGN DIMENSIONS		NEW & SALVAGED SIGNS				EXIST POST RE TAIN	NO. OF POSTS	FLANGED CHANNEL			SQUARE STEEL (mm)			ANCHOR	S L U E R	NEW SIGN POSTS TUBULAR ALUMINUM Ø (mm)			TUBULAR STEEL Ø (mm)				W-SHAPE STEEL			REMARKS	SIGN DETAIL									
				"A"	"B"	SALV SIGN	SALV TIS			L7	3.0	4.5	44	50	63			75	100	100 MOD.	FOUND- ATION	75	89	100	125	FTG. SIZE			WEIGHT	POST SIZE	DETAIL ON SHEET NUMBER	STD. SHEET NUMBER						
		kg/m	kg/m																							kg/m	kg/m						kg/m	kg/m	kg/m	kg/m	600 mm	750 mm
DORSET: 6+050. 0. RT		1	750	750	0.56							X			X	X																	E-155					
6+182. 0. RT		1	750	750	0.56							X			X	X																E-143						
6+182. 0. RT		1	600	750	0.45							X			X	X																E-141						
6+182. 0. RT		1										X			X	X																SALVAGED SIGN TO BE MOUNTED ON NEW POST						
6+192. 0. RT	 	1	750	750	0.56							X			X	X																E-143						
		1	150	200	0.03																											E-138						
6+312. 0. LT		1	750	750	0.56							X			X	X																E-155						
		1	750	750	0.56																											E-153						
7+228. 0. RT		1	600	750	0.45							X			X	X																E-141						
7+258. 0. RT	 	1	750	750	0.56							X			X	X																E-143						
		1	150	200	0.03																											E-138						
7+371. 0. RT		1	600	750	0.45							X			X	X																E-141						
7+395. 0. RT	 	1	750	750	0.56							X			X	X																E-143						
		1	150	200	0.03																											E-138						
SHEET SUBTOTAL					5.36		1			</																												