

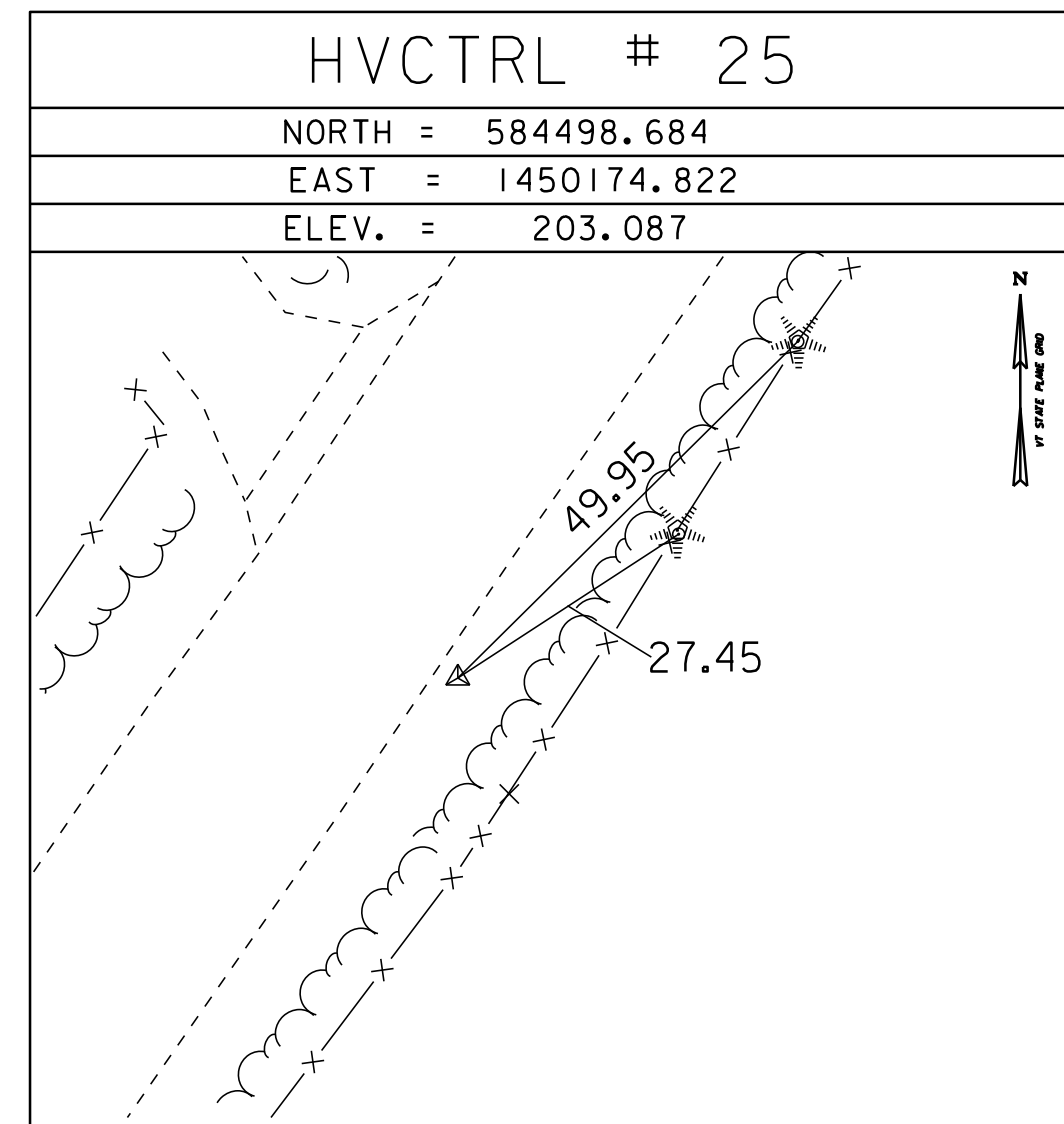
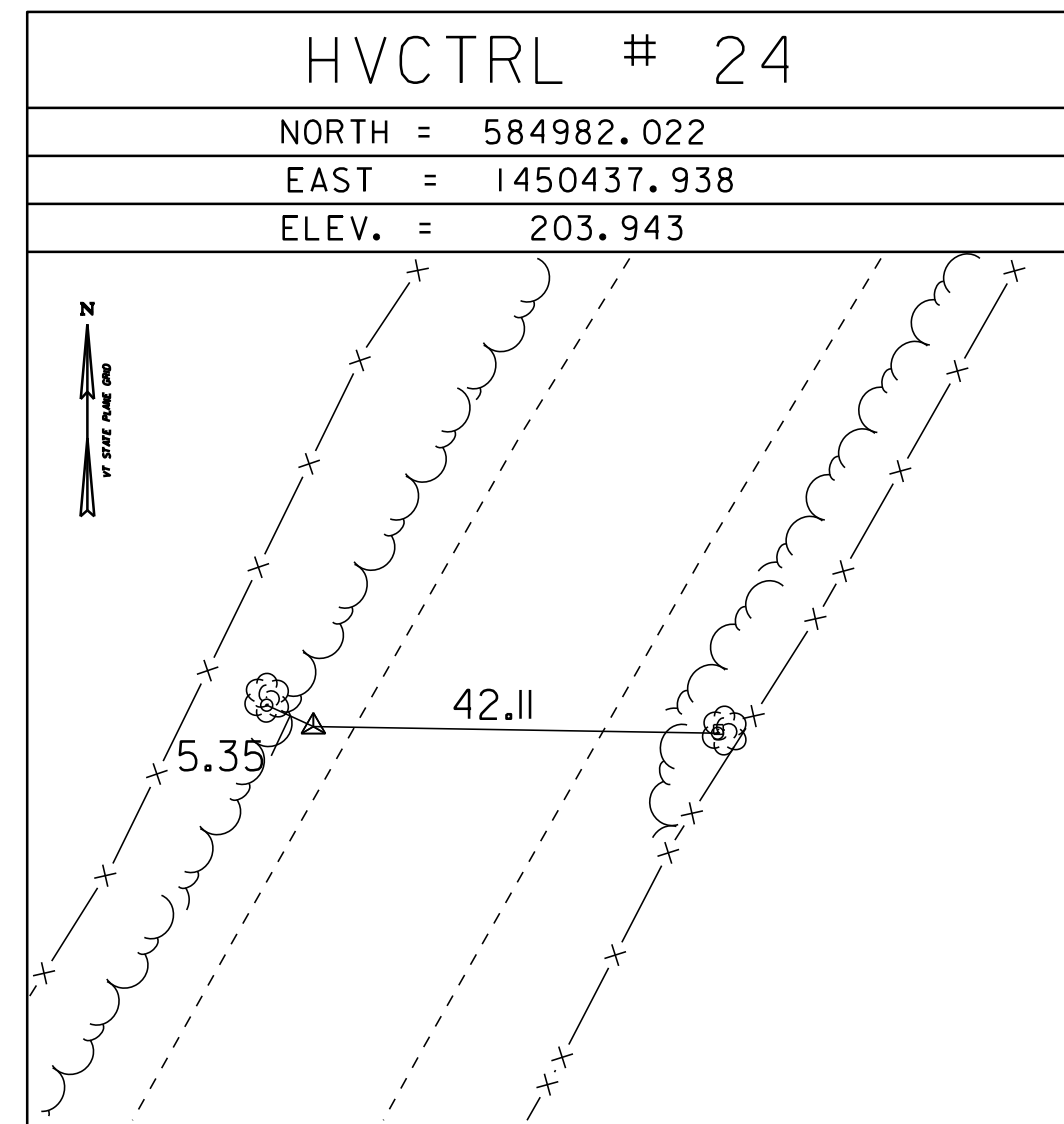
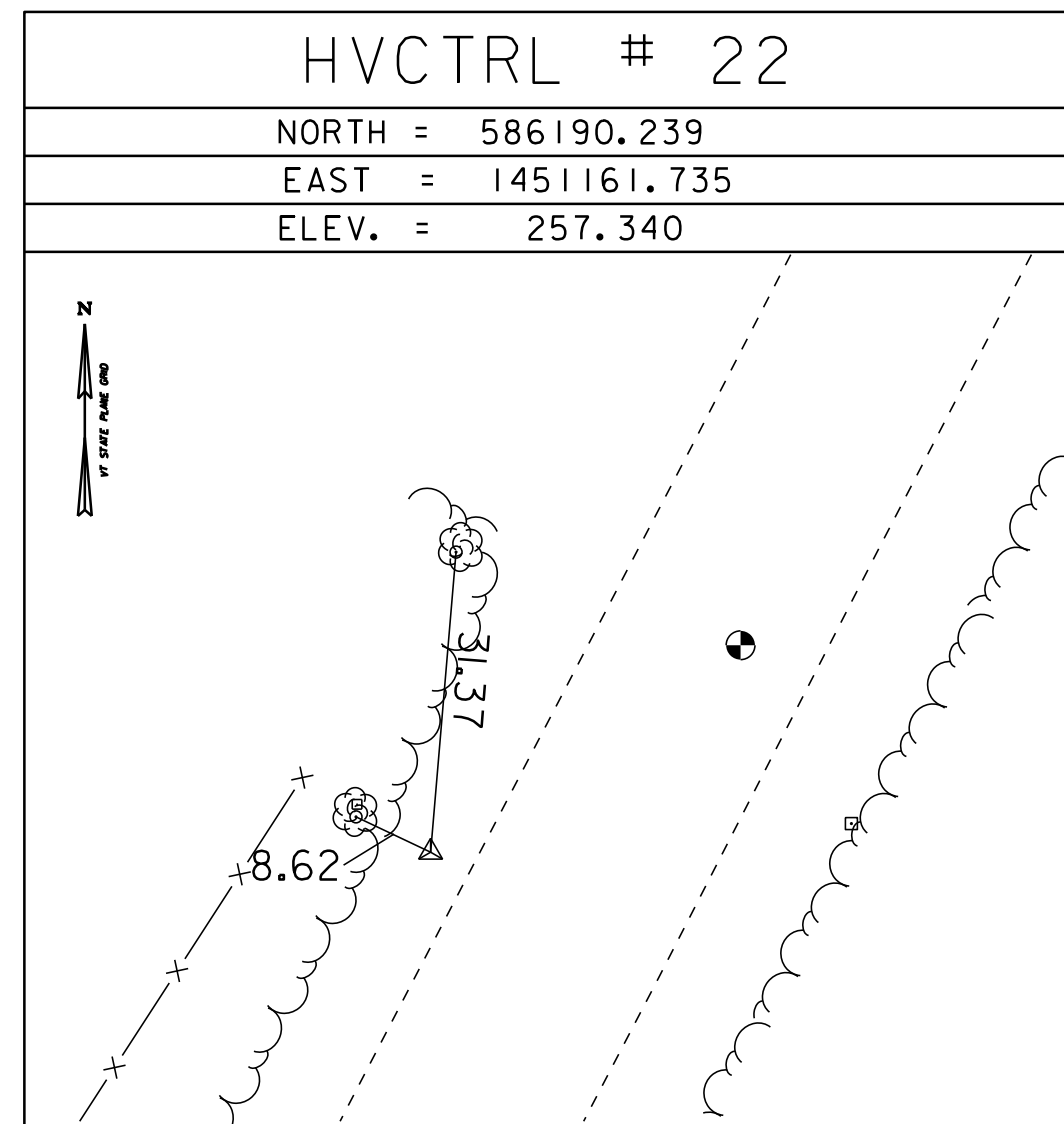
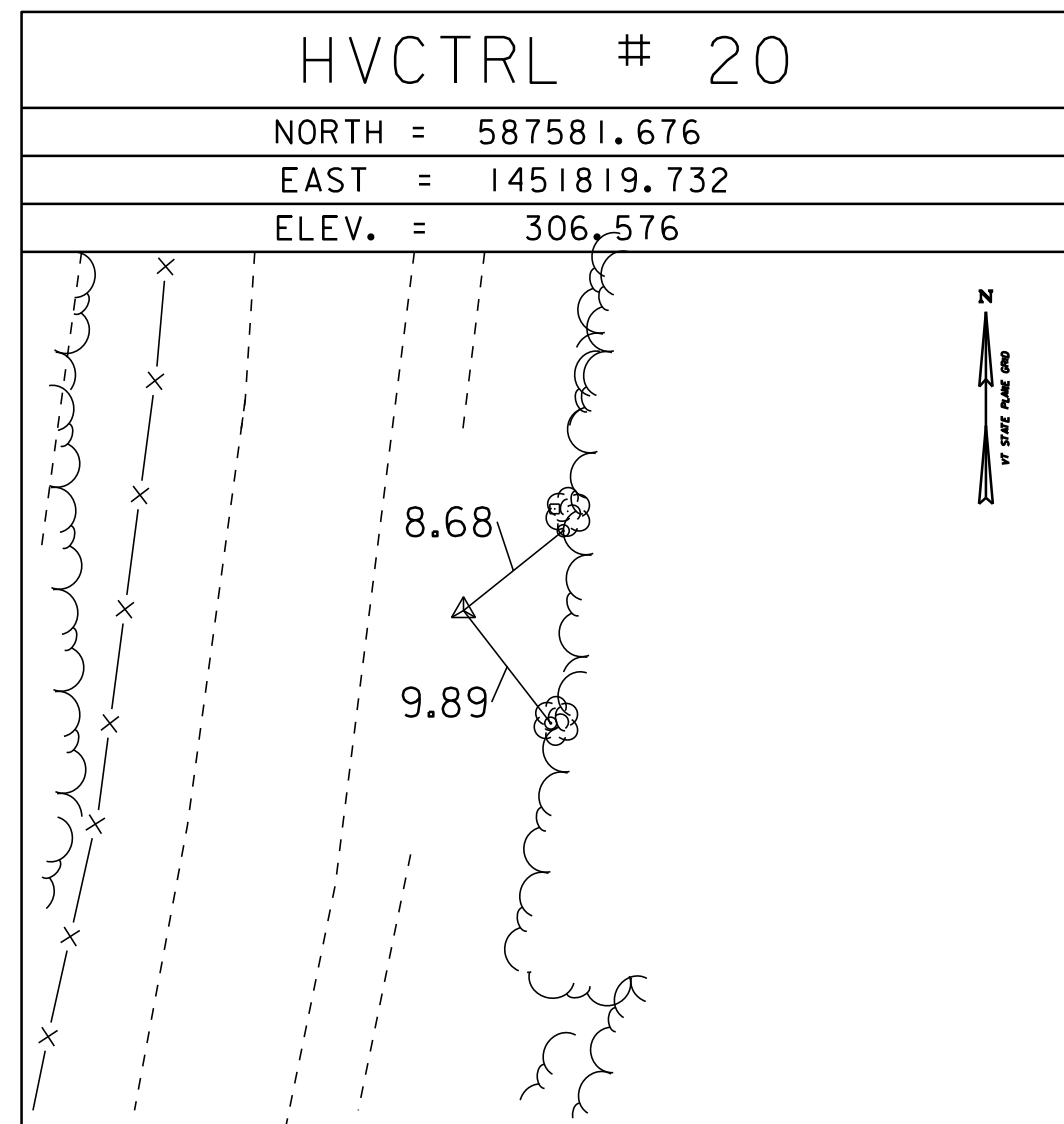
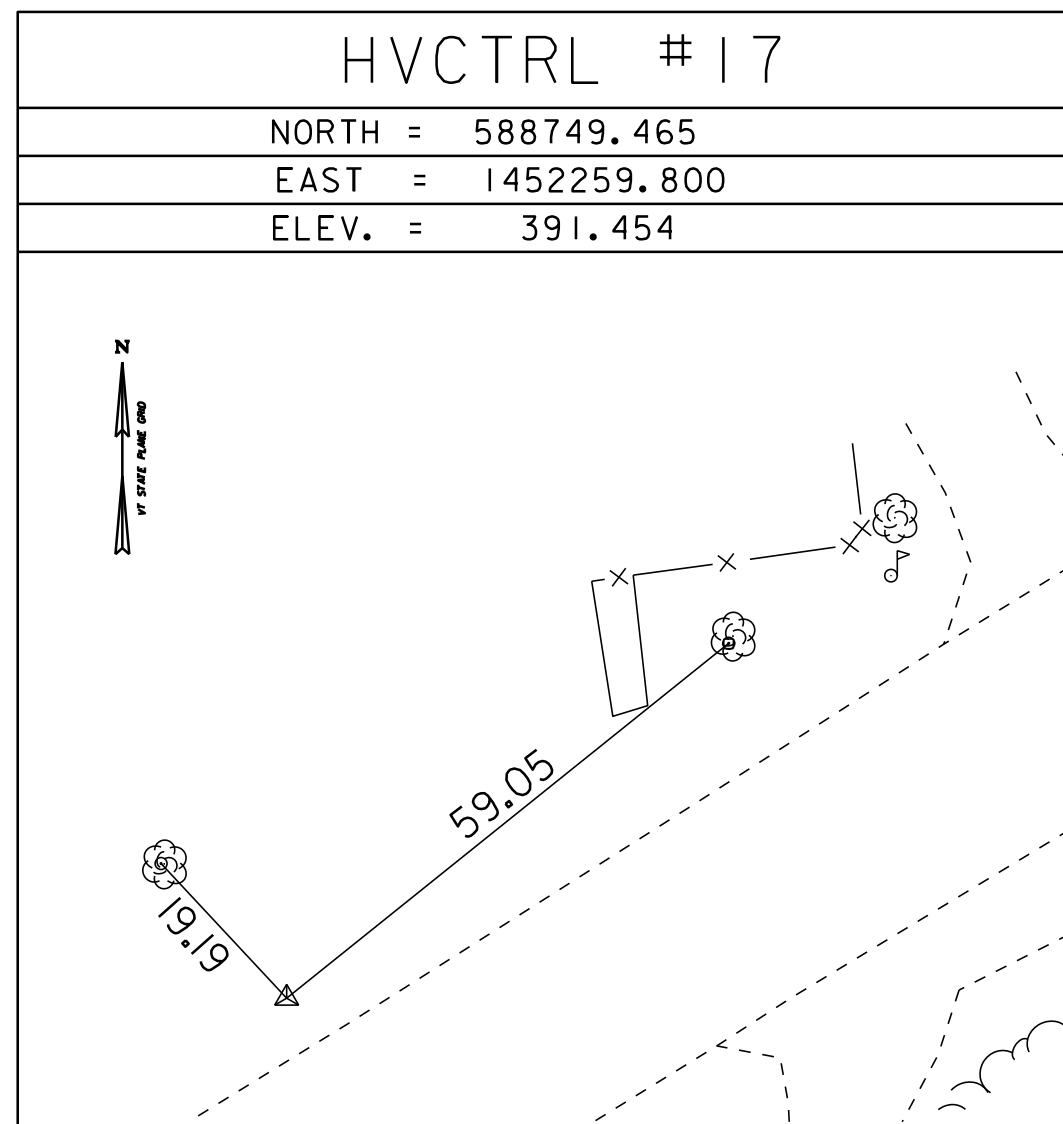
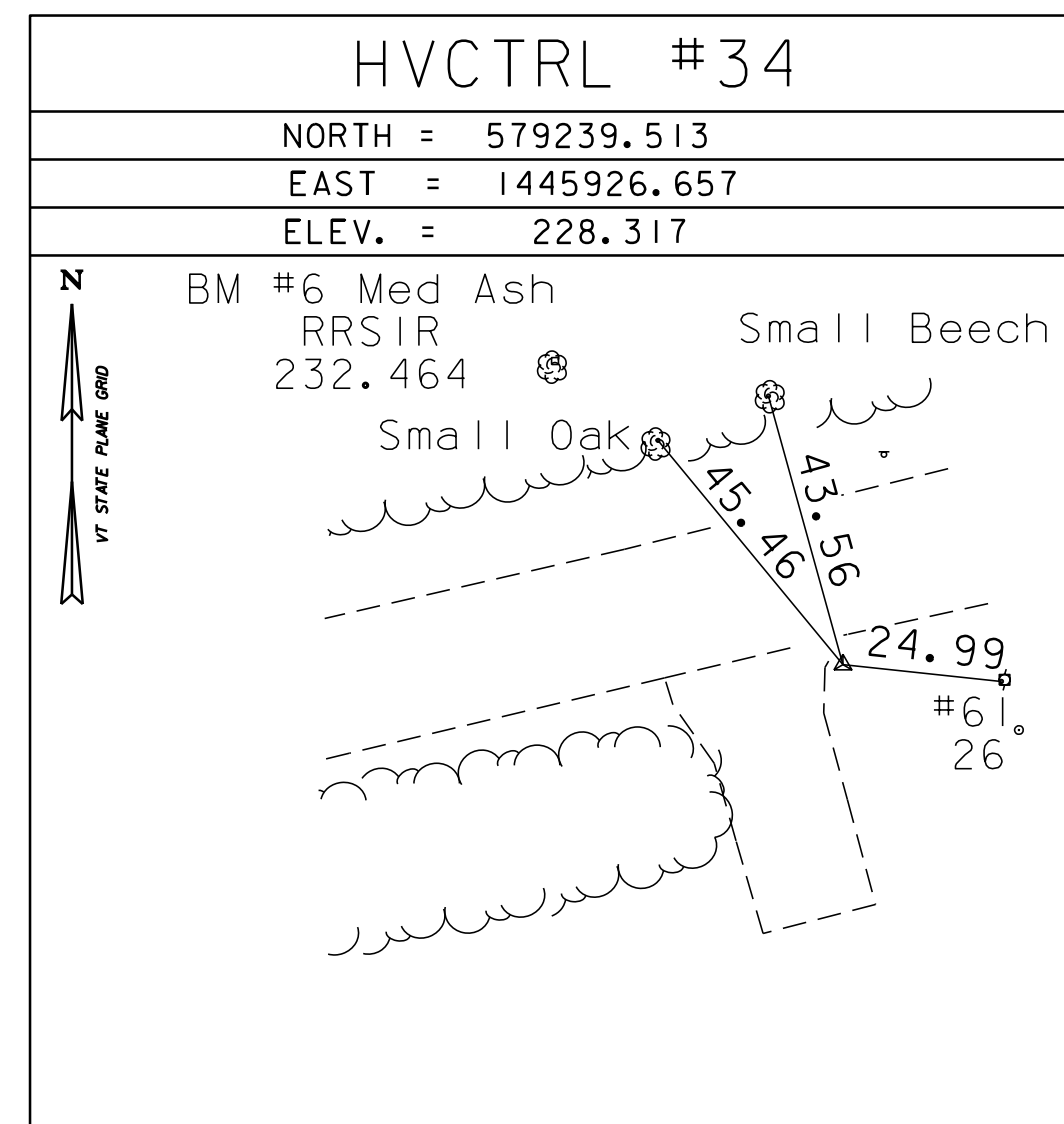
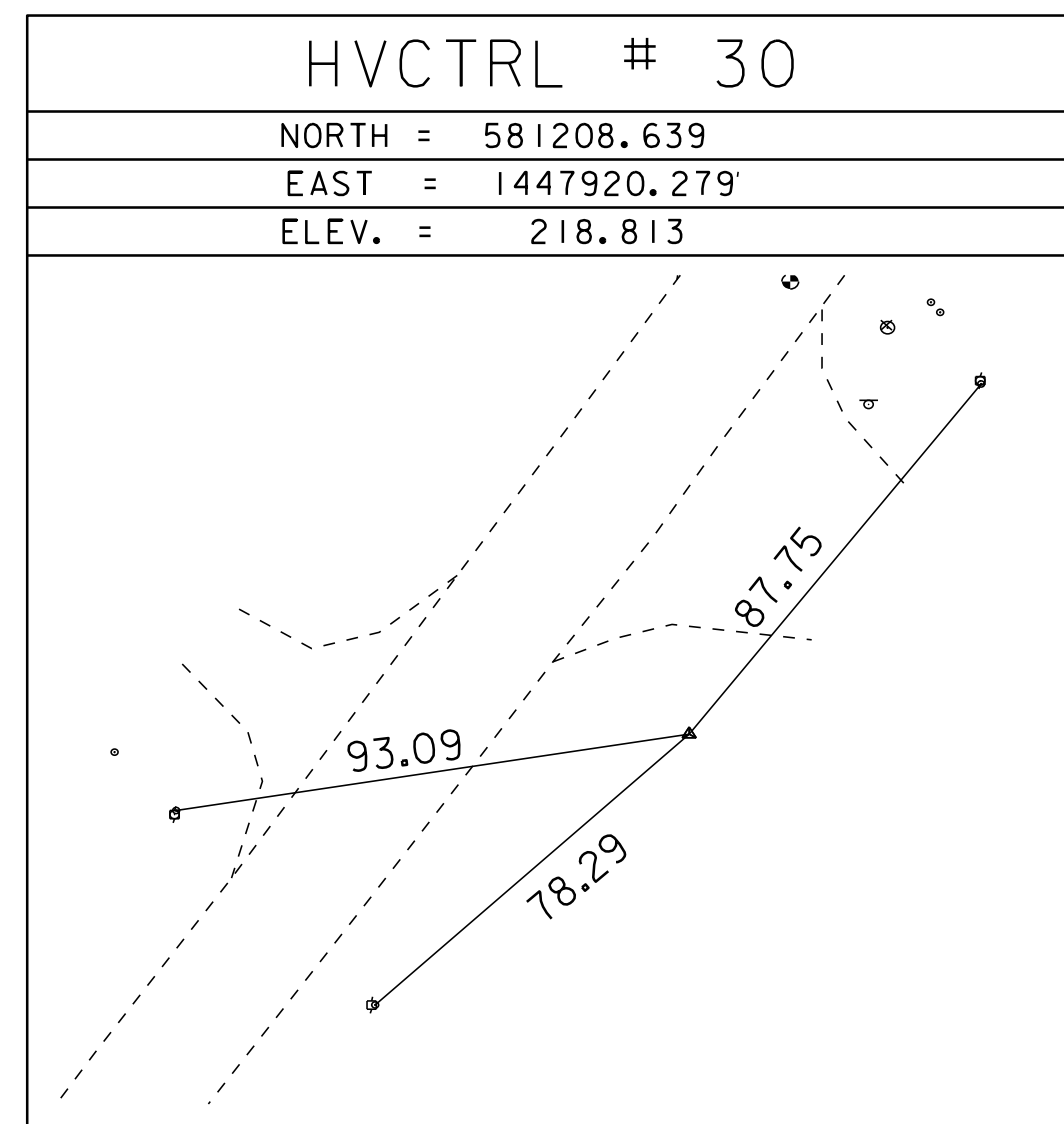
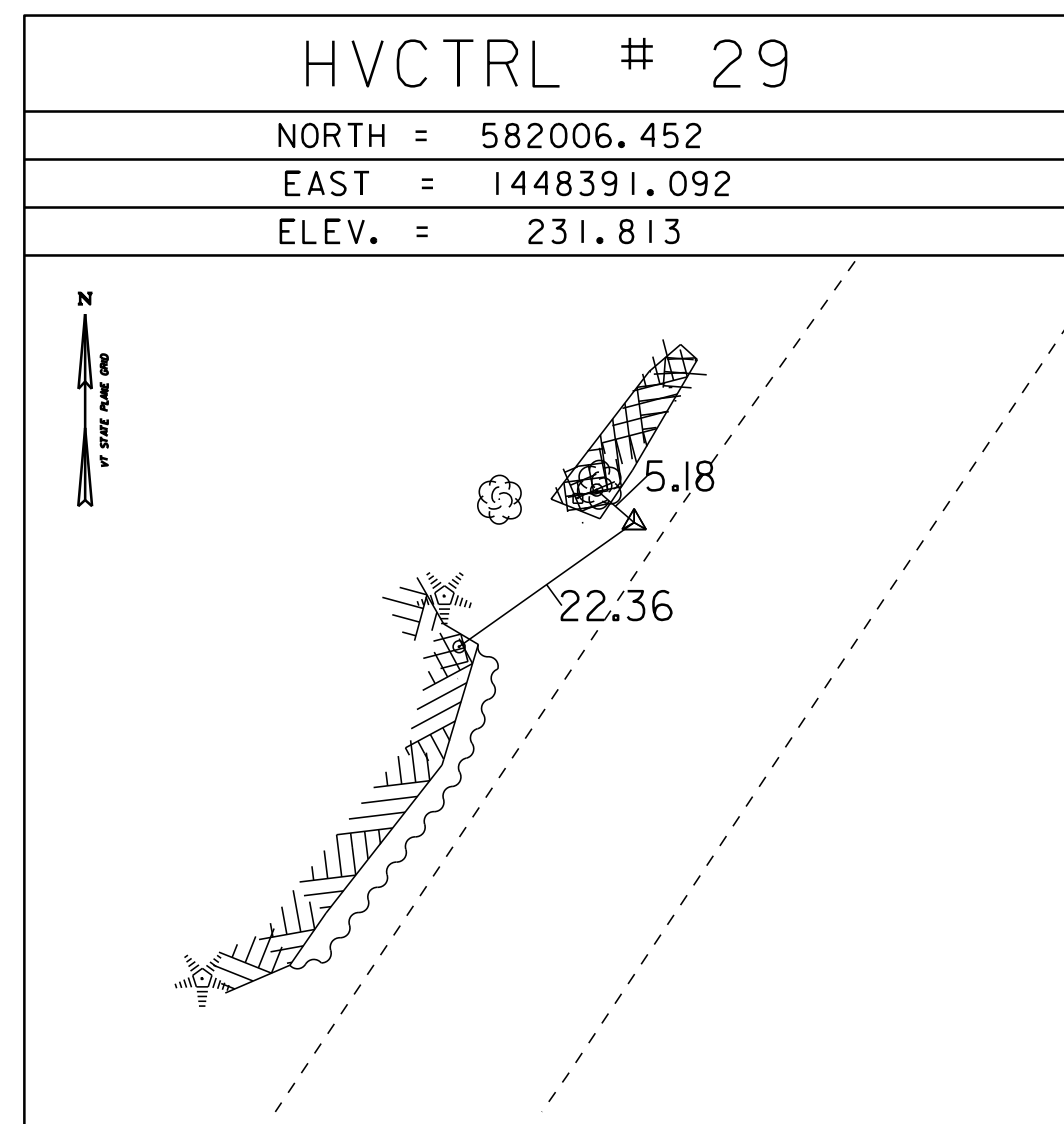







TRAVERSE TIES

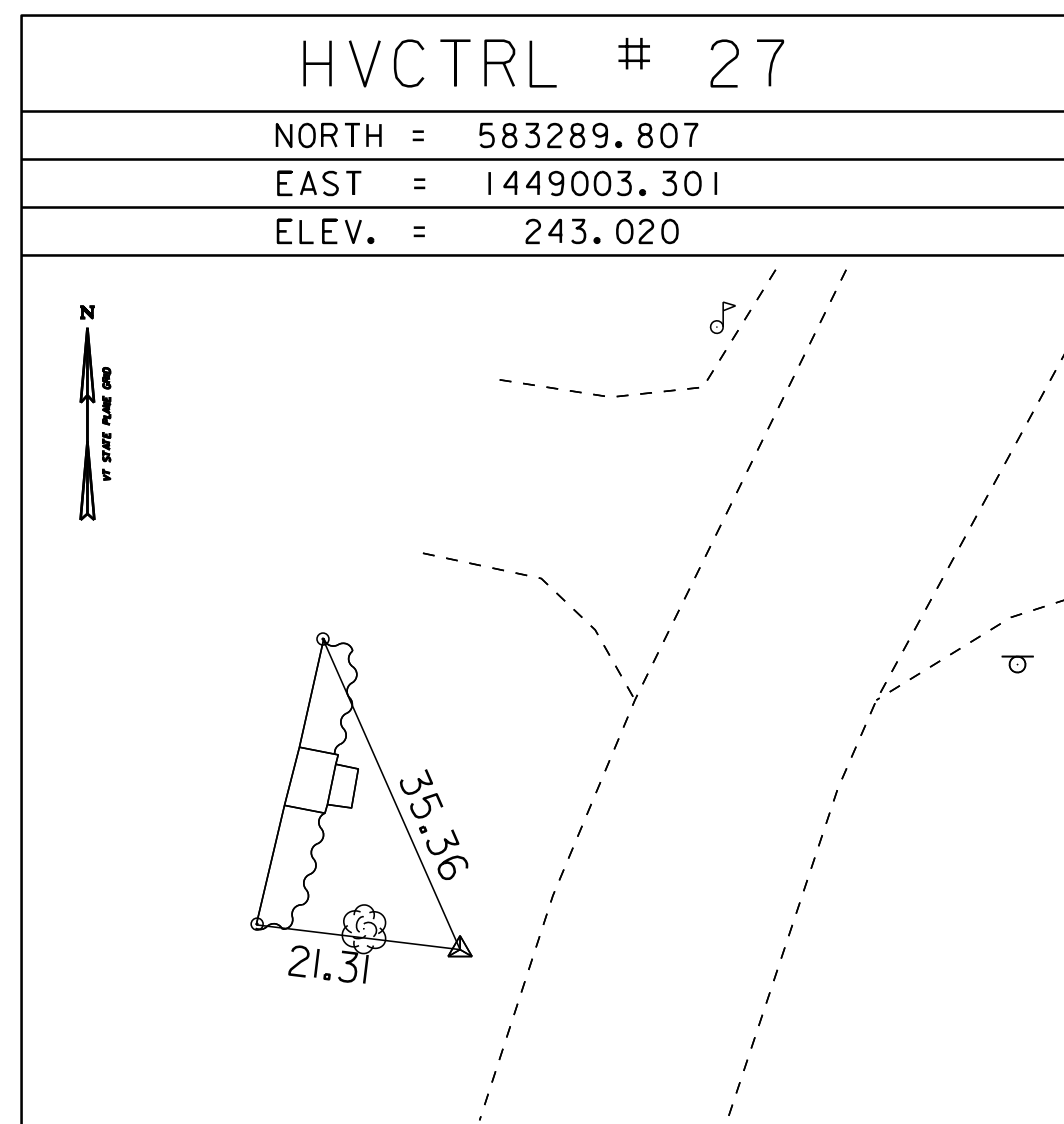

TRAVERSE TIES

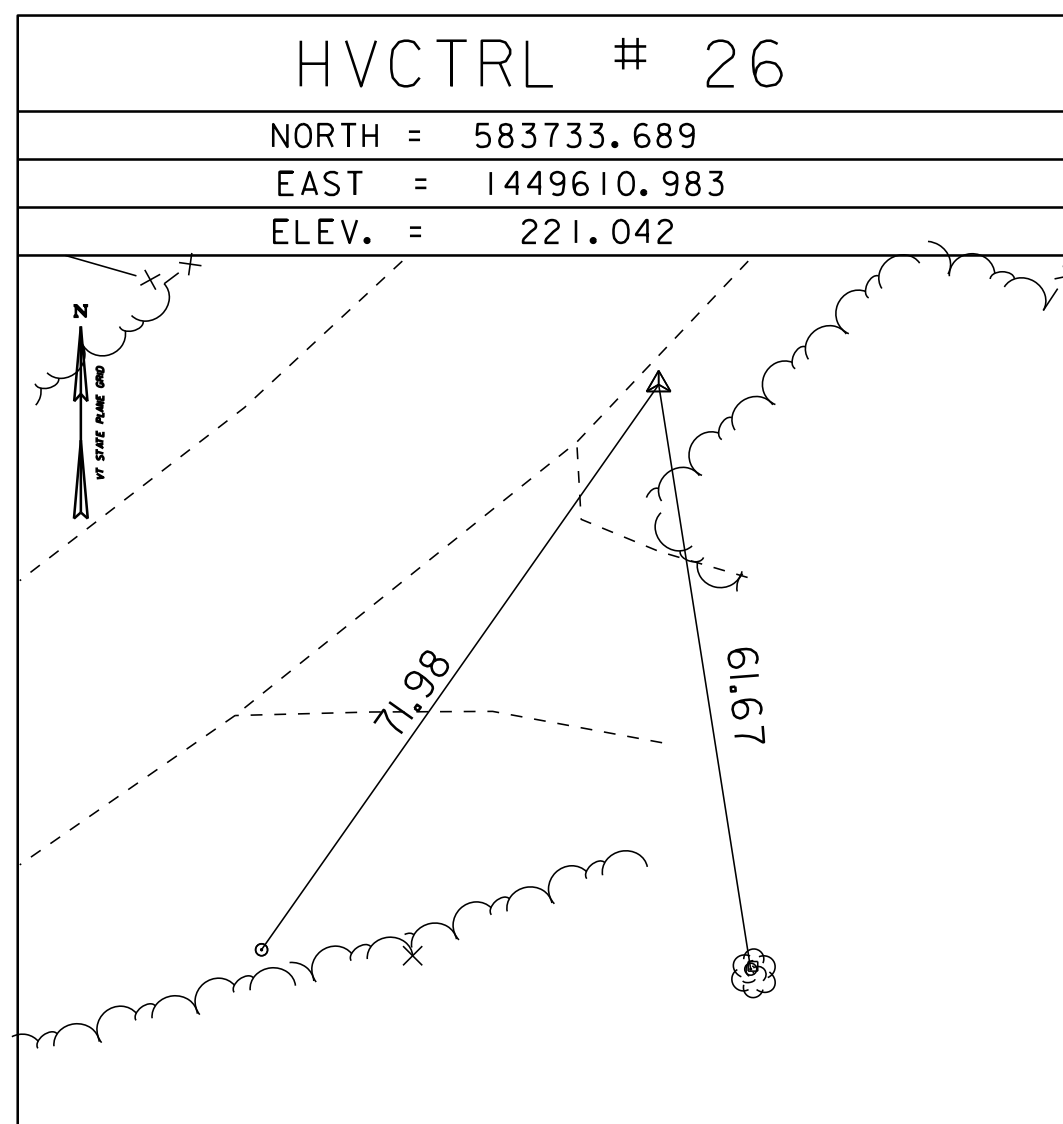

TRAVERSE TIES

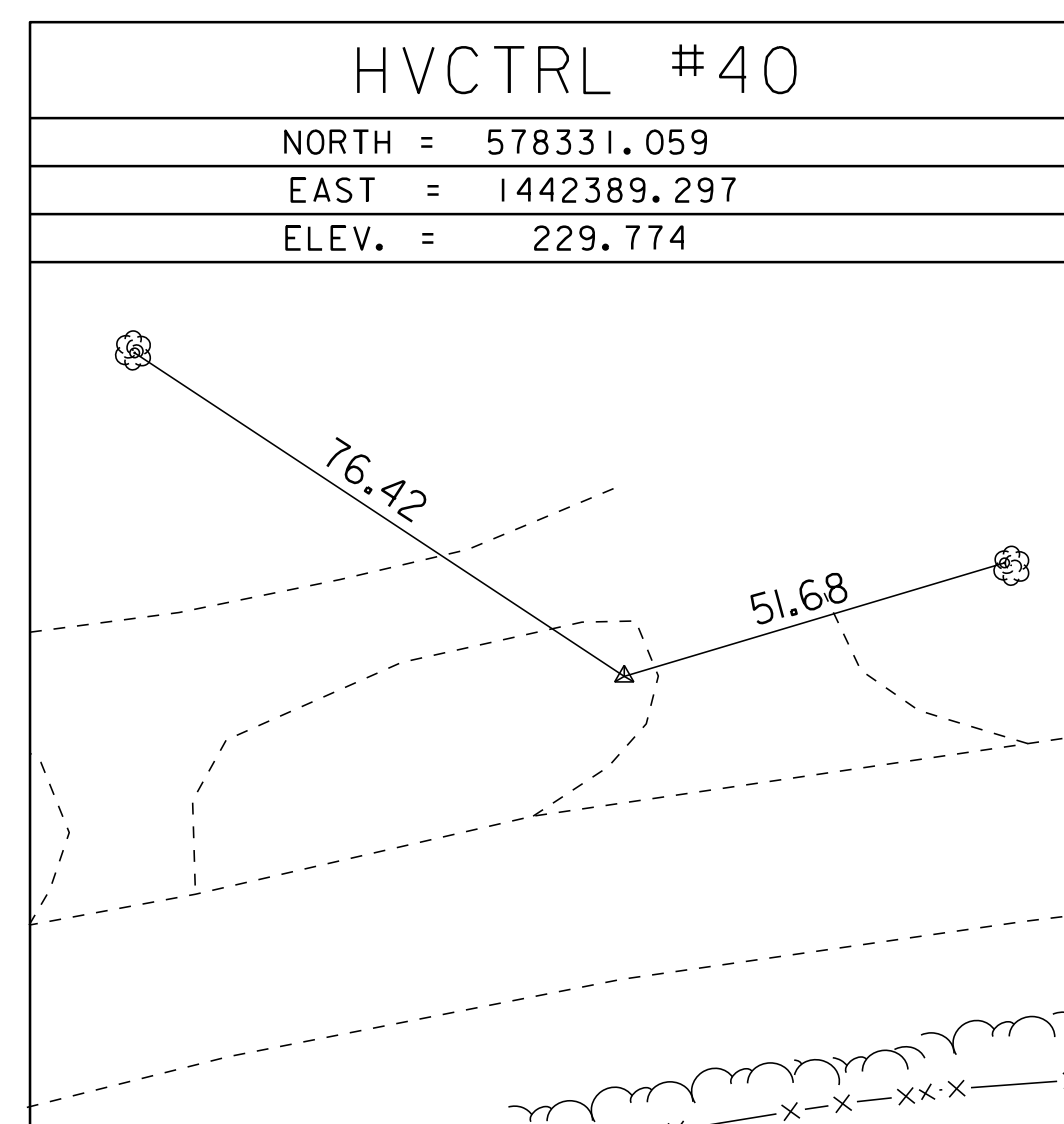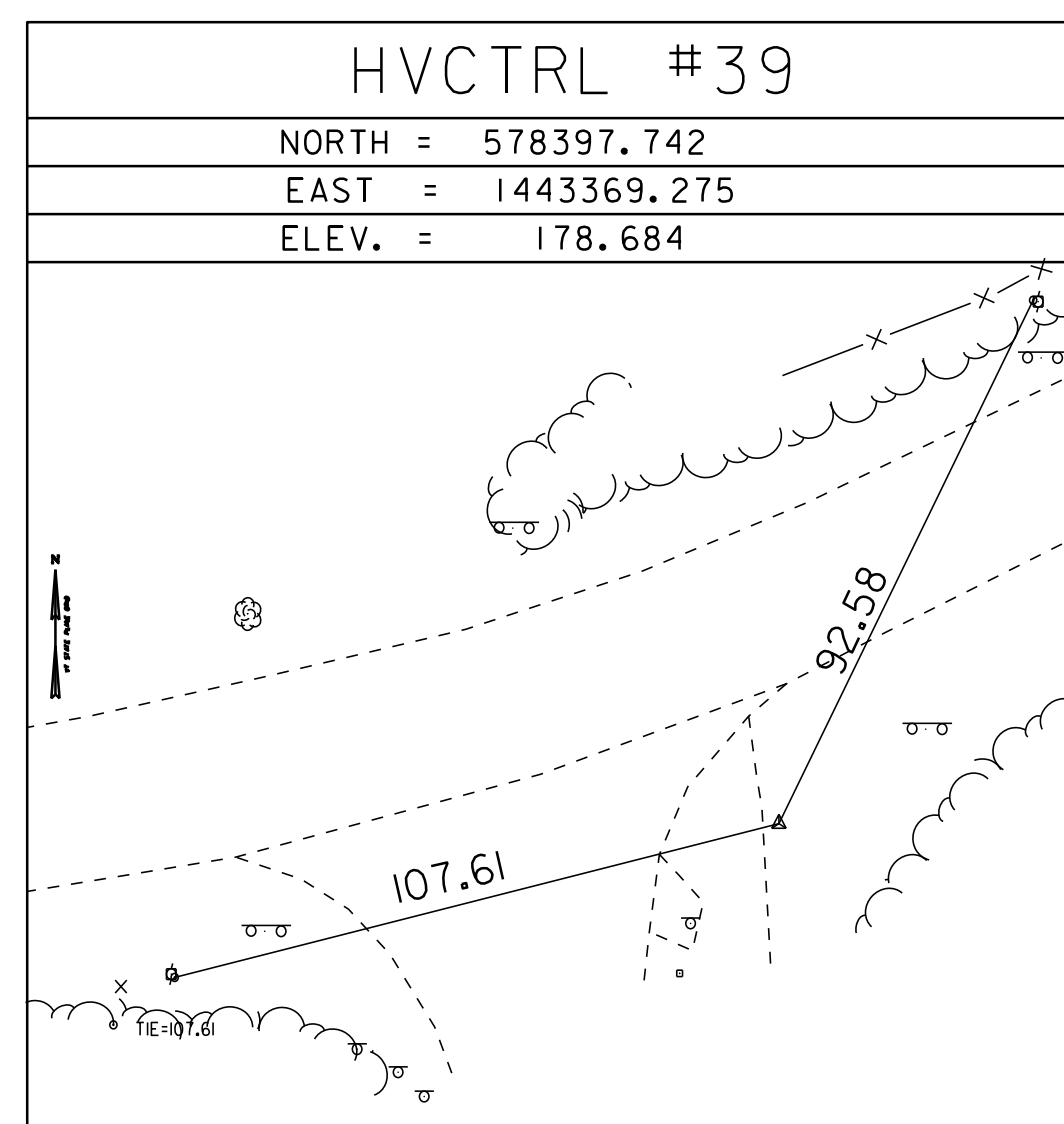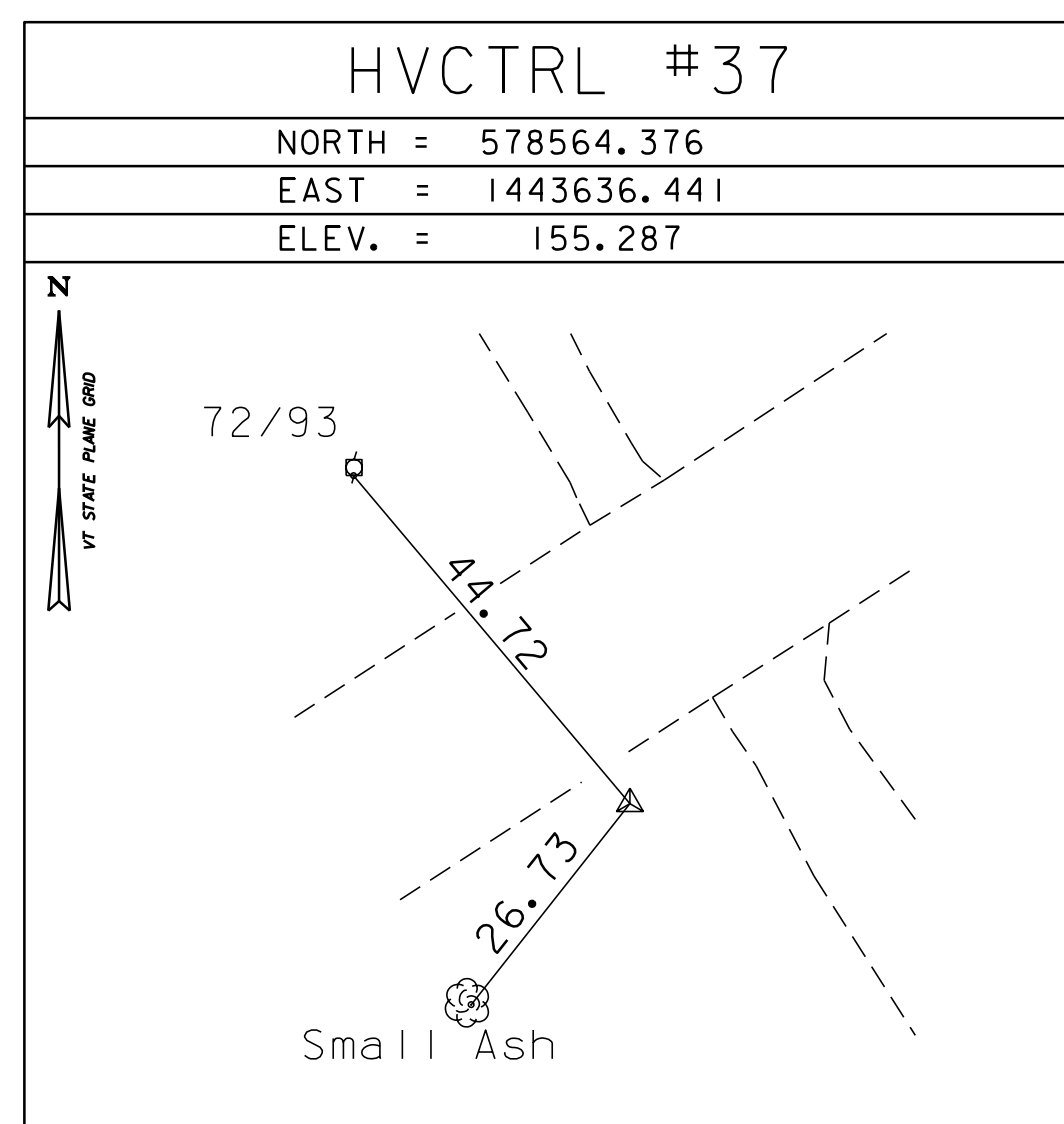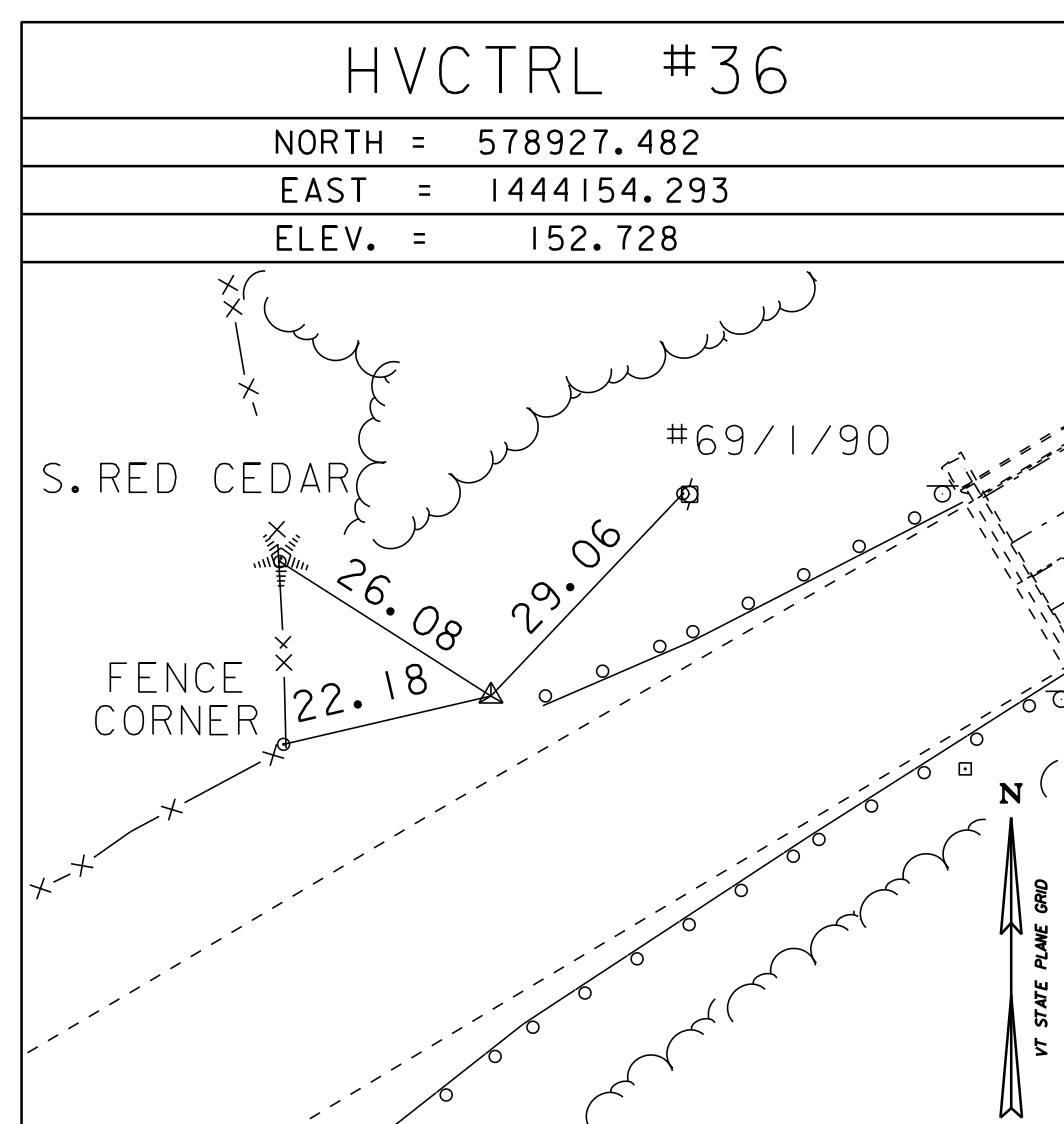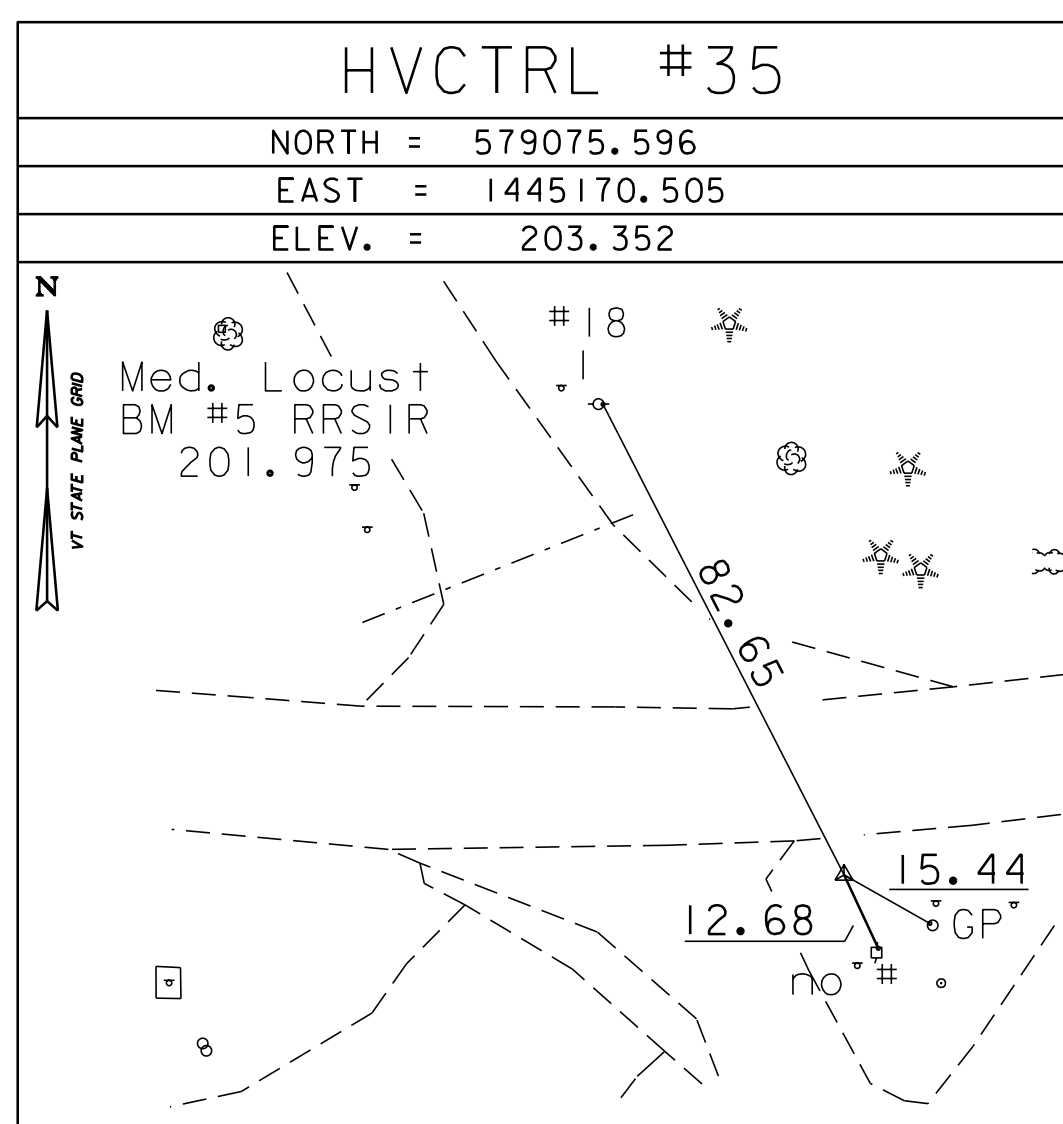

DATUM

NAVD 88

NAD 83

NOTE:
SURVEY INFORMATION PROVIDED BY VTRANS SURVEY DEPARTMENT

TIE SHEET 2

PROJECT NAME: ADDISON - NEW HAVEN
PROJECT NUMBER: STP 9632(1)

FILE NAME: p95B076.dgn
PROJECT LEADER: CDL
DESIGNED BY: SJL
PLOT FILE: p95B076_22.1

PLOT DATE: 3/13/2012
DRAWN BY: R. BULLOCK
CHECKED BY: EPD
SHEET 22 OF 186