



DURABLE 4 INCH WHITE LINE (SEE OPTION ITEMS)
 STA. 471+50 - STA. 477+50 (SOLID LT & RT)
 TEMPORARY 4 INCH WHITE LINE, PAINT
 STA. 471+50 - STA. 477+50 (SOLID LT & RT)

DURABLE 4 INCH YELLOW LINE (SEE OPTION ITEMS)
 STA. 471+50 - STA. 475+50 (DASHED LT, SOLID RT)
 STA. 475+50 - STA. 477+50 (SOLID LT & RT)
 TEMPORARY 4 INCH YELLOW LINE, PAINT
 STA. 471+50 - STA. 475+50 (DASHED LT, SOLID RT)
 STA. 475+50 - STA. 477+50 (SOLID LT & RT)

6 INCH UNDERDRAIN PIPE
~~STA. 471+50 - STA. 475+75 LT~~
 STA. 471+50 - STA. 475+75 RT
 STA. 476+25 - STA. 477+50 RT
 6 INCH UNDERDRAIN CARRIER PIPE
 STA. 471+75 RT STA. 475+75 RT
 STA. 473+00 LT STA. 475+75 LT
 STA. 476+25 RT

UNDERDRAIN FLUSHING BASIN
 STA. 471+75 RT STA. 475+75 RT
~~STA. 473+00 LT~~ ~~STA. 475+75 LT~~
 STA. 476+25 RT

CURVE #3
 DELTA = 3°27'41"
 D = 0°47'06"
 R = 7300.00'
 T = 220.57'
 L = 441.01'
 NORMAL CROWN

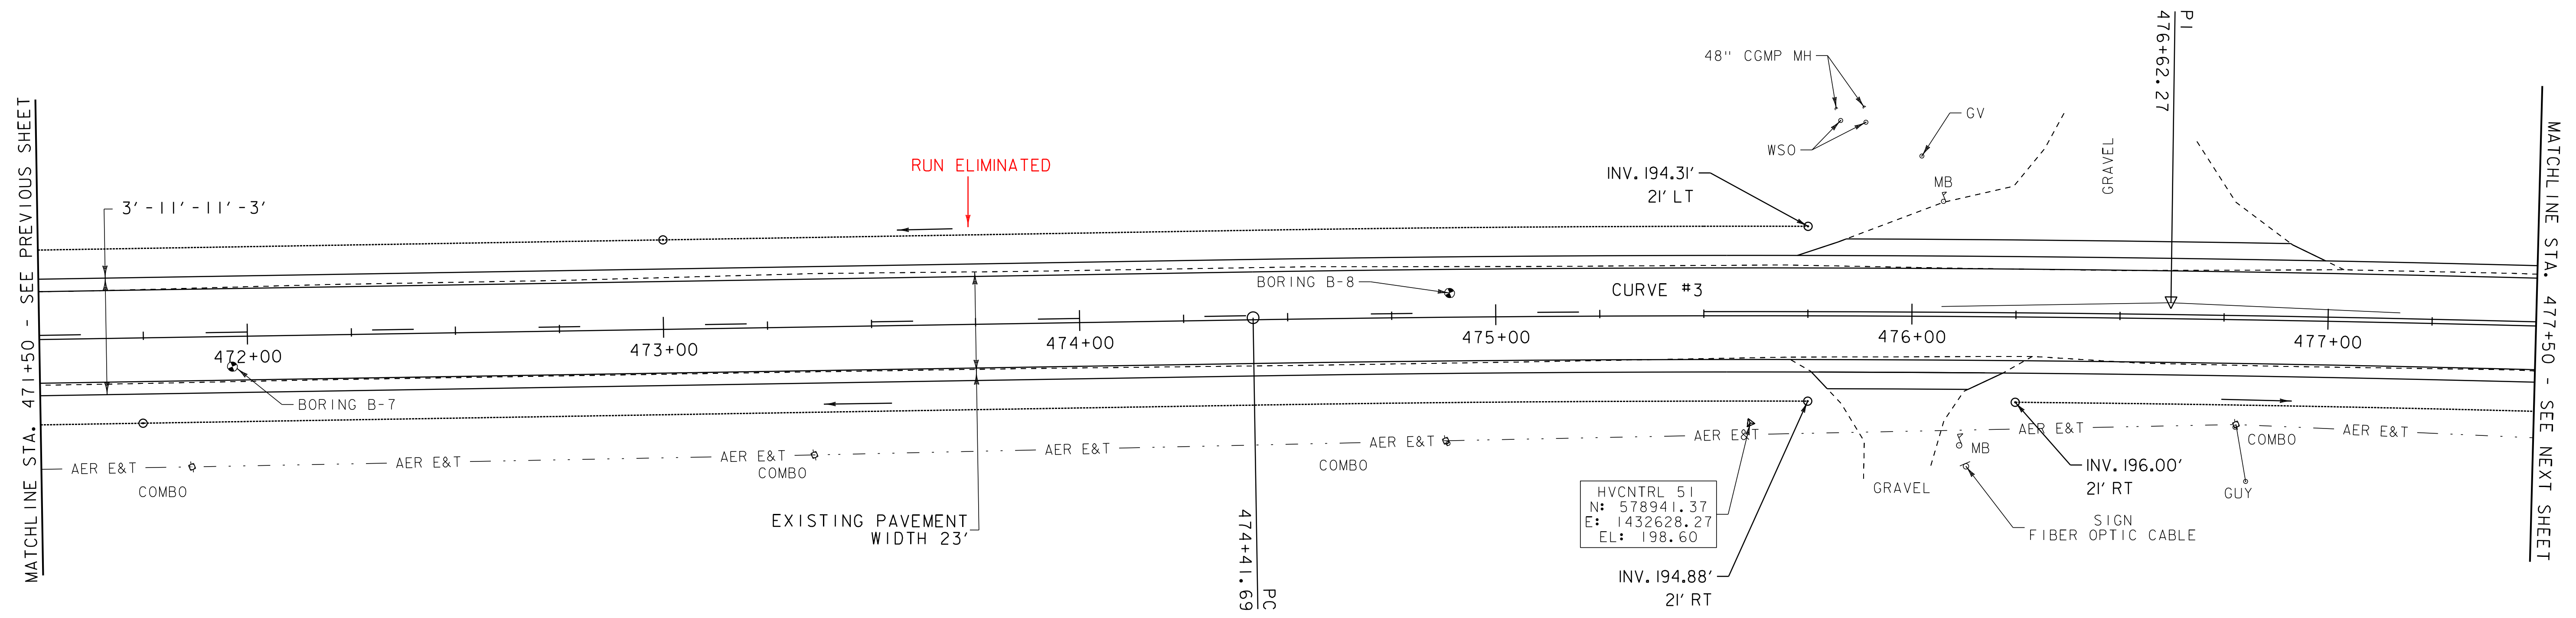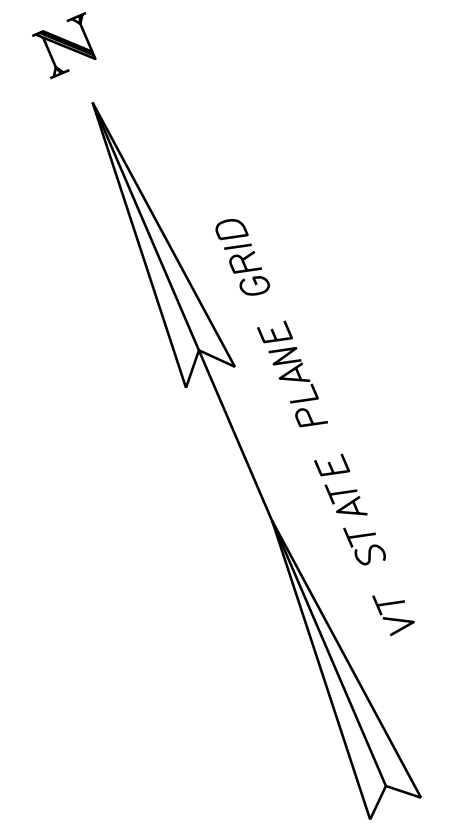

- LEGEND**
- SIGN
 - ⊕ HYDRANT
 - MANHOLE
 - ⊙ GATE VALVE
 - ⊙ GAS PIPELINE MARKER
 - ⊠ CATCH BASIN / DROP INLET
 - CURB INLET
 - ⊙ BORING LOCATION
 - ⊙ MAILBOX
 - ⊙ UTILITY POLE
 - ⊙ FLUSHING BASIN

- SIGN LEGEND**
- R = REMOVE
 - R&S = REMOVE AND SALVAGE
 - RET = RETAIN
 - S = SALVAGE
 - N = NEW
 - B-B = BACK TO BACK

DATUM
 NAVD 88
 NAD 83

SCALE 1" = 20'-0"
 20 0 20

PROJECT LAYOUT SHEET 6	PROJECT NAME: ADDISON - NEW HAVEN
	PROJECT NUMBER: STP 9632(1)
	FILE NAME: p95B076.dgn
PROJECT LEADER: CDL	PLOT DATE: 3/13/2012
DESIGNED BY: SJL	DRAWN BY: SJL
PLOT FILE: p95B076.29.i	CHECKED BY: EPD
	SHEET 29 OF 186