

DURABLE 4 INCH WHITE LINE (SEE OPTION ITEMS)  
 STA. 483+25 - STA. 488+75 (SOLID LT & RT)  
 (WITH EDGELINE BREAKS AT TH #5)  
 STA. 487+53 RT (EDGELINES TH #5)

TEMPORARY 4 INCH WHITE LINE, PAINT  
 STA. 483+25 - STA. 488+75 (SOLID LT & RT)  
 (WITH EDGELINE BREAKS AT TH #5)  
 STA. 487+53 RT (EDGELINES TH #5)

REMOVING SIGNS  
 AS SHOWN - 7

ERECTING SALVAGED SIGNS  
 AS SHOWN - 7

DURABLE 4 INCH YELLOW LINE (SEE OPTION ITEMS) N

STA. 483+25 - STA. 488+75 (SOLID LT & RT)  
 (WITH CENTERLINE BREAKS AT TH #5)  
 STA. 487+26 RT (CENTERLINE TH #5)  
 STA. 487+99 RT (CENTERLINE TH #5)


TEMPORARY 4 INCH YELLOW LINE, PAINT  
 STA. 483+25 - STA. 488+75 (SOLID LT & RT)  
 (WITH CENTERLINE BREAKS AT TH #5)  
 STA. 487+26 RT (CENTERLINE TH #5)  
 STA. 487+99 RT (CENTERLINE TH #5)

DURABLE 24 INCH STOP BAR (SEE OPTION ITEMS)


STA. 487+20 - STA. 487+30 RT (TH #5)  
 STA. 488+05 - STA. 488+13 RT (TH #5)

DURABLE LETTER OR SYMBOL (SEE OPTION ITEMS)

STA. 487+28 RT "STOP" (TH #5)  
 STA. 488+04 RT "STOP" (TH #5)

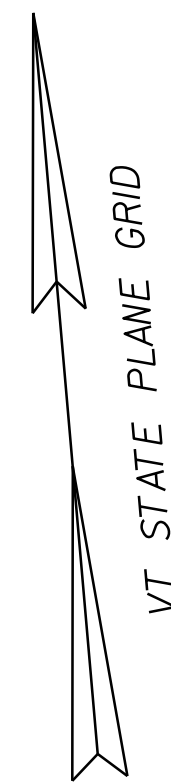

CURVE #4  
 DELTA = 32°37'43"  
 D = 10°48'38" (1) D = 9°18'59" (2)  
 R = 530.00' (1) R = 615.00' (2)  
 T = 160.24' (1) T = 172.29' (2)  
 L = 166.50' (1) L = 157.02' (2)  
 BANKING 0.070 FT/FT, 0.065 FT/FT  
 RUNOFF 140', 140' (35 MPH)  
 SEE SUPERELEVATION DIAGRAMS  
 FOR BANKING INFORMATION

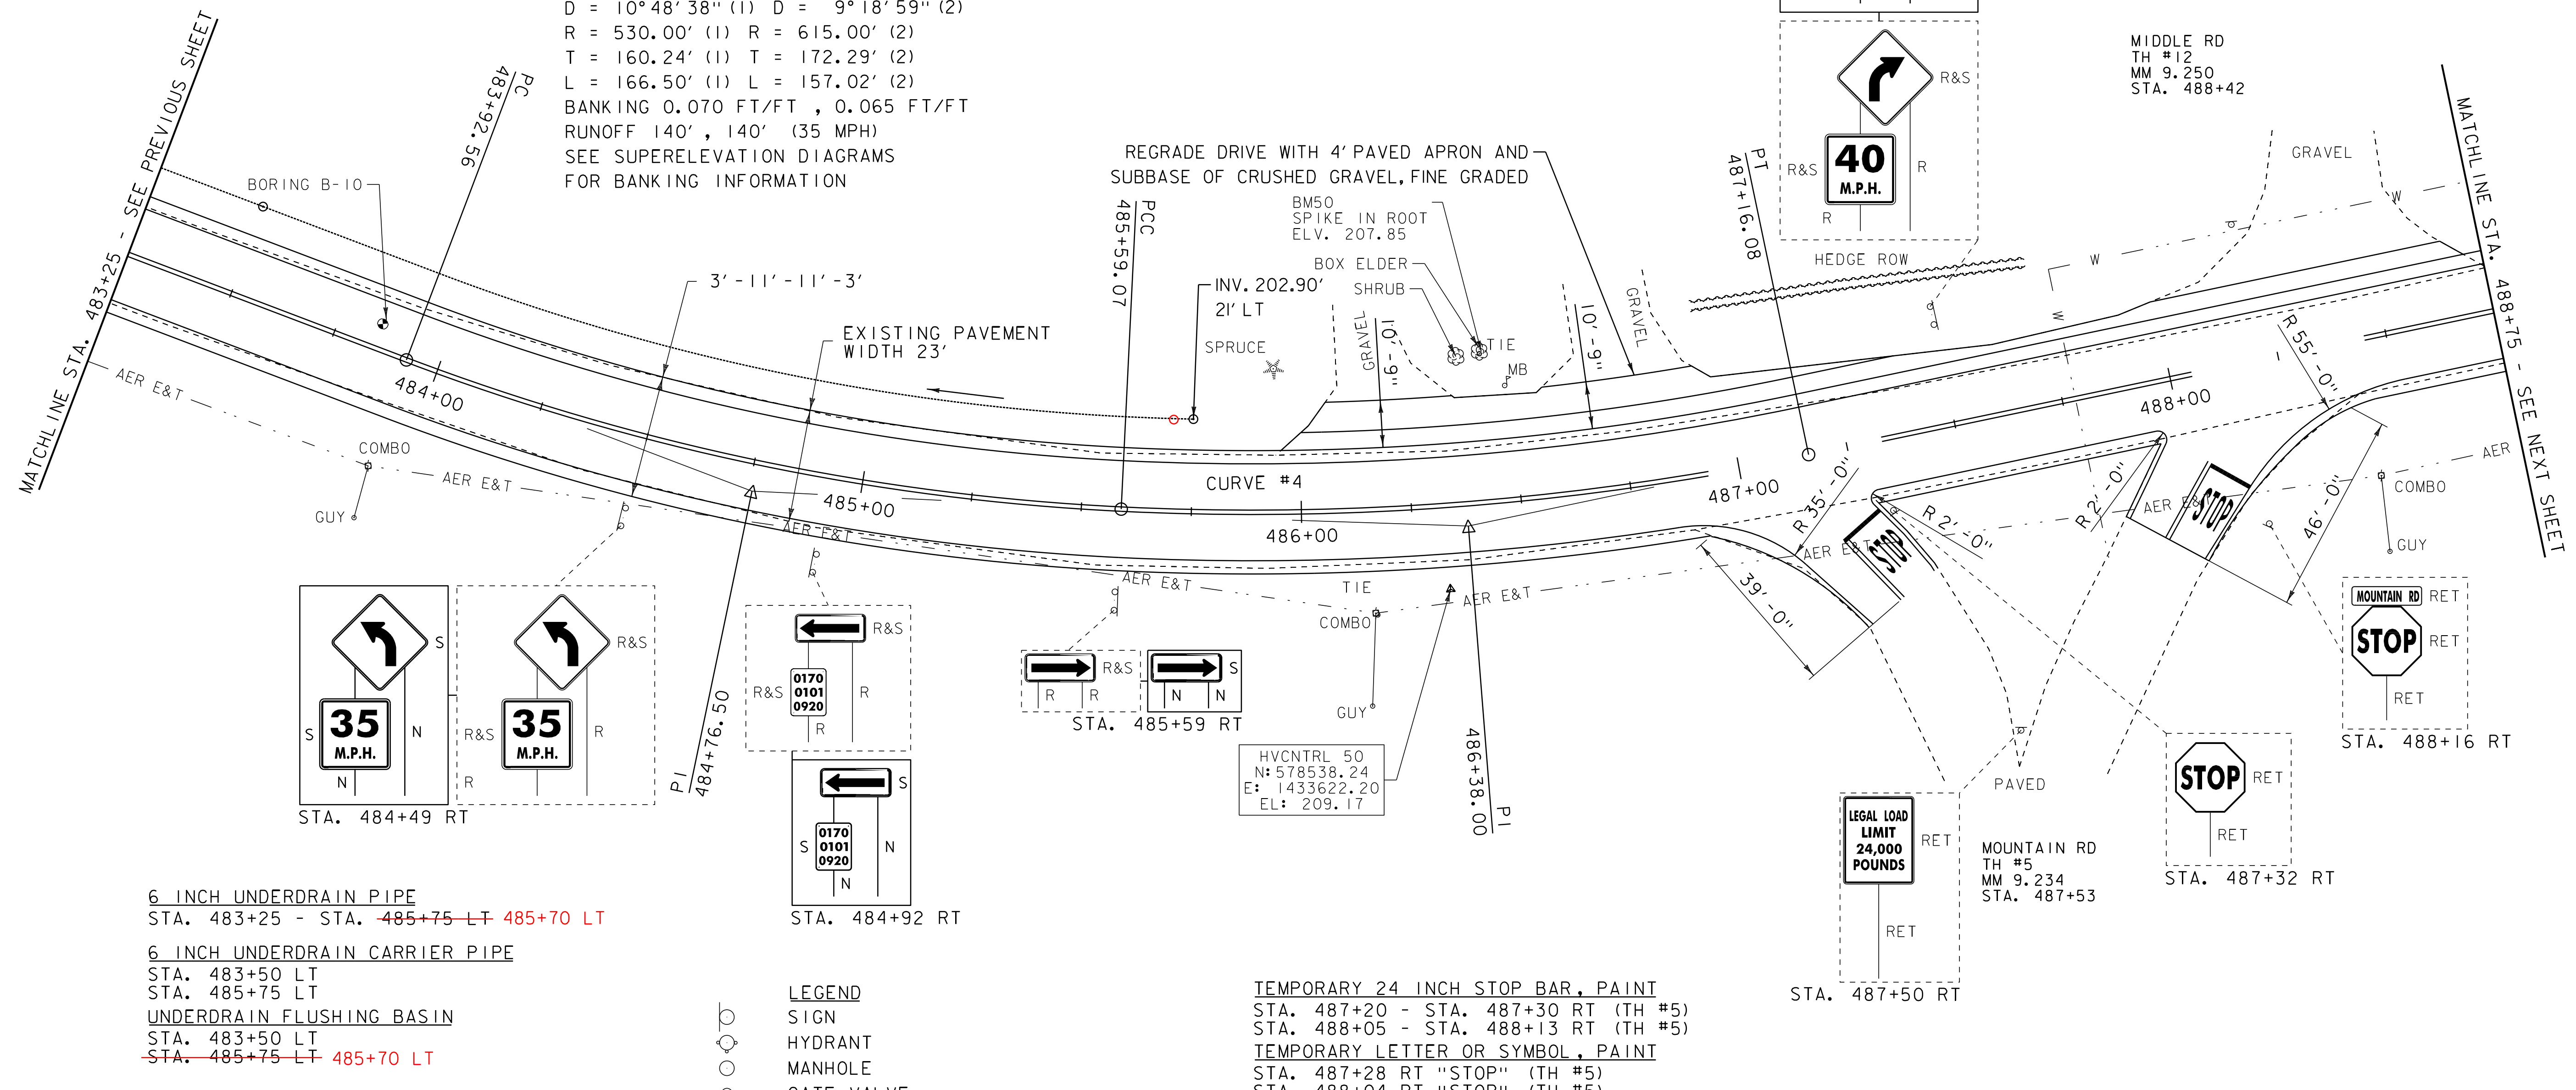

6 INCH UNDERDRAIN PIPE  
 STA. 483+25 - STA. 485+75 LT- 485+70 LT

6 INCH UNDERDRAIN CARRIER PIPE  
 STA. 483+50 LT  
 STA. 485+75 LT

UNDERDRAIN FLUSHING BASIN  
 STA. 483+50 LT  
 STA. 485+75 LT- 485+70 LT

- LEGEND**
- SIGN
  - HYDRANT
  - MANHOLE
  - GATE VALVE
  - GAS PIPELINE MARKER
  - CATCH BASIN / DROP INLET
  - CURB INLET
  - BORING LOCATION
  - MAILBOX
  - UTILITY POLE
  - FLUSHING BASIN

- SIGN LEGEND**
- R = REMOVE
  - R&S = REMOVE AND SALVAGE
  - RET = RETAIN
  - S = SALVAGE
  - N = NEW
  - B-B = BACK TO BACK

TEMPORARY 24 INCH STOP BAR, PAINT  
 STA. 487+20 - STA. 487+30 RT (TH #5)  
 STA. 488+05 - STA. 488+13 RT (TH #5)  
TEMPORARY LETTER OR SYMBOL, PAINT  
 STA. 487+28 RT "STOP" (TH #5)  
 STA. 488+04 RT "STOP" (TH #5)

DATUM  
 NAVD 88  
 NAD 83

SCALE 1" = 20'-0"  
 20 0 20

<b>PROJECT LAYOUT SHEET 8</b>	PROJECT NAME: ADDISON - NEW HAVEN
	PROJECT NUMBER: STP 9632(1)
	FILE NAME: p95B076.dgn
	PLOT DATE: 3/13/2012
PROJECT LEADER: CDL	DRAWN BY: SJL
DESIGNED BY: SJL	CHECKED BY: EPD
PLOT FILE: p95B076.31.1	SHEET 31 OF 186