

STEEL BEAM GUARDRAIL, GALVANIZED W/8 FEET POSTS
 STA. 493+20 - STA. 494+50 RT
 STA. ~~494+24.25~~ - STA. 494+50 LT
 494+29

ANCHOR FOR STEEL BEAM RAIL
 STA. 493+20 RT
 STA. ~~494+24.25~~ LT
 494+29

DURABLE 4 INCH WHITE LINE (SEE OPTION ITEMS)
 STA. 488+75 - STA. 494+50 (SOLID LT & RT)

TEMPORARY 4 INCH WHITE LINE, PAINT
 STA. 488+75 - STA. 494+50 (SOLID LT & RT)

DURABLE 4 INCH YELLOW LINE (SEE OPTION ITEMS)
 STA. 488+75 - STA. 489+00 (SOLID LT & RT)
 STA. 489+00 - STA. 494+50 (SOLID LT, DASHED RT)

TEMPORARY 4 INCH YELLOW LINE, PAINT
 STA. 488+75 - STA. 489+00 (SOLID LT & RT)
 STA. 489+00 - STA. 494+50 (SOLID LT, DASHED RT)



REMOVING SIGNS
 AS SHOWN - 2

ERECTING SALVAGED SIGNS
 AS SHOWN - 2

6 INCH UNDERDRAIN PIPE
 STA. 490+50 - STA. 494+50 LT
 6 INCH UNDERDRAIN CARRIER PIPE
 STA. 490+50 LT
 STA. 492+62 LT

6" UNDERDRAIN PIPE
 493+00 - 494+50 RT

UNDERDRAIN FLUSHING BASIN
 STA. 490+50 LT
 STA. ~~492+62~~ LT
 492+80 LT

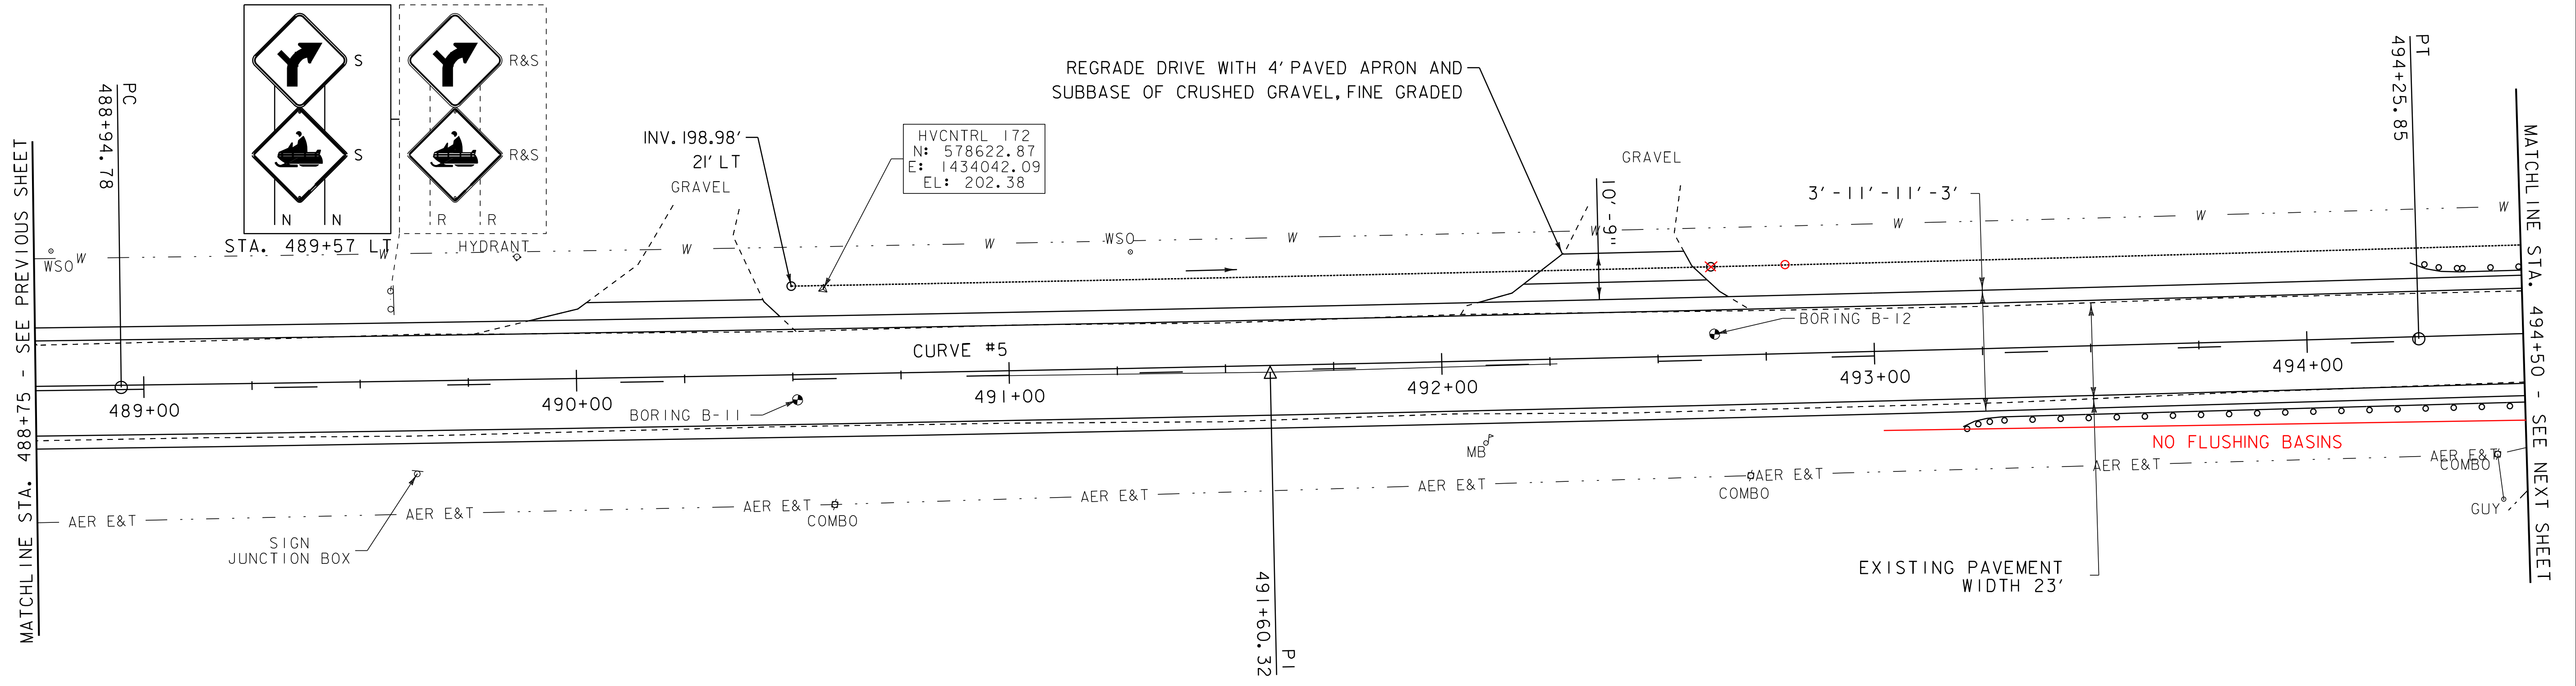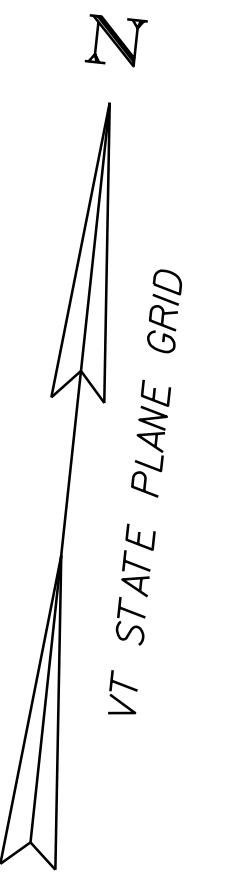

HVCNTRL 172
 N: 578622.87
 E: 1434042.09
 EL: 202.38

REGRADE DRIVE WITH 4' PAVED APRON AND
 SUBBASE OF CRUSHED GRAVEL, FINE GRADED

GRAVEL

3' - 11' - 11' - 3'

BORING B-12

CURVE #5

NO FLUSHING BASINS

EXISTING PAVEMENT
 WIDTH 23'

CURVE #5
 DELTA = 0° 54' 30"
 D = 0° 10' 16"
 R = 33500.00'
 T = 265.54'
 L = 531.08'
 NORMAL CROWN

ENVIRONMENTALLY SENSITIVE LOCATIONS:


NO.	LIMITS	POS.	TYPE
4.	STA. 493+50 - STA. 494+50	LT	EM - WET MEADOW
5.	STA. 494+00 - STA. 494+50	RT	EM - WET MEADOW

KEY:
 EM - EMERGENT WETLAND
 FO - FORESTED WETLAND
 SS - SCRUB-SHRUB WETLAND

- LEGEND**
- SIGN
 - HYDRANT
 - MANHOLE
 - GATE VALVE
 - GAS PIPELINE MARKER
 - CATCH BASIN / DROP INLET
 - CURB INLET
 - BORING LOCATION
 - MAILBOX
 - UTILITY POLE
 - FLUSHING BASIN

- SIGN LEGEND**
- R = REMOVE
 - R&S = REMOVE AND SALVAGE
 - RET = RETAIN
 - S = SALVAGE
 - N = NEW
 - B-B = BACK TO BACK

DATUM
 NAVD 88
 NAD 83

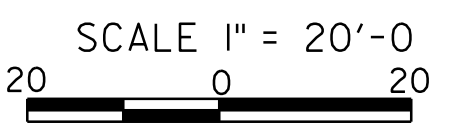

PROJECT LAYOUT SHEET 9	PROJECT NAME: ADDISON - NEW HAVEN	PLOT DATE: 3/13/2012
	PROJECT NUMBER: STP 9632(1)	DRAWN BY: SJL
	FILE NAME: p95B076.dgn	CHECKED BY: EPD
	DESIGNED BY: SJL	SHEET 32 OF 186
	PLOT FILE: p95B076_32.i	