

STEEL BEAM GUARDRAIL, GALVANIZED W/8 FEET POSTS  
 STA. 494+50 - STA. ~~494+80.5~~ LT 494+85.25  
 STA. 494+50 - STA. 494+63.75 RT  
 STA. 494+88.75 - STA. 495+45 RT  
~~STA. 495+05.5 - STA. 496+49.25~~ LT 495+10.25 - 496+54 RT

STEEL BEAM GUARDRAIL,  
 GALVANIZED/NESTED W/8 FEET POSTS  
 STA. 494+63.75 - STA. 494+88.75 RT  
~~STA. 494+80.5 - STA. 495+05.5~~ LT 494+85.25 - 495+10.25 LT

ANCHOR FOR STEEL BEAM RAIL  
 STA. 495+45 RT  
~~STA. 496+49.25~~ LT 496+54 LT

STONE FILL, TYPE I  
 STA. 494+75 - STA. 496+40 LT

GRUBBING MATERIAL  
 STA. 494+75 - STA. 496+40 LT

GEOTEXTILE FOR SILT FENCE  
 STA. 494+75 - STA. 496+40 LT  
 INV. 178.68

GEOTEXTILE UNDER STONE FILL  
 STA. 494+75 - STA. 496+40 LT

DURABLE 4 INCH WHITE LINE (SEE OPTION ITEMS)  
 STA. 494+50 - STA. 500+25 (SOLID LT & RT)




TEMPORARY 4 INCH WHITE LINE, PAINT  
 STA. 494+50 - STA. 500+25 (SOLID LT & RT)

DURABLE 4 INCH YELLOW LINE (SEE OPTION ITEMS)  
 STA. 494+50 - STA. 497+50 (SOLID LT, DASHED RT)  
 STA. 497+50 - STA. 500+25 (DASHED)

TEMPORARY 4 INCH YELLOW LINE, PAINT  
 STA. 494+50 - STA. 497+50 (SOLID LT, DASHED RT)  
 STA. 497+50 - STA. 500+25 (DASHED)

REMOVING SIGNS  
 AS SHOWN - 2

ERECTING SALVAGED SIGNS  
 AS SHOWN - 2

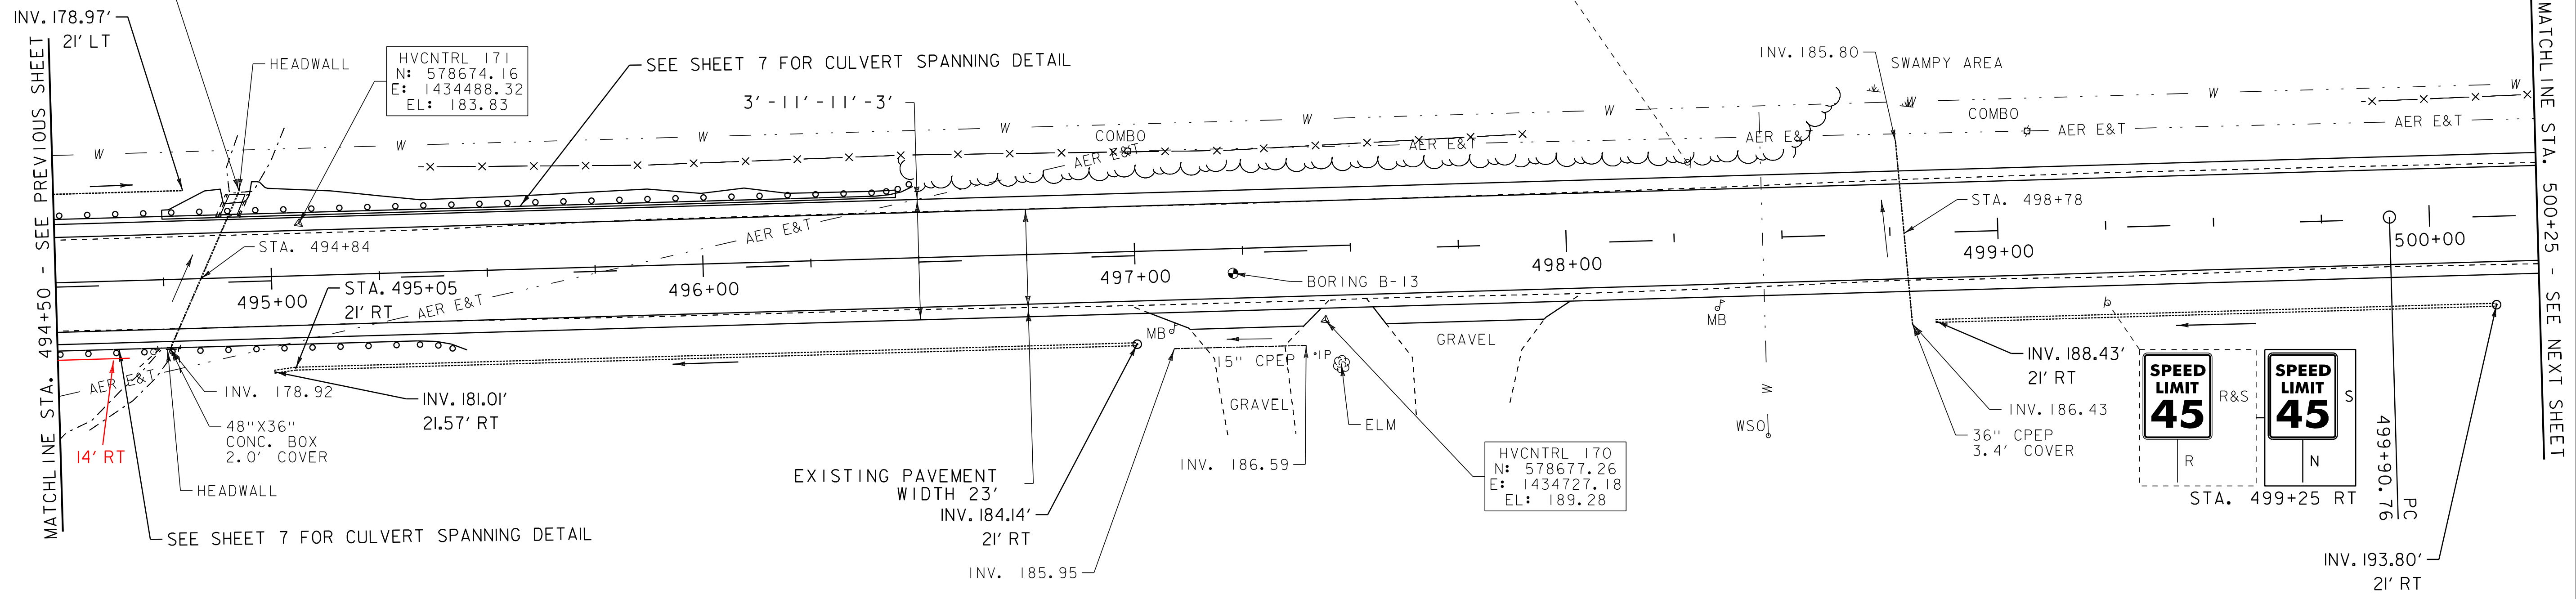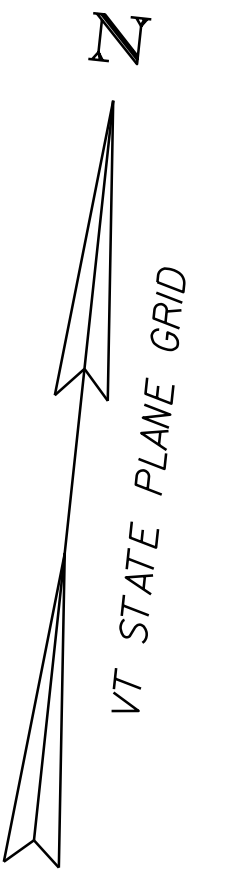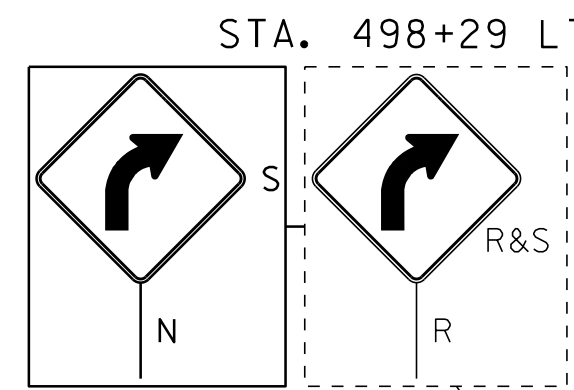

6 INCH UNDERDRAIN PIPE  
 STA. 494+50 - STA. 494+80 LT 494+90  
 STA. 495+00 - STA. 497+00 RT  
 STA. 498+85 - STA. 500+15 RT

6" UNDERDRAIN PIPE  
 494+50 - 494+70 RT

6 INCH UNDERDRAIN CARRIER PIPE  
 STA. 497+00 RT  
 STA. 500+15 RT

UNDERDRAIN FLUSHING BASIN  
 STA. 497+00 RT  
 STA. 500+15 RT

RELOCATE MAILBOX, SINGLE SUPPORT  
 STA. 497+08 RT  
 STA. 498+35 RT

**ENVIRONMENTALLY SENSITIVE LOCATIONS:**


NO.	LIMITS	POS.	TYPE
4.	STA. 494+50 - STA. 500+25	LT	EM - WET MEADOW
5.	STA. 494+50 - STA. 497+50	RT	EM - WET MEADOW
6.	STA. 494+75	-	WATERCOURSE

KEY:  
 EM - EMERGENT WETLAND  
 FO - FORESTED WETLAND  
 SS - SCRUB-SHRUB WETLAND

- LEGEND**
- SIGN
  - HYDRANT
  - MANHOLE
  - GATE VALVE
  - GAS PIPELINE MARKER
  - CATCH BASIN / DROP INLET
  - CURB INLET
  - BORING LOCATION
  - MAILBOX
  - UTILITY POLE
  - FLUSHING BASIN

- SIGN LEGEND**
- R = REMOVE
  - R&S = REMOVE AND SALVAGE
  - RET = RETAIN
  - S = SALVAGE
  - N = NEW
  - B-B = BACK TO BACK

DATUM  
 NAVD 88  
 NAD 83

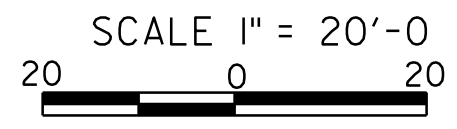

<b>PROJECT LAYOUT SHEET 10</b>	PROJECT NAME: ADDISON - NEW HAVEN	PLOT DATE: 3/13/2012
	PROJECT NUMBER: STP 9632(1)	DRAWN BY: SJL
	FILE NAME: p95B076.dgn	CHECKED BY: EPD
	PROJECT LEADER: CDL	SHEET 33 OF 186
	DESIGNED BY: SJL	
	PLOT FILE: p95B076_33.1	