

STONE FILL, TYPE I
 STA. 504+25 - STA. 505+50 LT

GRUBBING MATERIAL
 STA. 504+25 - STA. 505+50 LT

GEOTEXTILE FOR SILT FENCE
 STA. 504+25 - STA. 505+50 LT

GEOTEXTILE UNDER STONE FILL
 STA. 504+25 - STA. 505+50 LT


RELOCATE MAILBOX, SINGLE SUPPORT
 STA. 501+35 RT
 STA. 503+90 RT

DURABLE 4 INCH WHITE LINE (SEE OPTION ITEMS)
 STA. 500+25 - STA. 505+50 (SOLID LT & RT)

TEMPORARY 4 INCH WHITE LINE, PAINT
 STA. 500+25 - STA. 505+50 (SOLID LT & RT)

DURABLE 4 INCH YELLOW LINE (SEE OPTION ITEMS)
 STA. 500+25 - STA. 504+00 (DASHED)
 STA. 504+00 - STA. 505+50 (DASHED LT, SOLID RT)

TEMPORARY 4 INCH YELLOW LINE, PAINT
 STA. 500+25 - STA. 504+00 (DASHED)
 STA. 504+00 - STA. 505+50 (DASHED LT, SOLID RT)

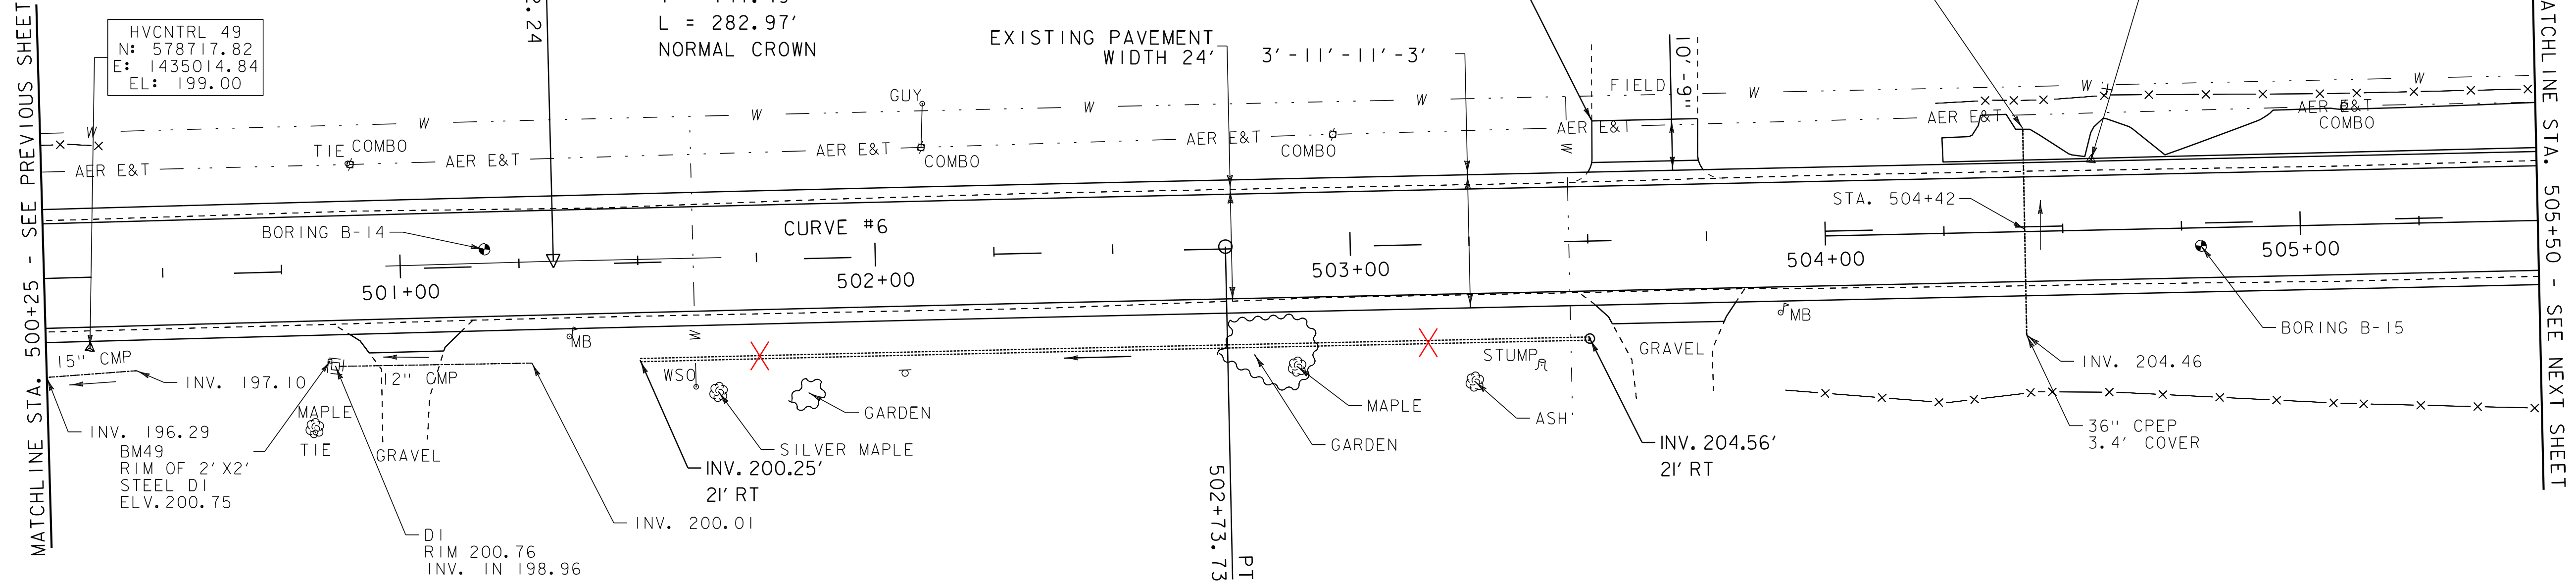

MATCHLINE STA. 500+25 - SEE PREVIOUS SHEET

MATCHLINE STA. 505+50 - SEE NEXT SHEET

HVCNTRL 49
 N: 578717.82
 E: 1435014.84
 EL: 199.00

HVCNTRL 168
 N: 578802.11
 E: 1435429.38
 EL: 210.51

CURVE #6
 DELTA = 0°25'16"
 D = 0°08'56"
 R = 38500.00'
 T = 141.49'
 L = 282.97'
 NORMAL CROWN

ENVIRONMENTALLY SENSITIVE LOCATIONS:

NO.	LIMITS	POS.	TYPE
4.	STA. 500+25 - STA. 503+50	LT	EM - WET MEADOW

KEY:
 EM - EMERGENT WETLAND
 FO - FORESTED WETLAND
 SS - SCRUB-SHRUB WETLAND

~~6 INCH UNDERDRAIN PIPE
 STA. 501+50 - STA. 503+50 RT~~


~~6 INCH UNDERDRAIN CARRIER PIPE
 STA. 503+50 RT~~

~~UNDERDRAIN FLUSHING BASIN
 STA. 503+50 RT~~

- LEGEND**
- SIGN
 - HYDRANT
 - MANHOLE
 - GATE VALVE
 - GAS PIPELINE MARKER
 - CATCH BASIN / DROP INLET
 - CURB INLET
 - BORING LOCATION
 - MAILBOX
 - UTILITY POLE
 - FLUSHING BASIN

- SIGN LEGEND**
- R = REMOVE
 - R&S = REMOVE AND SALVAGE
 - RET = RETAIN
 - S = SALVAGE
 - N = NEW
 - B-B = BACK TO BACK

DATUM
 NAVD 88
 NAD 83

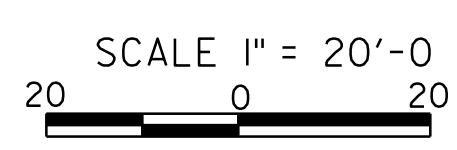

PROJECT LAYOUT SHEET 11	PROJECT NAME: ADDISON - NEW HAVEN	PLOT DATE: 3/13/2012
	PROJECT NUMBER: STP 9632(1)	DRAWN BY: SJL
	FILE NAME: p95B076.dgn	CHECKED BY: EPD
	PROJECT LEADER: CDL	SHEET 34 OF 186