

6 INCH UNDERDRAIN PIPE
 STA. 523+00 - STA. 527+50 LT 526+99

6 INCH UNDERDRAIN CARRIER PIPE
 STA. 525+00 LT 526+99 LT
 STA. 527+50 LT 526+03 LT

UNDERDRAIN FLUSHING BASIN
 STA. 525+00 LT
 STA. 527+50 LT

REMOVING AND RESETTING FENCE
 STA. 522+96 - STA. 524+05 LT

DURABLE 4 INCH WHITE LINE (SEE OPTION ITEMS)
 STA. 522+75 - STA. 528+50 (SOLID LT & RT)

TEMPORARY 4 INCH WHITE LINE, PAINT
 STA. 522+75 - STA. 528+50 (SOLID LT & RT)

STONE FILL, TYPE I
 STA. 528+25 - STA. 528+50 LT

GRUBBING MATERIAL
 STA. 528+25 - STA. 528+50 LT

GEOTEXTILE FOR SILT FENCE
 STA. 528+25 - STA. 528+50 LT

GEOTEXTILE UNDER STONE FILL
 STA. 528+25 - STA. 528+50 LT

STEEL BEAM GUARDRAIL, GALVANIZED W/8 FEET POSTS
 STA. 522+75 - STA. 522+76.25 LT 522+96.5 LT
 STA. 528+25 - STA. 528+50 LT
 528+27

ANCHOR FOR STEEL BEAM RAIL
 STA. 522+76.25 LT 522+96 LT
 STA. 528+25 LT 528+27 LT

DURABLE 4 INCH YELLOW LINE (SEE OPTION ITEMS)
 STA. 522+75 - STA. 528+50 (SOLID LT & RT)



TEMPORARY 4 INCH YELLOW LINE, PAINT
 STA. 522+75 - STA. 528+50 (SOLID LT & RT)

REMOVING SIGNS
 AS SHOWN - 2

ERECTING SALVAGED SIGNS
 AS SHOWN - 2

CURVE #9
 DELTA = 31° 13' 37"
 D = 9° 23' 34"
 R = 610.00'
 T = 170.47'
 L = 332.46'
 BANKING 0.08 FT/FT
 180' RUNOFF (45 MPH)
 SEE SUPERELEVATION DIAGRAMS
 FOR BANKING INFORMATION


REGRADE DRIVE WITH 4' PAVED APRON
 AND SUBBASE OF GRAVEL, FINE GRADED

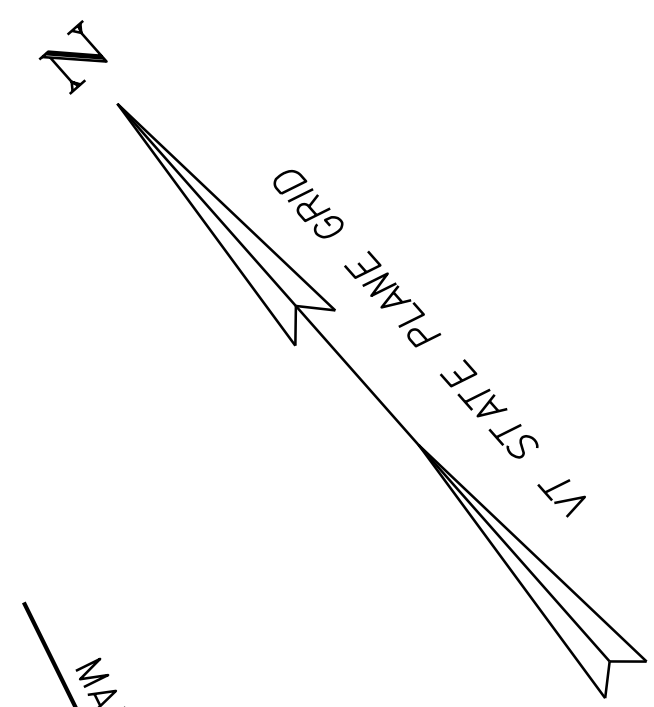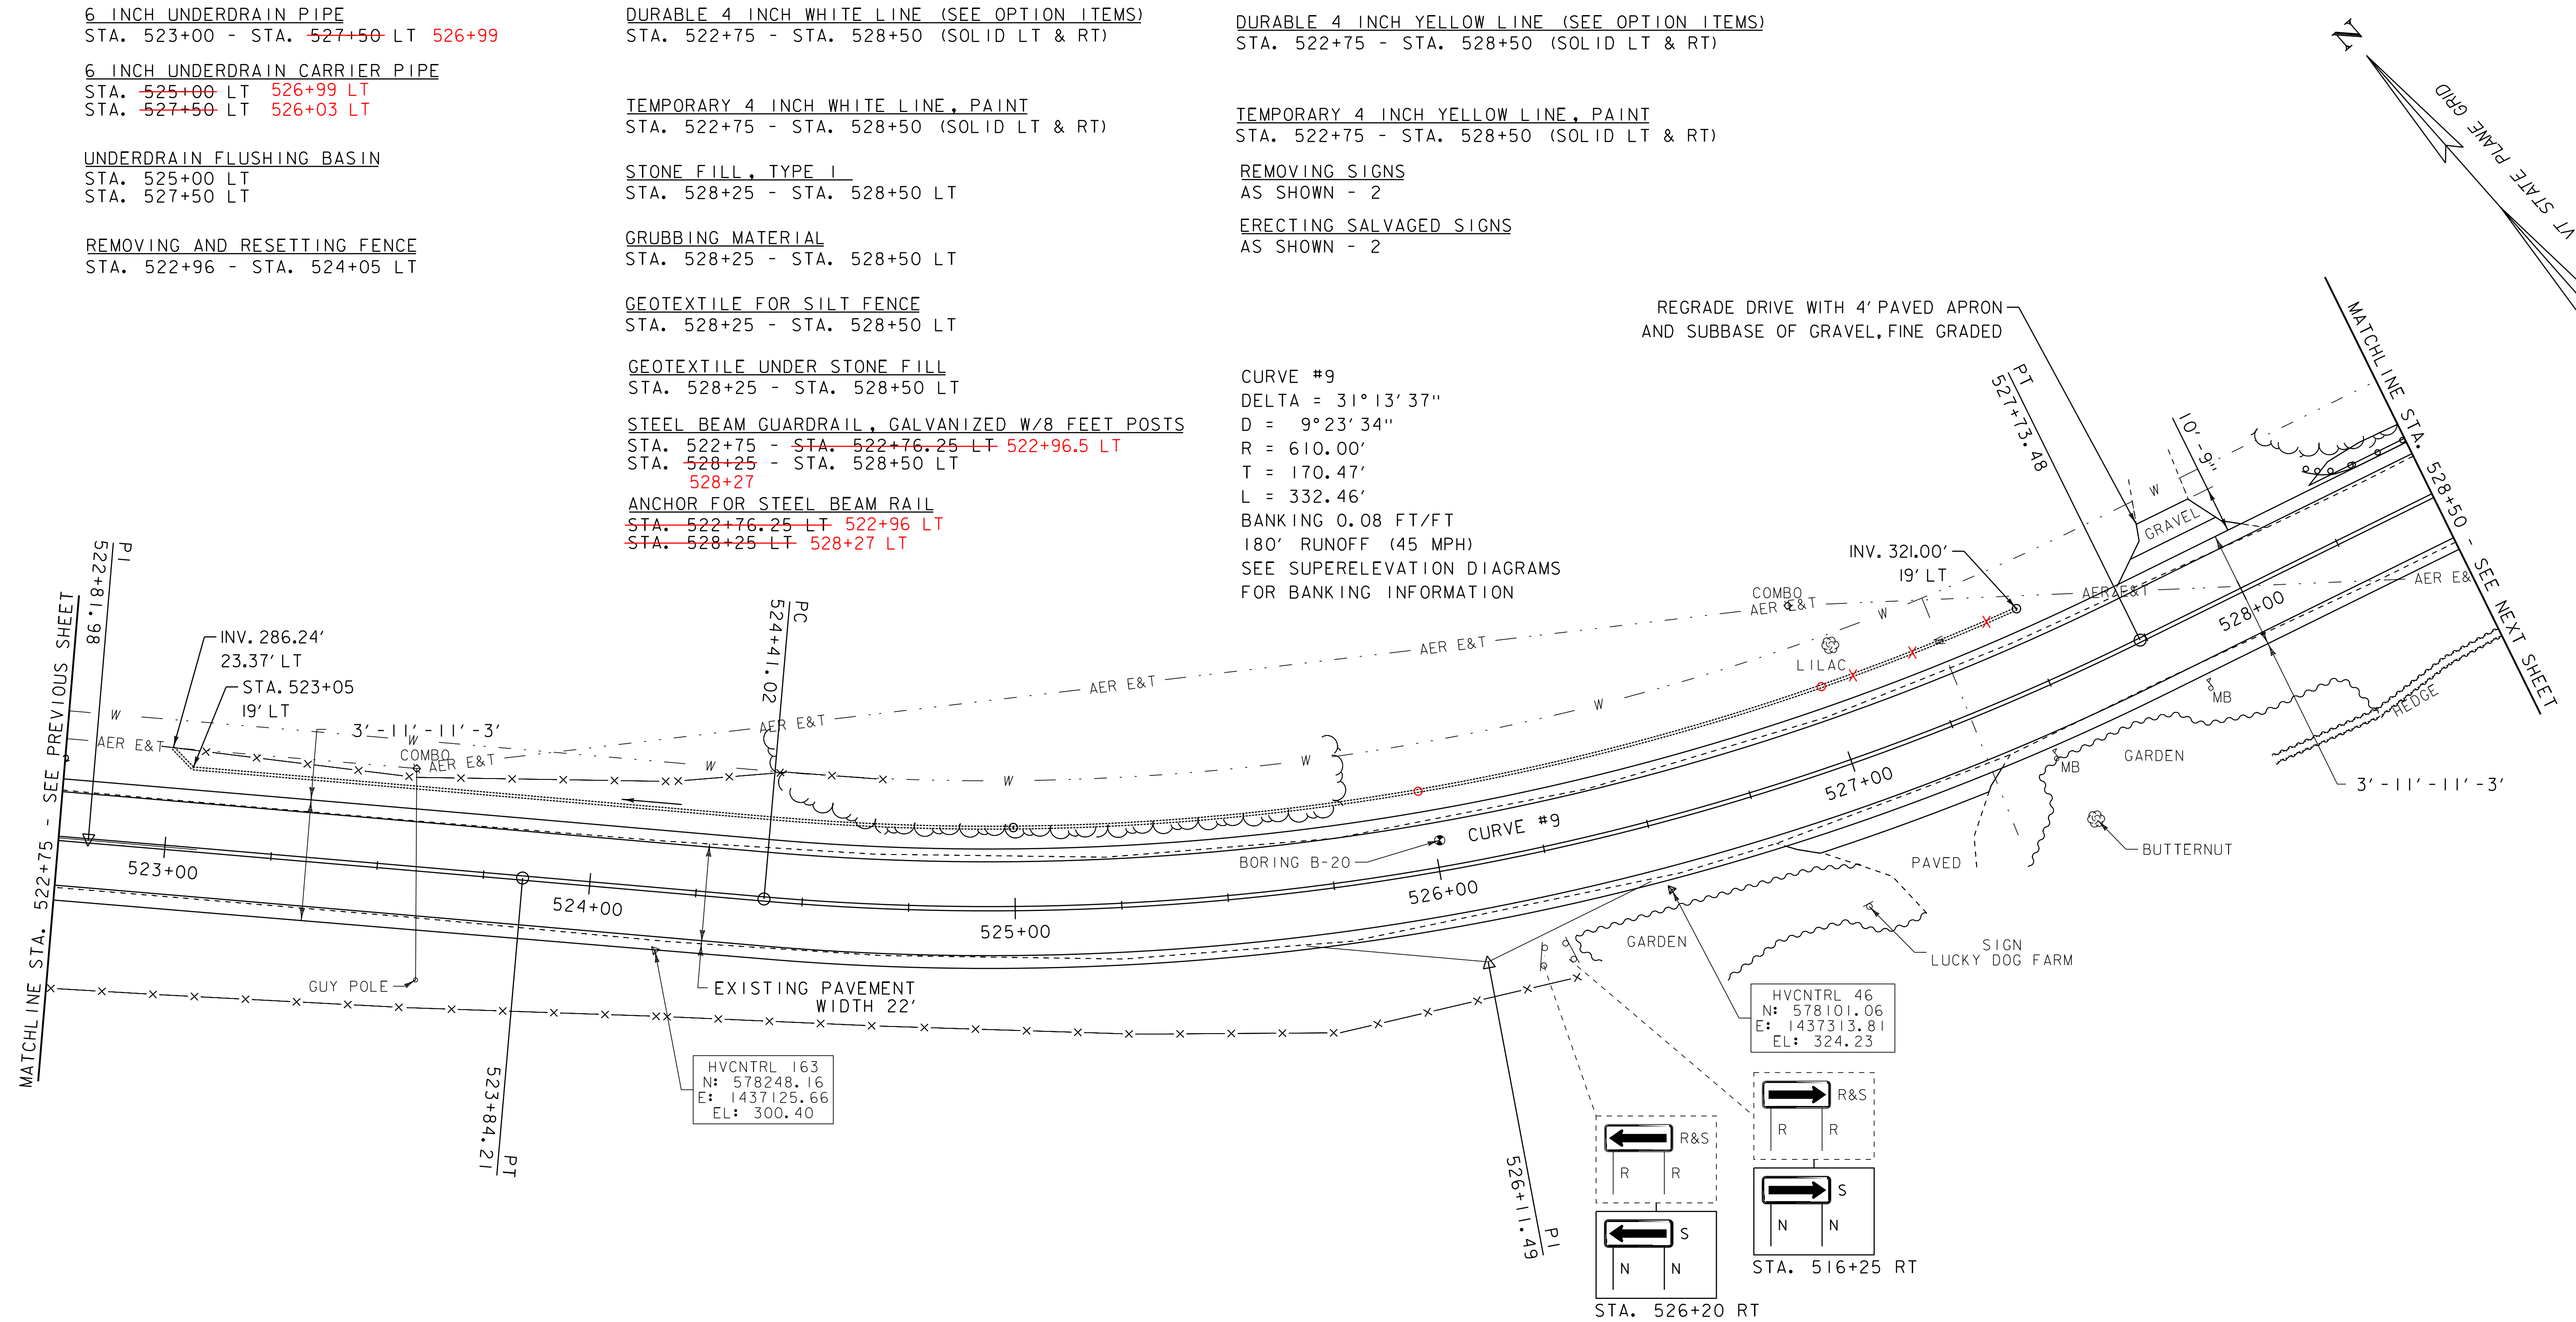

- LEGEND**
- SIGN
 - HYDRANT
 - MANHOLE
 - GATE VALVE
 - GAS PIPELINE MARKER
 - CATCH BASIN / DROP INLET
 - = CURB INLET
 - ⊕ BORING LOCATION
 - ⊕ MAILBOX
 - UTILITY POLE
 - FLUSHING BASIN

- SIGN LEGEND**
- R = REMOVE
 - R&S = REMOVE AND SALVAGE
 - RET = RETAIN
 - S = SALVAGE
 - N = NEW
 - B-B = BACK TO BACK

DATUM
 NAVD 88
 NAD 83

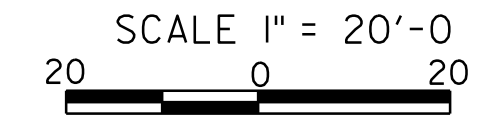

PROJECT LAYOUT SHEET 15	PROJECT NAME: ADDISON - NEW HAVEN	PLOT DATE: 3/13/2012
	PROJECT NUMBER: STP 9632(1)	DRAWN BY: SJL
	FILE NAME: p95B076.dgn	CHECKED BY: EPD
	DESIGNED BY: SJL	SHEET 38 OF 186
PLOT FILE: p95B076_38.i		