

DURABLE 4 INCH WHITE LINE (SEE OPTION ITEMS)
 STA. 545+75 - STA. 551+75 (SOLID LT & RT)
 (WITH EDGE LINE BREAKS AT TH #6)
 STA. 547+90 LT (EDGE LINES TH #6)

TEMPORARY 4 INCH WHITE LINE, PAINT
 STA. 545+75 - STA. 551+75 (SOLID LT & RT)
 (WITH EDGE LINE BREAKS AT TH #6)
 STA. 547+90 LT (EDGE LINES TH #6)

6 INCH UNDERDRAIN PIPE
 STA. ~~550+00~~ - STA. 551+75 RT
 549+40

6 INCH UNDERDRAIN CARRIER PIPE
 STA. 550+00 RT

DURABLE 4 INCH YELLOW LINE (SEE OPTION ITEMS)
 STA. 545+75 - STA. 551+75 (SOLID LT & RT)
 (WITH CENTERLINE BREAKS AT TH #6)
 STA. 547+90 LT (CENTERLINE TH #6)

TEMPORARY 4 INCH YELLOW LINE, PAINT
 STA. 545+75 - STA. 551+75 (SOLID LT & RT)
 (WITH CENTERLINE BREAKS AT TH #6)
 STA. 547+90 LT (CENTERLINE TH #6)

DURABLE 24 INCH STOP BAR (SEE OPTION ITEMS)
 STA. 547+59 - STA. 547+91 LT (TH #6)


DURABLE LETTER OR SYMBOL (SEE OPTION ITEMS)
 STA. 547+83 LT "STOP" (TH #6)

TEMPORARY 24 INCH STOP BAR, PAINT
 STA. 547+59 - STA. 547+91 LT (TH #6)

TEMPORARY LETTER OR SYMBOL, PAINT
 STA. 547+83 LT "STOP" (TH #6)

UNDERDRAIN FLUSHING BASIN
 STA. ~~550+00~~ RT
 549+40 RT
 RELOCATE MAILBOX, SINGLE SUPPORT
 STA. 548+73 RT

REMOVING SIGNS
 AS SHOWN - 1
 ERECTING SALVAGED SIGNS
 AS SHOWN - 1

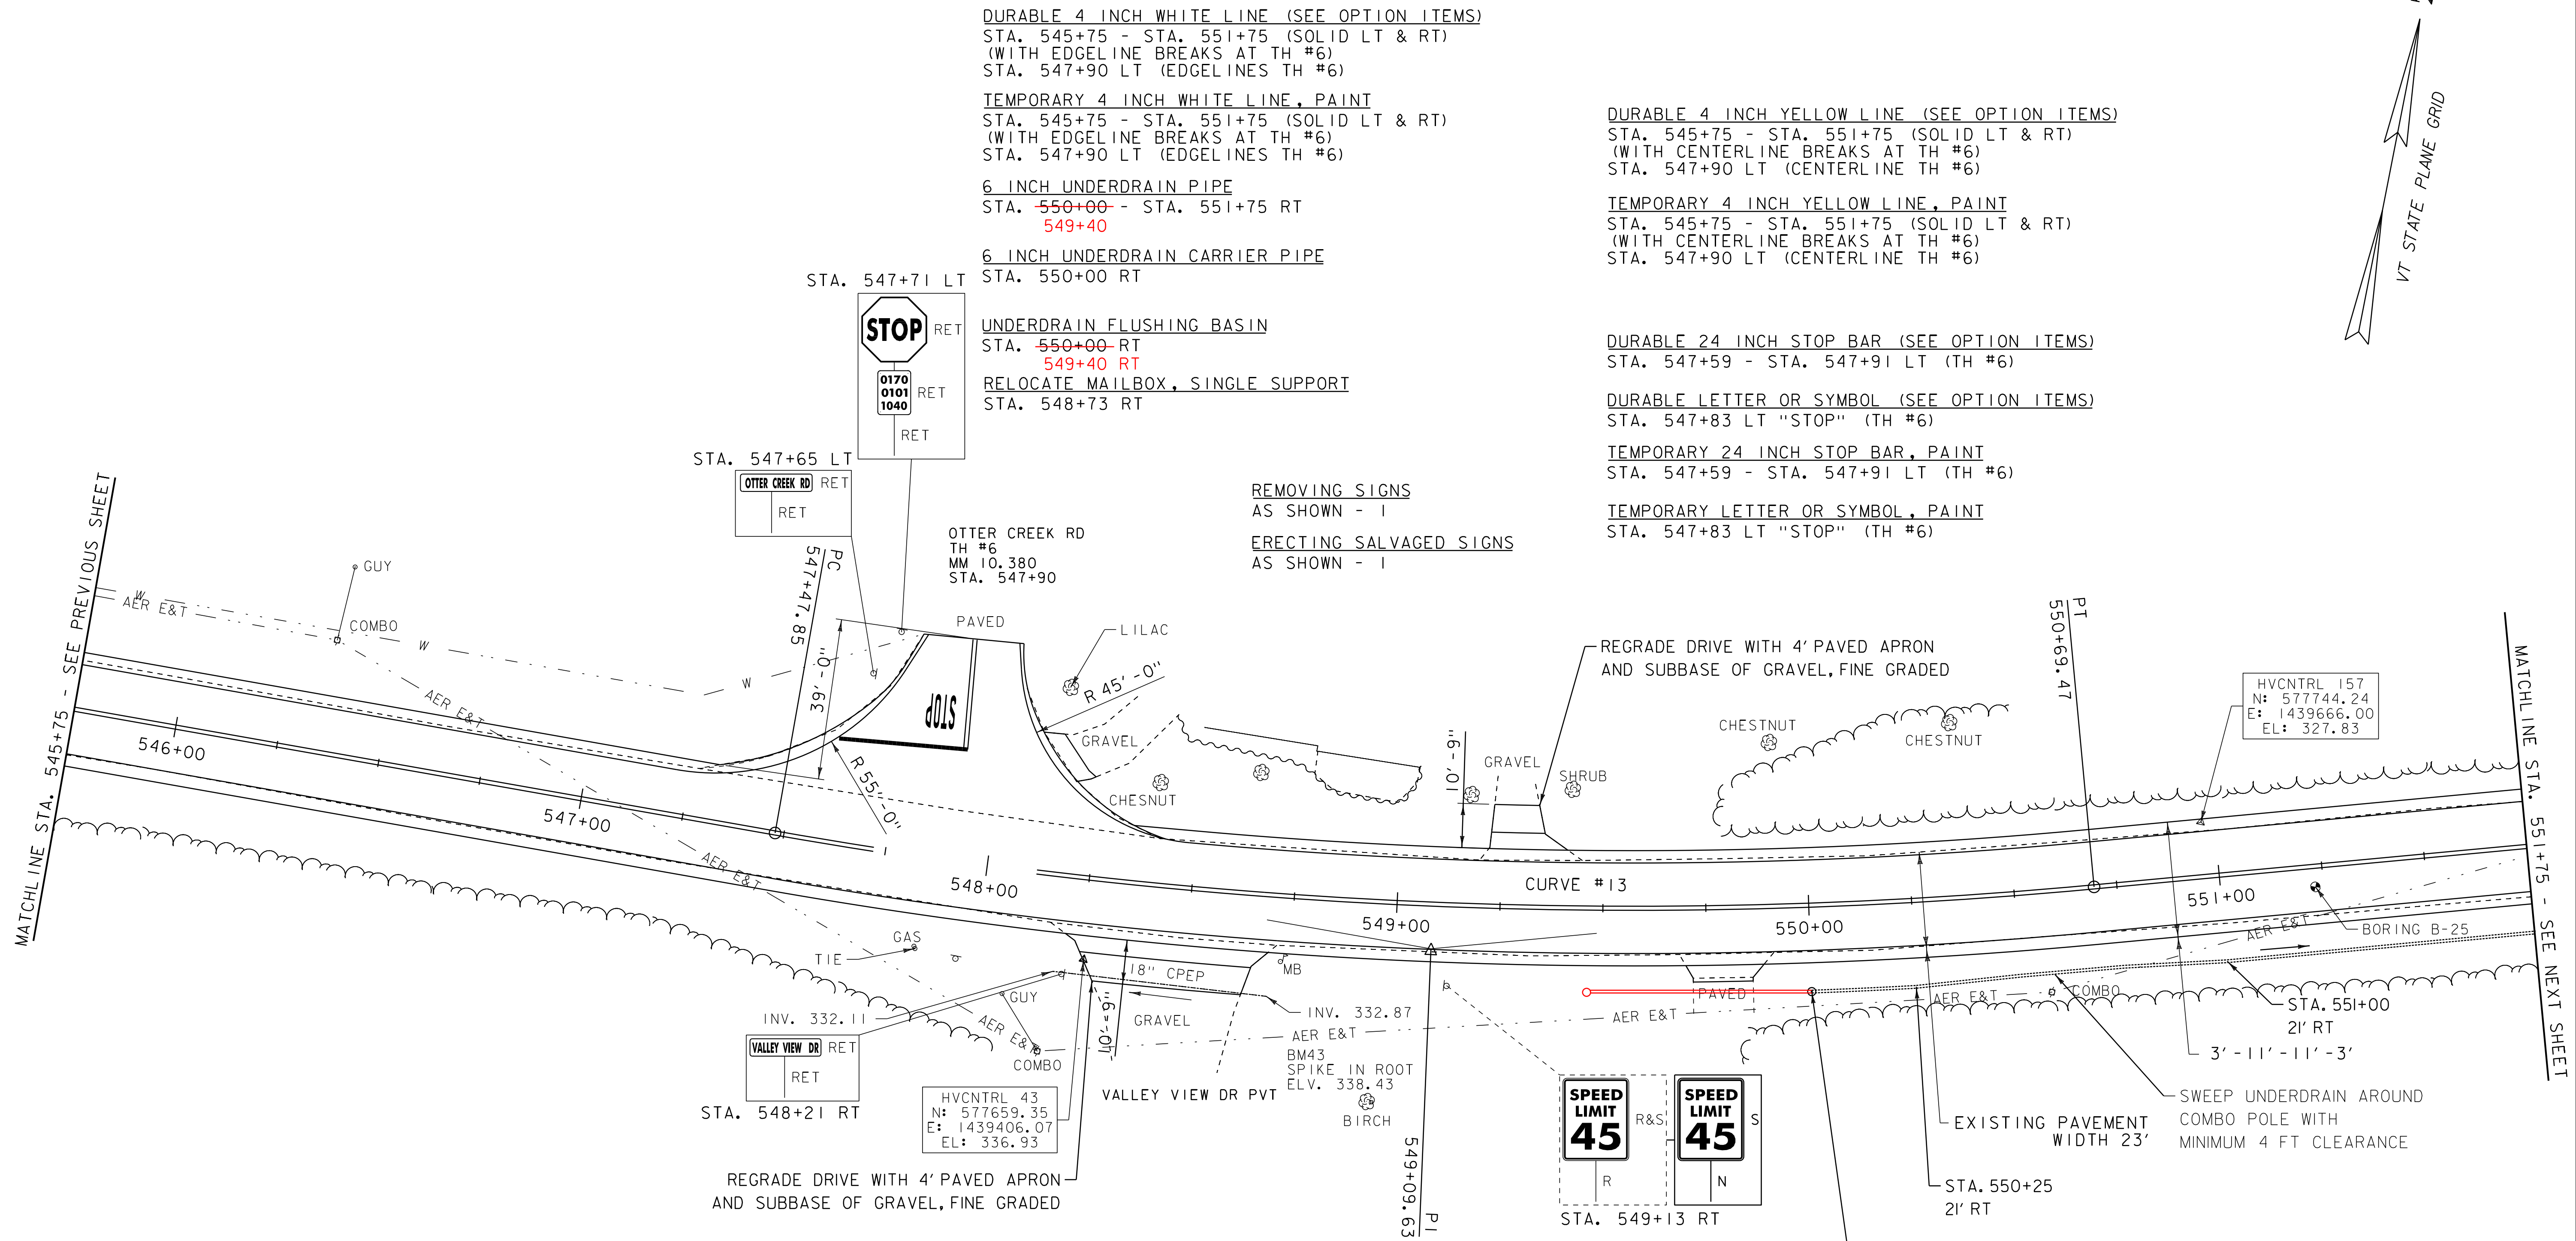


CURVE #13
 DELTA = 15°21'22"
 D = 4°46'29"
 R = 1200.00'
 T = 161.78'
 L = 321.62'
 BANKING 0.062 FT/FT
 140' RUNOFF (45 MPH)
 SEE SUPERELEVATION DIAGRAMS
 FOR BANKING INFORMATION

- LEGEND**
- SIGN
 - ⊙ HYDRANT
 - MANHOLE
 - ⊙ GATE VALVE
 - ⊙ GAS PIPELINE MARKER
 - ⊙ CATCH BASIN / DROP INLET
 - CURB INLET
 - ⊙ BORING LOCATION
 - ⊙ MAILBOX
 - ⊙ UTILITY POLE
 - ⊙ FLUSHING BASIN

- SIGN LEGEND**
- R = REMOVE
 - R&S = REMOVE AND SALVAGE
 - RET = RETAIN
 - S = SALVAGE
 - N = NEW
 - B-B = BACK TO BACK

DATUM
 NAVD 88
 NAD 83

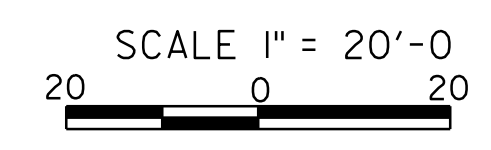

PROJECT LAYOUT SHEET 19	PROJECT NAME: ADDISON - NEW HAVEN
	PROJECT NUMBER: STP 9632(1)
	FILE NAME: p95B076.dgn
	PLOT DATE: 3/13/2012
PROJECT LEADER: CDL	DRAWN BY: SJL
DESIGNED BY: SJL	CHECKED BY: EPD
PLOT FILE: p95B076_42.i	SHEET 42 OF 186