

STONE FILL, TYPE I
STA. 553+75 - STA. 557+50 LT

GRUBBING MATERIAL
STA. 553+75 - STA. 557+50 LT

GEOTEXTILE FOR SILT FENCE
STA. 553+75 - STA. 557+50 LT

GEOTEXTILE UNDER STONE FILL
STA. 553+75 - STA. 557+50 LT

DURABLE 4 INCH WHITE LINE (SEE OPTION ITEMS)
STA. 551+75 - STA. 557+50 (SOLID LT & RT)

TEMPORARY 4 INCH WHITE LINE, PAINT
STA. 551+75 - STA. 557+50 (SOLID LT & RT)

DURABLE 4 INCH YELLOW LINE (SEE OPTION ITEMS)
STA. 551+75 - STA. 557+50 (SOLID LT & RT)

TEMPORARY 4 INCH YELLOW LINE, PAINT
STA. 551+75 - STA. 557+50 (SOLID LT & RT)

REMOVING SIGNS
AS SHOWN - 2

ERECTING SALVAGED SIGNS
AS SHOWN - 2




6 INCH UNDERDRAIN PIPE
STA. 551+75 - STA. 557+50 RT

6 INCH UNDERDRAIN CARRIER PIPE
STA. 553+00 RT
STA. 556+00 RT

UNDERDRAIN FLUSHING BASIN
STA. ~~553+00~~ RT ~~553+60~~ RT
STA. ~~556+00~~ RT ~~557+00~~ RT

STEEL BEAM GUARDRAIL, GALVANIZED W/8 FEET POSTS
STA. ~~555+00~~ - STA. 557+50 RT
~~557+15~~

ANCHOR FOR STEEL BEAM RAIL
STA. ~~555+00~~ RT
~~557+15~~

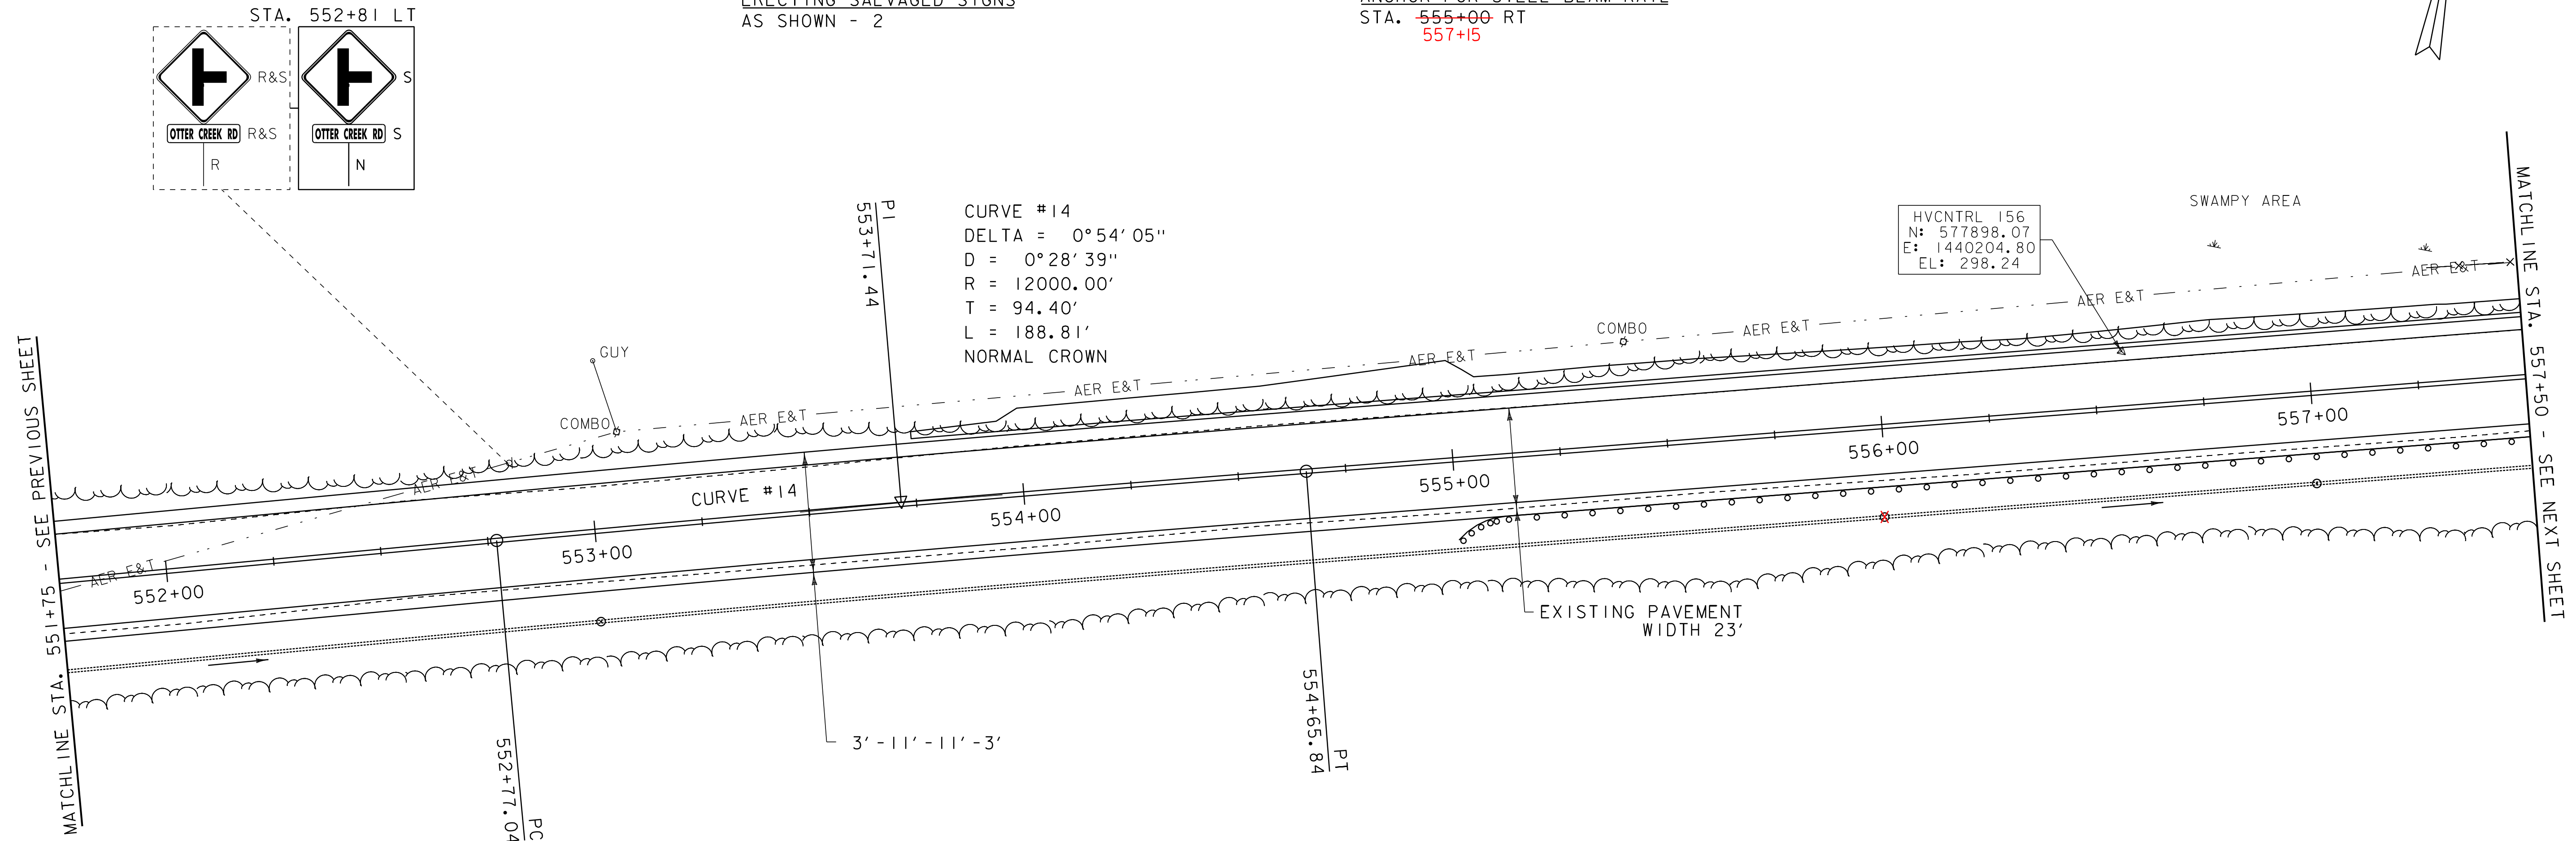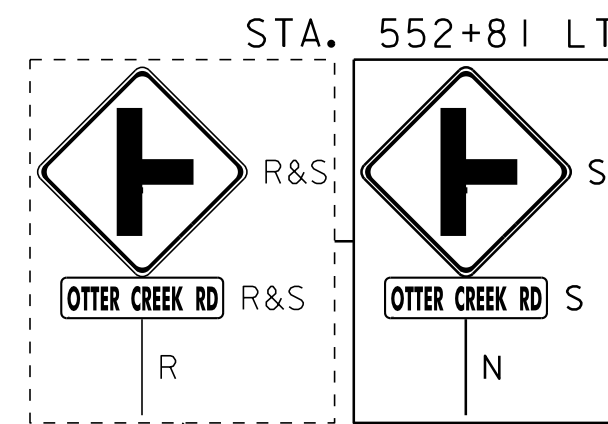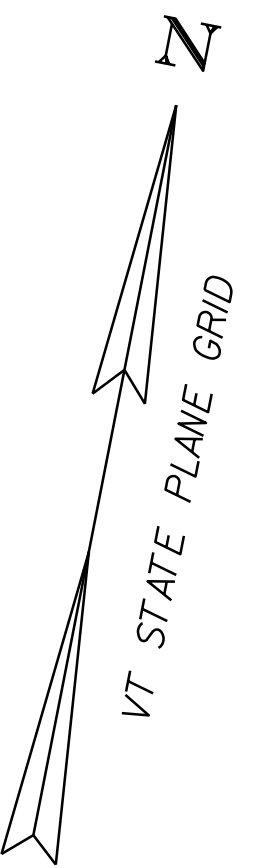

ENVIRONMENTALLY SENSITIVE LOCATIONS:

NO.	LIMITS	POS.	TYPE
9.	STA. 554+00 - STA. 557+50	LT	EM - WET MEADOW

KEY:
EM - EMERGENT WETLAND
FO - FORESTED WETLAND
SS - SCRUB-SHRUB WETLAND

- LEGEND**
- SIGN
 - HYDRANT
 - MANHOLE
 - GATE VALVE
 - GAS PIPELINE MARKER
 - CATCH BASIN / DROP INLET
 - CURB INLET
 - ⊕ BORING LOCATION
 - ⊕ MAILBOX
 - ⊕ UTILITY POLE
 - FLUSHING BASIN

- SIGN LEGEND**
- R = REMOVE
 - R&S = REMOVE AND SALVAGE
 - RET = RETAIN
 - S = SALVAGE
 - N = NEW
 - B-B = BACK TO BACK

DATUM
NAVD 88
NAD 83

SCALE 1" = 20'-0"
20 0 20

PROJECT LAYOUT SHEET 20

PROJECT NAME: ADDISON - NEW HAVEN
PROJECT NUMBER: STP 9632(1)

FILE NAME: p95B076.dgn
PROJECT LEADER: CDL
DESIGNED BY: SJL
PLOT FILE: p95B076_43.1

PLOT DATE: 3/13/2012
DRAWN BY: SJL
CHECKED BY: EPD
SHEET 43 OF 186