

DURABLE 4 INCH WHITE LINE (SEE OPTION ITEMS)  
STA. 563+25 - STA. 569+25 (SOLID LT & RT)

TEMPORARY 4 INCH WHITE LINE, PAINT  
STA. 563+25 - STA. 569+25 (SOLID LT & RT)

DURABLE 4 INCH YELLOW LINE (SEE OPTION ITEMS)  
STA. 563+25 - STA. 569+25 (SOLID LT & RT)

TEMPORARY 4 INCH YELLOW LINE, PAINT  
STA. 563+25 - STA. 569+25 (SOLID LT & RT)

GEOTEXTILE FOR SILT FENCE  
STA. 563+25 - STA. 563+93 LT

GEOTEXTILE UNDER STONE FILL  
STA. 563+25 - STA. 563+93 LT

6 INCH UNDERDRAIN PIPE  
STA. 563+25 - STA. ~~564+00~~ RT 563+90  
STA. ~~564+25~~ - STA. 569+25 RT  
STA. ~~566+25~~ - STA. ~~568+95~~ LT 569+25

6 INCH UNDERDRAIN CARRIER PIPE  
STA. 564+00 RT STA. 566+25 LT  
STA. 564+25 RT STA. 567+25 RT

REMOVING SIGNS  
AS SHOWN - 1

ERECTING SALVAGED SIGNS  
AS SHOWN - 1


STONE FILL, TYPE I  
STA. 563+25 - STA. 563+93 LT

GRUBBING MATERIAL  
STA. 563+25 - STA. 563+93 LT

UNDERDRAIN FLUSHING BASIN  
STA. ~~564+00~~ RT STA. ~~566+25~~ LT 566+21 LT  
STA. ~~564+25~~ RT STA. ~~567+25~~ RT

~~STEEL BEAM GUARDRAIL, GALVANIZED W/8 FEET POSTS  
STA. 563+25 - STA. 563+50 RT~~

~~ANCHOR FOR STEEL BEAM RAIL  
STA. 563+50 RT~~

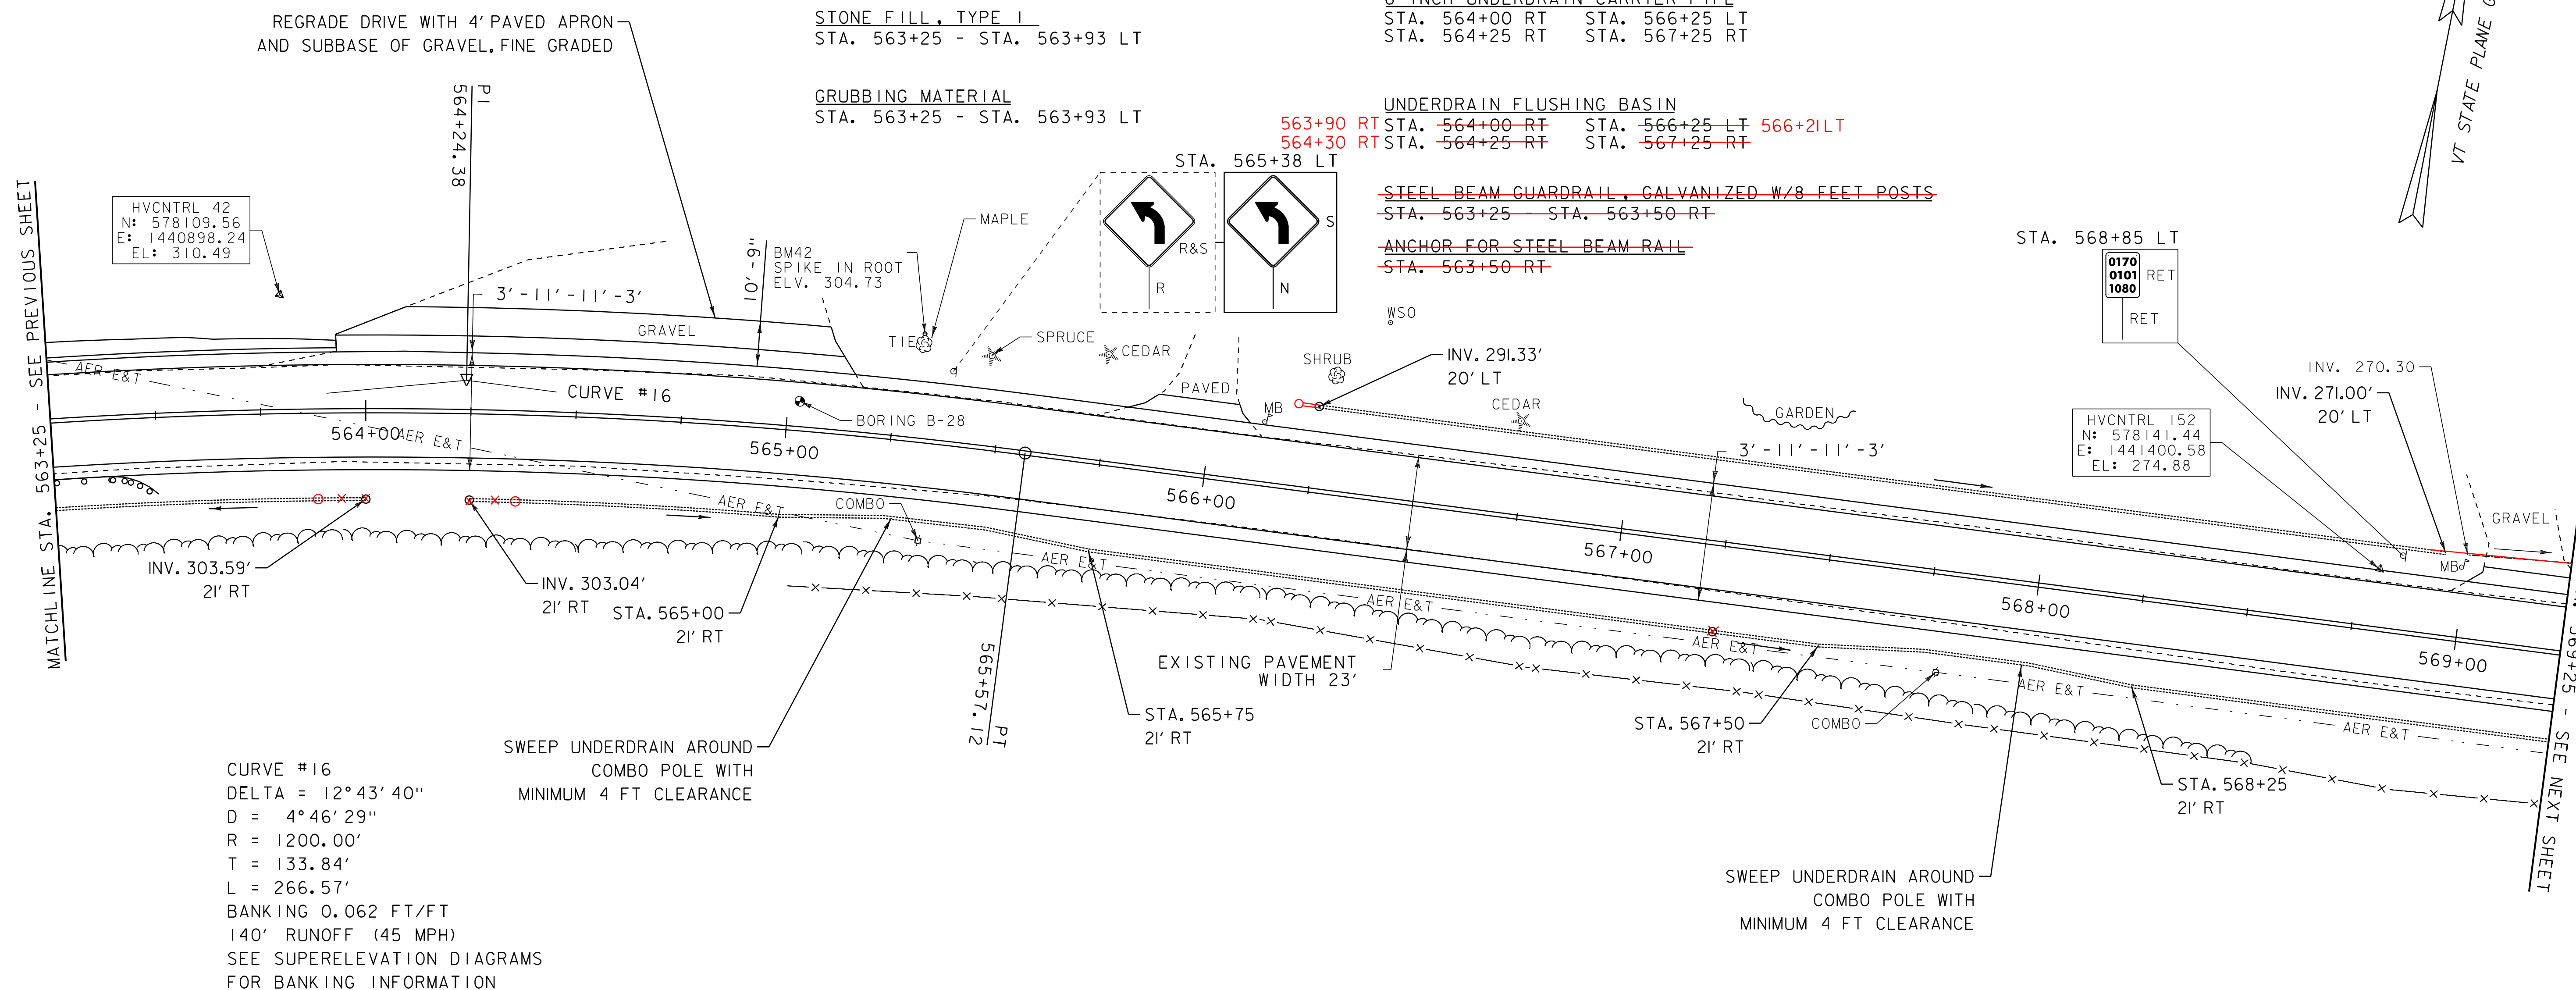

CURVE #16  
DELTA = 12° 43' 40"  
D = 4° 46' 29"  
R = 1200.00'  
T = 133.84'  
L = 266.57'  
BANKING 0.062 FT/FT  
140' RUNOFF (45 MPH)  
SEE SUPERELEVATION DIAGRAMS  
FOR BANKING INFORMATION

SWEEP UNDERDRAIN AROUND  
COMBO POLE WITH  
MINIMUM 4 FT CLEARANCE

SWEEP UNDERDRAIN AROUND  
COMBO POLE WITH  
MINIMUM 4 FT CLEARANCE

- LEGEND**
- SIGN
  - HYDRANT
  - MANHOLE
  - GATE VALVE
  - GAS PIPELINE MARKER
  - CATCH BASIN / DROP INLET
  - CURB INLET
  - ⊙ BORING LOCATION
  - ⊙ MAILBOX
  - ⊙ UTILITY POLE
  - ⊙ FLUSHING BASIN

- SIGN LEGEND**
- R = REMOVE
  - R&S = REMOVE AND SALVAGE
  - RET = RETAIN
  - S = SALVAGE
  - N = NEW
  - B-B = BACK TO BACK

DATUM  
NAVD 88  
NAD 83

SCALE 1" = 20'-0"  
20 0 20

**PROJECT LAYOUT SHEET 22**

PROJECT NAME: ADDISON - NEW HAVEN  
PROJECT NUMBER: STP 9632(I)

FILE NAME: p95B076.dgn  
PROJECT LEADER: CDL  
DESIGNED BY: SJL  
PLOT FILE: p95B076\_45.1

PLOT DATE: 3/13/2012  
DRAWN BY: SJL  
CHECKED BY: EPD  
SHEET 45 OF 186