

6 INCH UNDERDRAIN PIPE  
 STA. 569+25 - STA. 572+50 RT 572+65  
 STA. 569+50 - STA. 573+15 LT 573+35  
 STA. 573+50 - STA. 574+75 LT

6 INCH UNDERDRAIN CARRIER PIPE  
 STA. 569+50 LT STA. 573+50 LT  
 STA. 570+00 RT

UNDERDRAIN FLUSHING BASIN  
 STA. 569+50 LT STA. 573+50 LT  
 STA. 570+00 RT 570+10 RT  
 569+95 LT

STONE FILL, TYPE I  
 STA. 572+75 - STA. 574+75 RT

GRUBBING MATERIAL  
 STA. 572+75 - STA. 574+75 RT

DURABLE 4 INCH WHITE LINE (SEE OPTION ITEMS)  
 STA. 569+25 - STA. 574+75 (SOLID LT & RT)


TEMPORARY 4 INCH WHITE LINE, PAINT  
 STA. 569+25 - STA. 574+75 (SOLID LT & RT)

GEOTEXTILE FOR SILT FENCE  
 STA. 572+75 - STA. 574+75 RT

GEOTEXTILE UNDER STONE FILL  
 STA. 572+75 - STA. 574+75 RT


DURABLE 4 INCH YELLOW LINE (SEE OPTION ITEMS)  
 STA. 569+25 - STA. 574+75 (SOLID LT & RT)

TEMPORARY 4 INCH YELLOW LINE, PAINT  
 STA. 569+25 - STA. 574+75 (SOLID LT & RT)

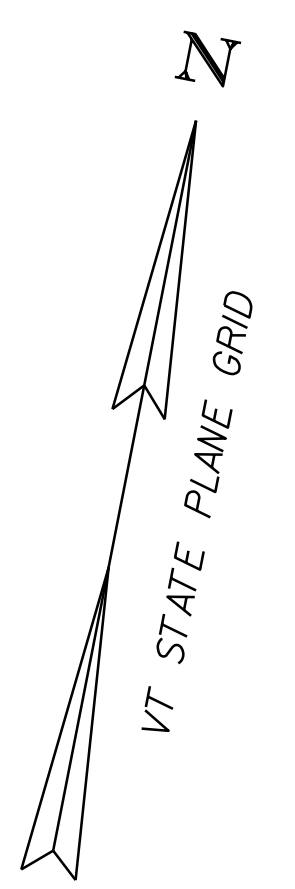

① STA. 573+41.84 LT 18.24' TO  
 STA. 573+42.79 LT 15.29'  
 EXTEND 18" CPEP (3'-0")  
 PROPOSED INV. IN = 247.57'  
 EXISTING INV. IN = 247.45'

CURVE #17  
 DELTA = 15°56'53"  
 D = 6°21'58"  
 R = 900.00'  
 T = 126.07'  
 L = 250.51'  
 BANKING 0.071 FT/FT  
 160' RUNOFF (45 MPH)  
 SEE SUPERELEVATION DIAGRAMS  
 FOR BANKING INFORMATION

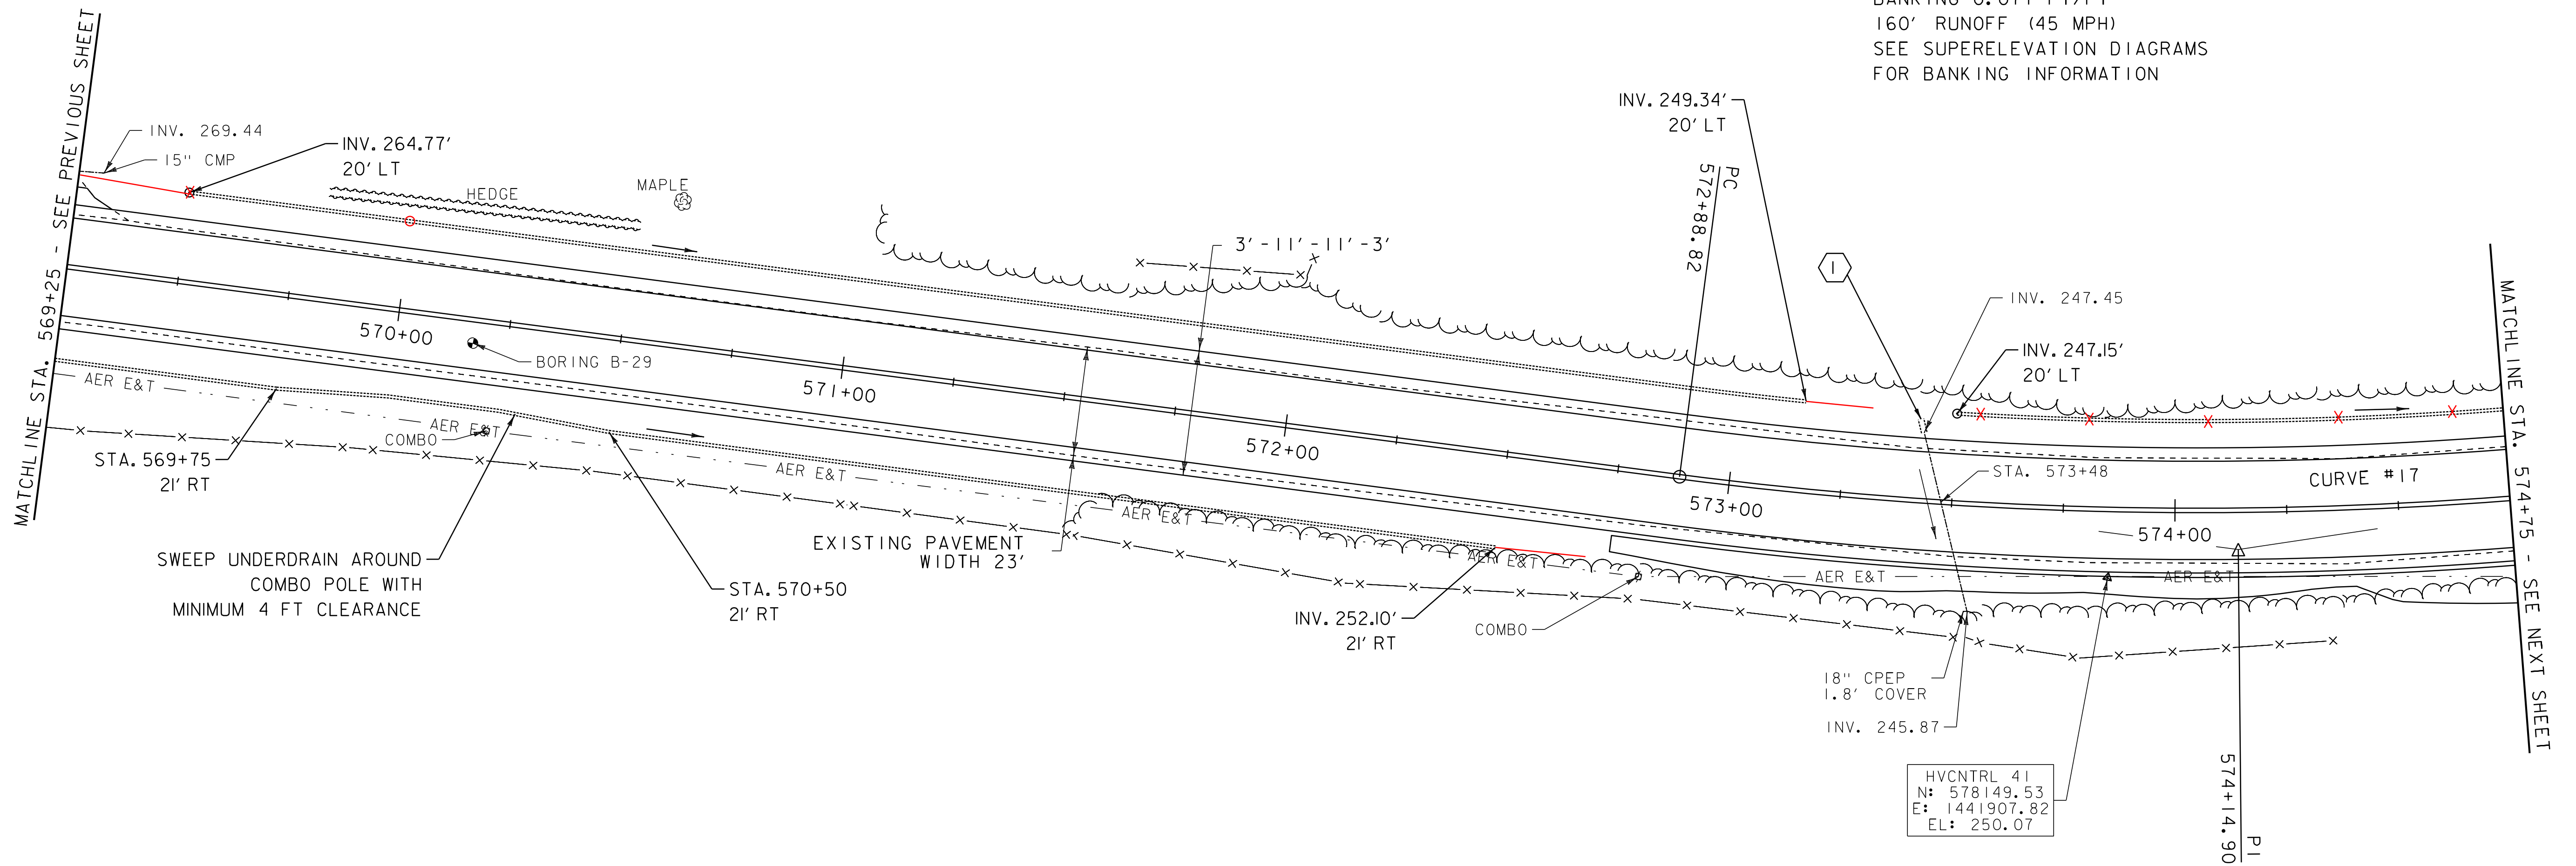

SWEEP UNDERDRAIN AROUND  
 COMBO POLE WITH  
 MINIMUM 4 FT CLEARANCE

EXISTING PAVEMENT  
 WIDTH 23'

HVCNTRL 41  
 N: 578149.53  
 E: 1441907.82  
 EL: 250.07

- LEGEND**
- SIGN
  - HYDRANT
  - MANHOLE
  - GATE VALVE
  - GAS PIPELINE MARKER
  - CATCH BASIN / DROP INLET
  - CURB INLET
  - BORING LOCATION
  - MAILBOX
  - UTILITY POLE
  - FLUSHING BASIN

- SIGN LEGEND**
- R = REMOVE
  - R&S = REMOVE AND SALVAGE
  - RET = RETAIN
  - S = SALVAGE
  - N = NEW
  - B-B = BACK TO BACK

DATUM  
 NAVD 88  
 NAD 83

SCALE 1" = 20'-0"  
 20 0 20

<b>PROJECT LAYOUT SHEET 23</b>	PROJECT NAME: ADDISON - NEW HAVEN	PLOT DATE: 3/13/2012
	PROJECT NUMBER: STP 9632(1)	DRAWN BY: SJL
	FILE NAME: p95B076.dgn	CHECKED BY: EPD
	PLOT FILE: p95B076_46.i	SHEET 46 OF 186