

6 INCH UNDERDRAIN PIPE
 575+68 STA. ~~574+75~~ - STA. 578+00 LT 578+08
 STA. 579+50 - STA. 579+75 LT

6 INCH UNDERDRAIN CARRIER PIPE
 STA. 575+75 LT
 STA. 579+50 LT

UNDERDRAIN FLUSHING BASIN
 STA. ~~575+75~~ LT 575+68 LT
 STA. 579+50 LT

DURABLE 4 INCH WHITE LINE (SEE OPTION ITEMS)
 STA. 574+75 - STA. 579+75 (SOLID LT & RT)

DURABLE 4 INCH YELLOW LINE (SEE OPTION ITEMS)
 STA. 574+75 - STA. 579+75 (SOLID LT & RT)

TEMPORARY 4 INCH WHITE LINE, PAINT
 STA. 574+75 - STA. 579+75 (SOLID LT & RT)

TEMPORARY 4 INCH YELLOW LINE, PAINT
 STA. 574+75 - STA. 579+75 (SOLID LT & RT)



STONE FILL, TYPE I
 STA. 574+75 - STA. 576+75 RT
 STA. 577+75 - STA. 578+18 LT
 STA. 578+36 - STA. 578+75 LT

GRUBBING MATERIAL
 STA. 574+75 - STA. 576+75 RT
 STA. 577+75 - STA. 578+18 LT
 STA. 578+36 - STA. 578+75 LT

GEOTEXTILE FOR SILT FENCE
 STA. 574+75 - STA. 576+75 RT
 STA. 577+75 - STA. 578+18 LT
 STA. 578+36 - STA. 578+75 LT

GEOTEXTILE UNDER STONE FILL
 STA. 574+75 - STA. 576+75 RT
 STA. 577+75 - STA. 578+18 LT
 STA. 578+36 - STA. 578+75 LT

CURVE #18
 DELTA = 13° 46' 49"
 D = 4° 05' 33"
 R = 1400.00'
 T = 169.17'
 L = 336.71'
 BANKING 0.056 FT/FT
 140' RUNOFF (45 MPH)
 SEE SUPERELEVATION DIAGRAMS
 FOR BANKING INFORMATION

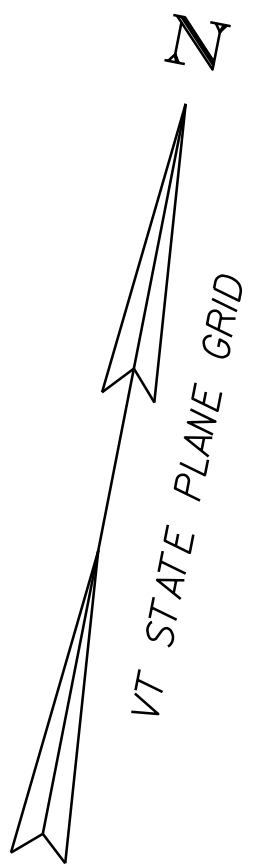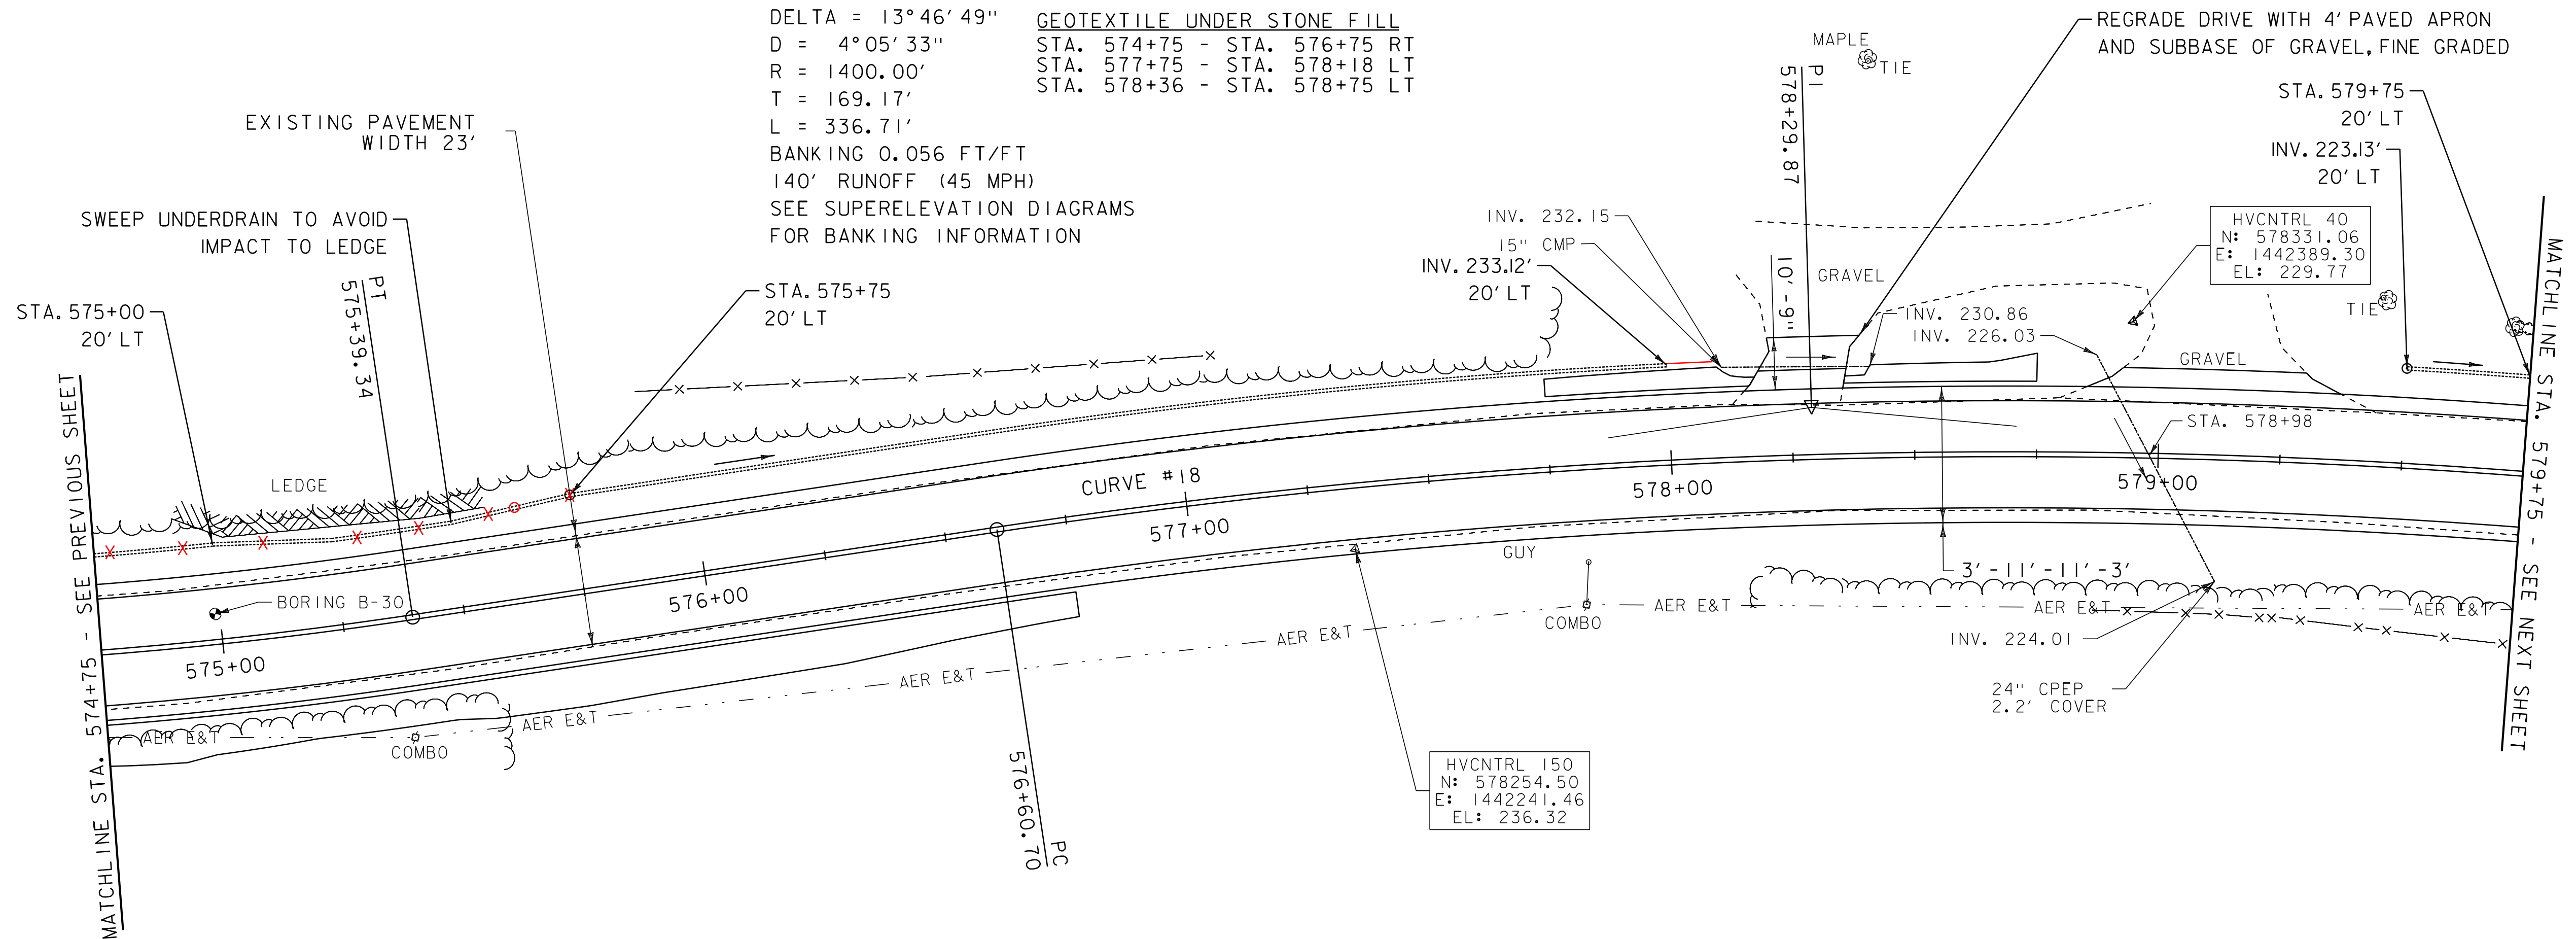

ENVIRONMENTALLY SENSITIVE LOCATIONS:


NO.	LIMITS	POS.	TYPE
II.	STA. 572+88 - STA. 579+75	RT	EM/SS

KEY:
 EM - EMERGENT WETLAND
 FO - FORESTED WETLAND
 SS - SCRUB-SHRUB WETLAND

- LEGEND**
- SIGN
 - HYDRANT
 - MANHOLE
 - GATE VALVE
 - GAS PIPELINE MARKER
 - CATCH BASIN / DROP INLET
 - CURB INLET
 - BORING LOCATION
 - MAILBOX
 - UTILITY POLE
 - FLUSHING BASIN

- SIGN LEGEND**
- R = REMOVE
 - R&S = REMOVE AND SALVAGE
 - RET = RETAIN
 - S = SALVAGE
 - N = NEW
 - B-B = BACK TO BACK

DATUM
 NAVD 88
 NAD 83

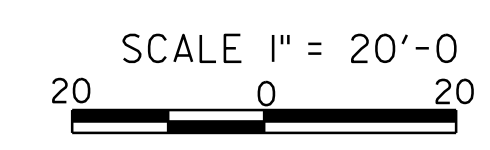

PROJECT LAYOUT SHEET 24	PROJECT NAME: ADDISON - NEW HAVEN	PLOT DATE: 3/13/2012
	PROJECT NUMBER: STP 9632(1)	DRAWN BY: SJL
	FILE NAME: p95B076.dgn	CHECKED BY: EPD
	DESIGNED BY: SJL	SHEET 47 OF 186
	PLOT FILE: p95B076_47.i	