

6 INCH UNDERDRAIN PIPE
 STA. 579+75 - STA. 582+25 LT 585+10
 STA. 583+75 - STA. 585+00 LT

6" UNDERDRAIN PIPE
 585+66 - 585+75 LT

6 INCH UNDERDRAIN CARRIER PIPE
 STA. 583+75 LT

UNDERDRAIN FLUSHING BASIN
 STA. 583+75 LT
 582+30 LT
 585+66 LT

DURABLE 4 INCH WHITE LINE (SEE OPTION ITEMS)
 STA. 579+75 - STA. 585+75 (SOLID LT & RT)

TEMPORARY 4 INCH WHITE LINE, PAINT
 STA. 579+75 - STA. 585+75 (SOLID LT & RT)

STONE FILL, TYPE I
 STA. 582+25 - STA. 582+58 LT

GRUBBING MATERIAL
 STA. 582+25 - STA. 582+58 LT

GEOTEXTILE UNDER STONE FILL
 STA. 582+25 - STA. 582+58 LT





GEOTEXTILE FOR SILT FENCE
 STA. 582+25 - STA. 582+58 LT

DURABLE 4 INCH YELLOW LINE (SEE OPTION ITEMS)
 STA. 579+75 - STA. 585+75 (SOLID LT & RT)

TEMPORARY 4 INCH YELLOW LINE, PAINT
 STA. 579+75 - STA. 585+75 (SOLID LT & RT)

REMOVING SIGNS
 AS SHOWN - 5

ERECTING SALVAGED SIGNS
 AS SHOWN - 5

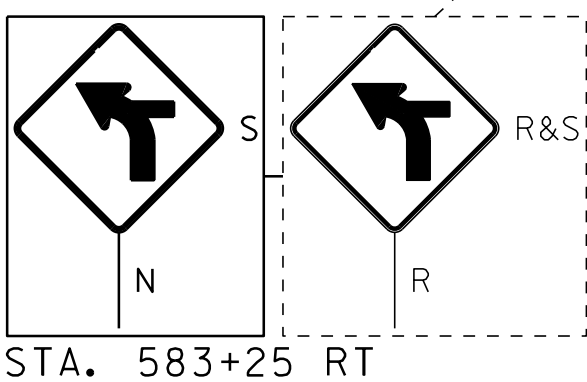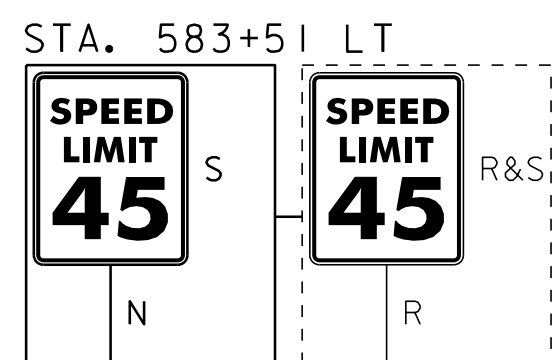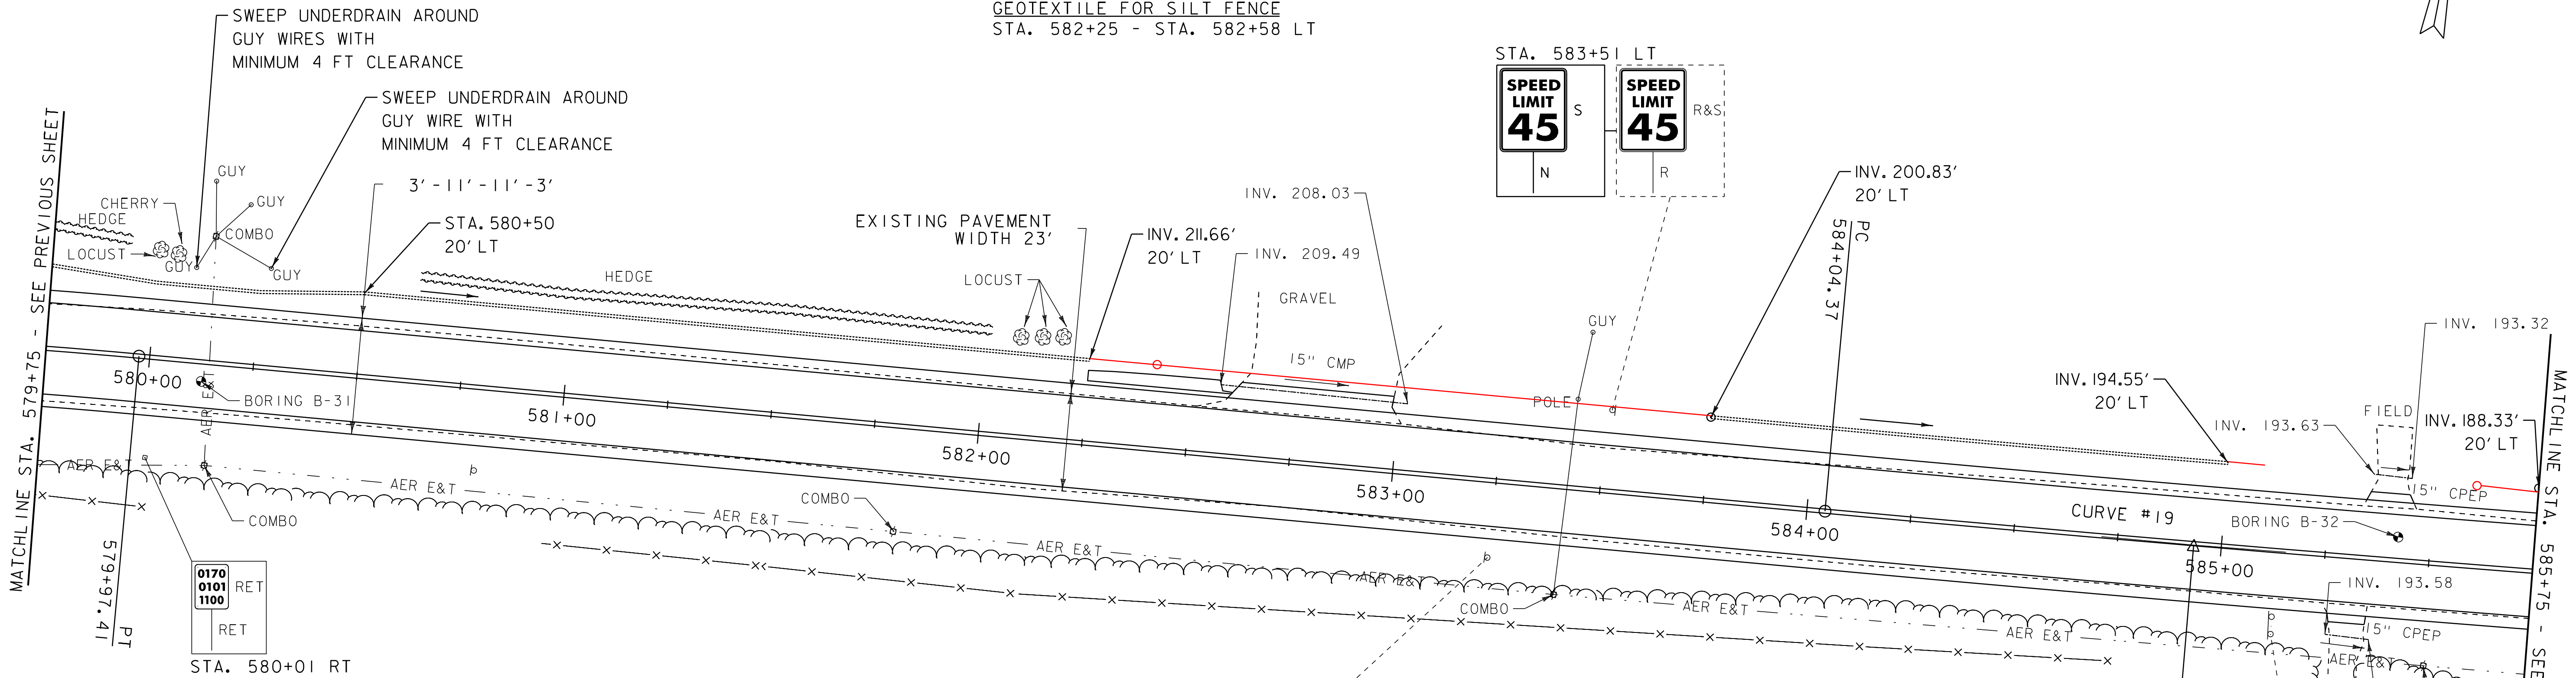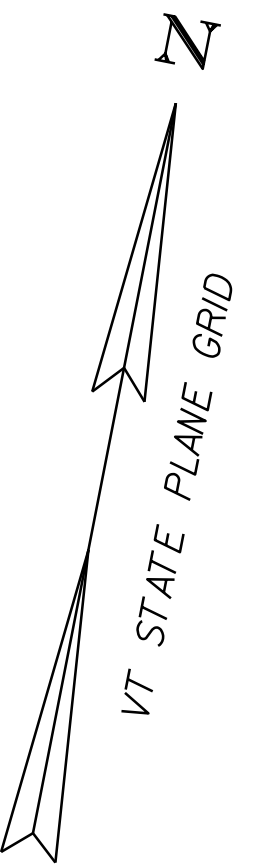

ENVIRONMENTALLY SENSITIVE LOCATIONS:

NO.	LIMITS	POS.	TYPE
II.	STA. 579+75 - STA. 585+75	RT	EM/SS

KEY:
 EM - EMERGENT WETLAND
 FO - FORESTED WETLAND
 SS - SCRUB-SHRUB WETLAND

- LEGEND**
- SIGN
 - HYDRANT
 - MANHOLE
 - GATE VALVE
 - GAS PIPELINE MARKER
 - CATCH BASIN / DROP INLET
 - CURB INLET
 - ⊙ BORING LOCATION
 - ⊙ MAILBOX
 - ⊙ UTILITY POLE
 - ⊙ FLUSHING BASIN


- SIGN LEGEND**
- R = REMOVE
 - R&S = REMOVE AND SALVAGE
 - RET = RETAIN
 - S = SALVAGE
 - N = NEW
 - B-B = BACK TO BACK

CURVE #19
 DELTA = 0°50'59"
 D = 0°28'39"
 R = 12000.00'
 T = 88.98'
 L = 177.95'
 NORMAL CROWN

↑ New Haven Jct	3	S
↑ Bristol	10	R&S
↑ Middlebury	8	R&S
↑ New Haven Jct	3	S
↑ Bristol	10	S
↑ Middlebury	8	S

DATUM

NAVD 88
NAD 83

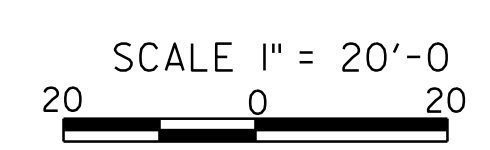

PROJECT LAYOUT SHEET 25	PROJECT NAME: ADDISON - NEW HAVEN
	PROJECT NUMBER: STP 9632(1)
FILE NAME: p95B076.dgn	PLOT DATE: 3/13/2012
PROJECT LEADER: CDL	DRAWN BY: SJL
DESIGNED BY: SJL	CHECKED BY: EPD
PLOT FILE: p95B076_48.1	SHEET 48 OF 186