

DURABLE 4 INCH WHITE LINE (SEE OPTION ITEMS)  
 STA. 585+75 - STA. 587+92.19 (SOLID LT & RT)  
 (WITH EDGELINE BREAKS AT TH #1)  
 STA. a 0+00 - STA. a 3+50 (SOLID LT & RT)  
 (WITH EDGELINE BREAKS AT TH #1)  
 STA. a 0+36 RT (EDGELINES TH #1)

TEMPORARY 4 INCH WHITE LINE, PAINT  
 STA. 585+75 - STA. 587+92.19 (SOLID LT & RT)  
 (WITH EDGELINE BREAKS AT TH #1)  
 STA. a 0+00 - STA. a 3+50 (SOLID LT & RT)  
 (WITH EDGELINE BREAKS AT TH #1)  
 STA. a 0+36 RT (EDGELINES TH #1)

TEMPORARY 24 INCH STOP BAR, PAINT  
 STA. a 0+35 - STA. a 0+65 RT (TH #1)

TEMPORARY LETTER OR SYMBOL, PAINT  
 STA. a 0+44 RT "STOP" (TH #1)

DURABLE 4 INCH YELLOW LINE (SEE OPTION ITEMS)  
 STA. 585+75 - STA. 587+92.19 (SOLID LT & RT)  
 STA. a 0+00 - STA. a 3+50 (SOLID LT & RT)  
 (WITH CENTERLINE BREAKS AT TH #1)  
 STA. a 0+36 RT (CENTERLINE TH #1)

TEMPORARY 4 INCH YELLOW LINE, PAINT  
 STA. 585+75 - STA. 587+92.19 (SOLID LT & RT)  
 STA. a 0+00 - STA. a 3+50 (SOLID LT & RT)  
 (WITH CENTERLINE BREAKS AT TH #1)  
 STA. a 0+36 RT (CENTERLINE TH #1)

DURABLE 24 INCH STOP BAR (SEE OPTION ITEMS)  
 STA. a 0+35 - STA. a 0+65 RT (TH #1)

DURABLE LETTER OR SYMBOL (SEE OPTION ITEMS)  
 STA. a 0+44 RT "STOP" (TH #1)

6 INCH UNDERDRAIN PIPE  
 STA. 585+75 - STA. a 3+00 LT  
 3+05

6" UNDERDRAIN PIPE  
 586+60 - 587+50 RT

6 INCH UNDERDRAIN CARRIER PIPE  
 STA. 585+75 LT  
 STA. a 0+25 LT

UNDERDRAIN FLUSHING BASIN  
 STA. ~~585+75 LT~~  
 STA. ~~a 0+25 LT~~  
 A 0+17 LT


**ENVIRONMENTALLY SENSITIVE LOCATIONS:**

NO.	LIMITS	POS.	TYPE
II.	STA. 585+75 - STA. 587+92	RT	EM/SS

KEY:  
 EM - EMERGENT WETLAND  
 FO - FORESTED WETLAND  
 SS - SCRUB-SHRUB WETLAND

CURVE #20  
 DELTA = 6°31'55"  
 D = 8°25'33"  
 R = 680.00'  
 T = 38.80'  
 L = 77.52'  
 BANKING 0.078 FT/FT  
 170' RUNOFF (45 MPH)  
 SEE SUPERELEVATION DIAGRAMS  
 FOR BANKING INFORMATION

ADDISON STA. 587+92.19 (MM II.135) =  
 WEYBRIDGE STA. a 0+00.00 (MM 0.000)

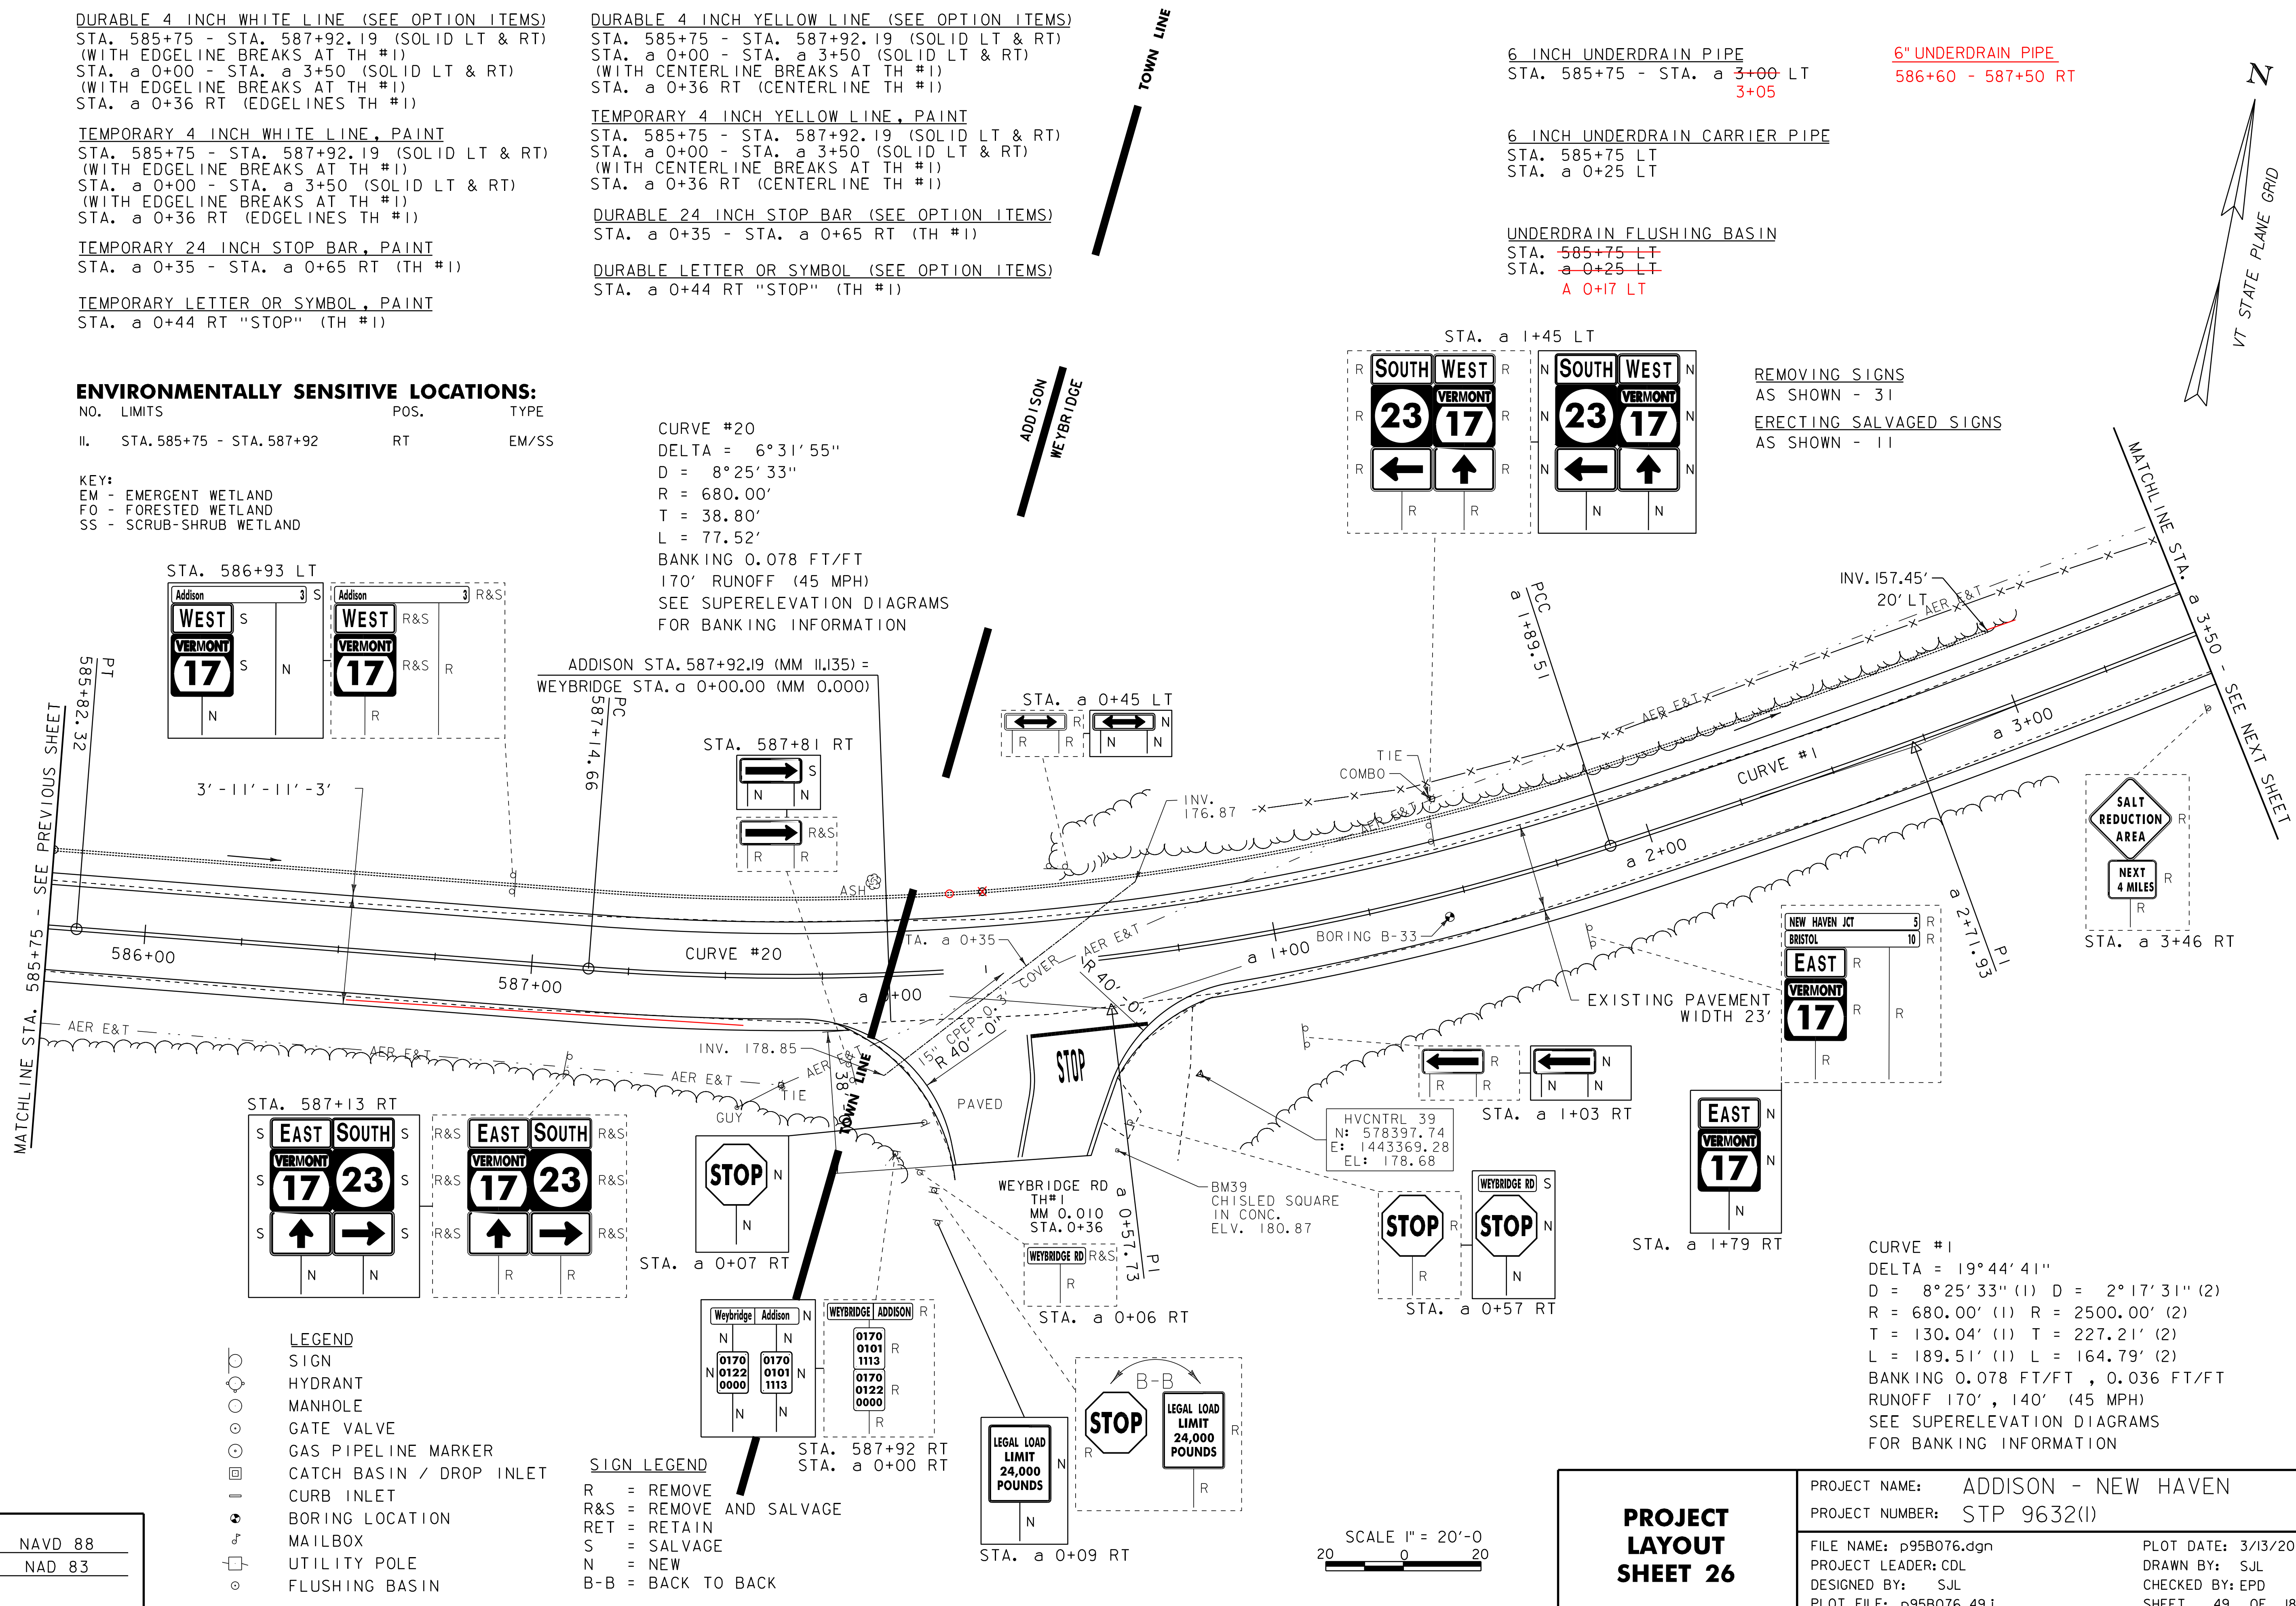


REMOVING SIGNS  
 AS SHOWN - 31  
 ERECTING SALVAGED SIGNS  
 AS SHOWN - 11

- LEGEND**
- SIGN
  - HYDRANT
  - MANHOLE
  - GATE VALVE
  - GAS PIPELINE MARKER
  - CATCH BASIN / DROP INLET
  - CURB INLET
  - BORING LOCATION
  - MAILBOX
  - UTILITY POLE
  - FLUSHING BASIN

- SIGN LEGEND**
- R = REMOVE
  - R&S = REMOVE AND SALVAGE
  - RET = RETAIN
  - S = SALVAGE
  - N = NEW
  - B-B = BACK TO BACK

DATUM

NAVD 88
NAD 83

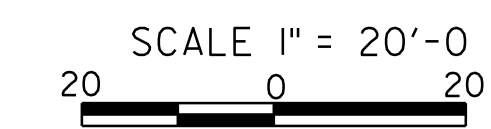

<b>PROJECT LAYOUT SHEET 26</b>	PROJECT NAME: ADDISON - NEW HAVEN
	PROJECT NUMBER: STP 9632(1)
	FILE NAME: p95B076.dgn
PROJECT LEADER: CDL	PLOT DATE: 3/13/2012
DESIGNED BY: SJL	DRAWN BY: SJL
PLOT FILE: p95B076_49.1	CHECKED BY: EPD
	SHEET 49 OF 186