

DURABLE 4 INCH WHITE LINE (SEE OPTION ITEMS)  
 STA. a 3+50 - STA. a 9+50 (SOLID LT & RT)

TEMPORARY 4 INCH WHITE LINE, PAINT  
 STA. a 3+50 - STA. a 9+50 (SOLID LT & RT)



DURABLE 4 INCH YELLOW LINE (SEE OPTION ITEMS)  
 STA. a 3+50 - STA. a 9+50 (SOLID LT & RT)

TEMPORARY 4 INCH YELLOW LINE, PAINT  
 STA. a 3+50 - STA. a 9+50 (SOLID LT & RT)

CURVE #2  
 DELTA = 2°18'48"  
 D = 0°31'15"  
 R = 11000.00'  
 T = 222.10'  
 L = 444.13'  
 NORMAL CROWN

REMOVE GRAVEL PULL OFF  
 SEE DETAIL ON SHEET 4

HVCNTRL 38  
 N: 578921.07  
 E: 1444009.97  
 EL: 158.01

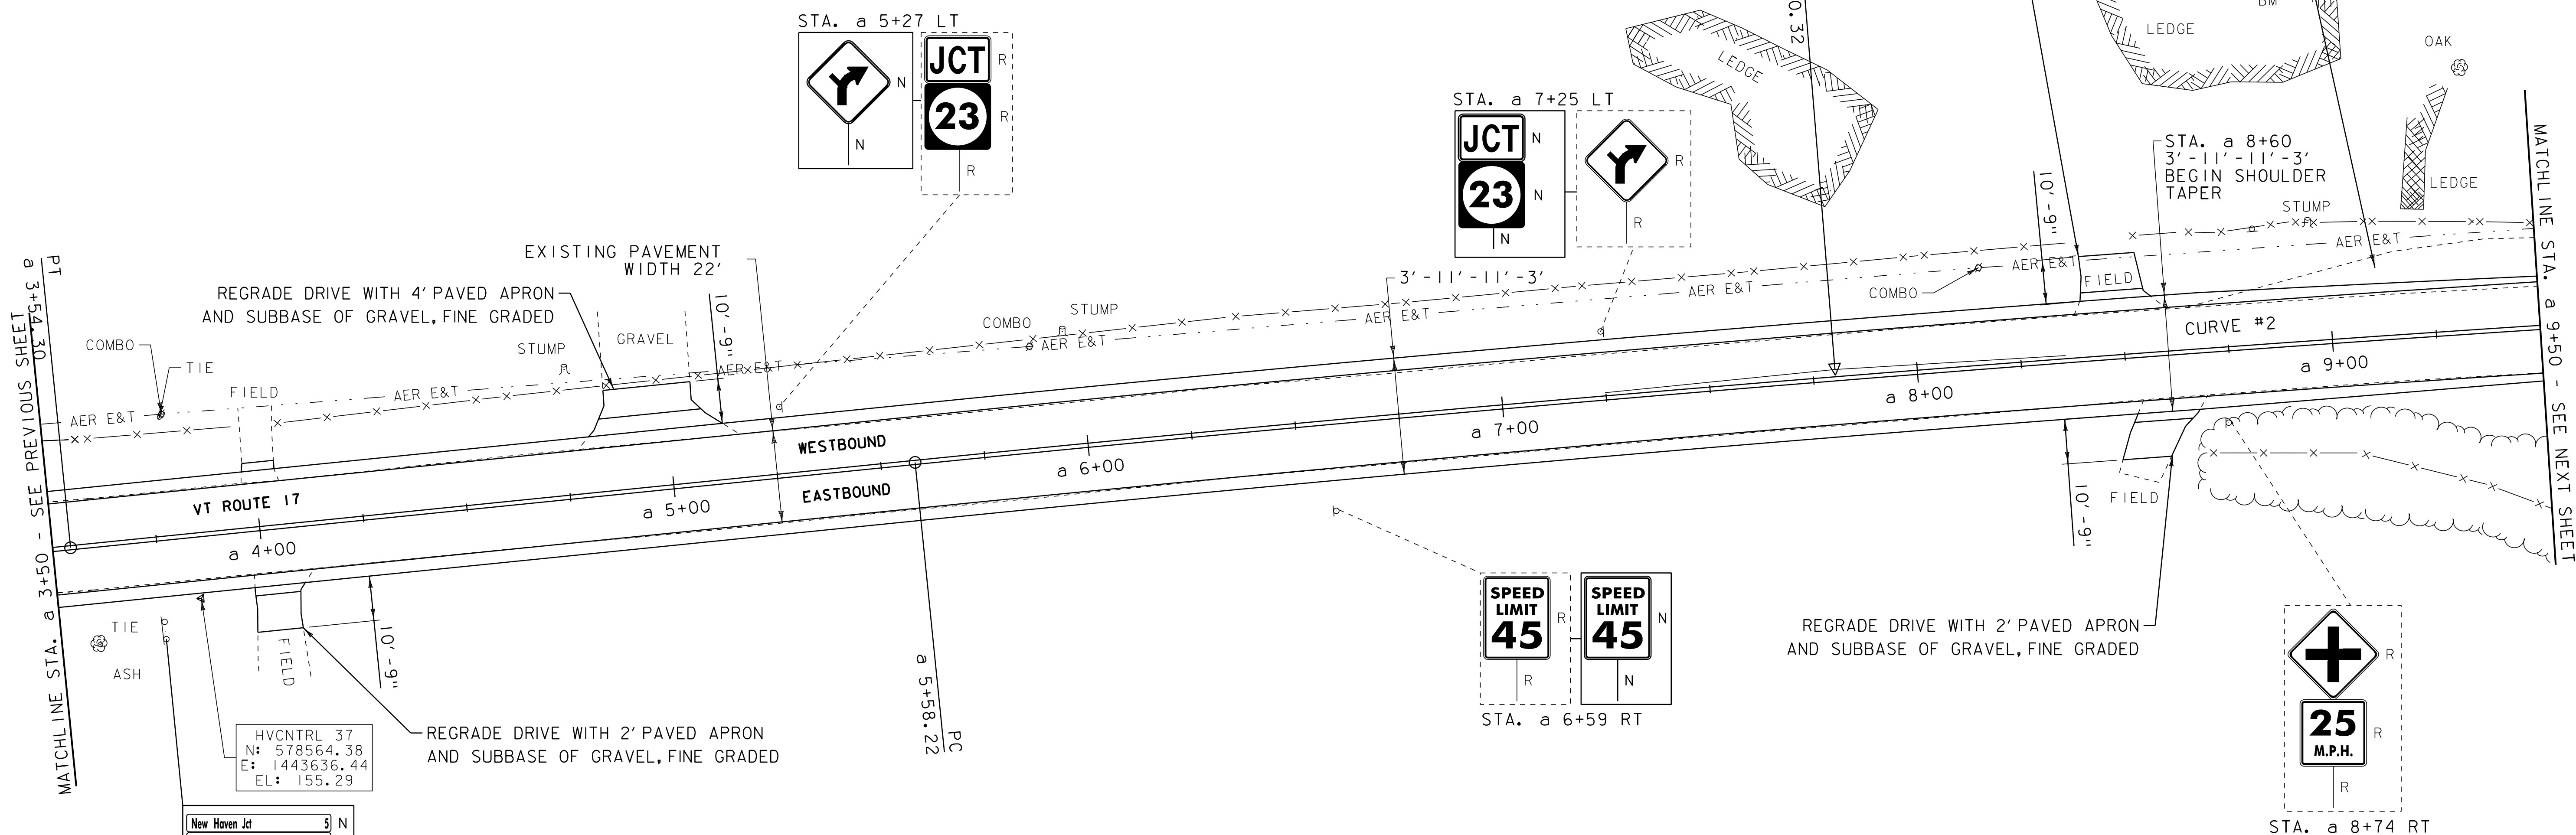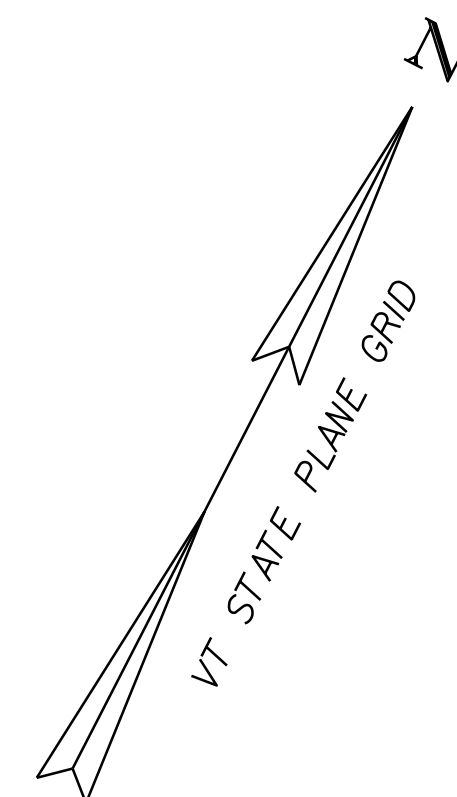

**ENVIRONMENTALLY SENSITIVE LOCATIONS:**

NO.	LIMITS	POS.	TYPE
12.	STA. a 5+25 - STA. a 7+00	LT	EM

KEY:  
 EM - EMERGENT WETLAND  
 FO - FORESTED WETLAND  
 SS - SCRUB-SHRUB WETLAND


**SIGN LEGEND**

R = REMOVE  
 R&S = REMOVE AND SALVAGE  
 RET = RETAIN  
 S = SALVAGE  
 N = NEW  
 B-B = BACK TO BACK

REMOVING SIGNS  
 AS SHOWN - 6

- LEGEND**
- SIGN
  - HYDRANT
  - MANHOLE
  - GATE VALVE
  - GAS PIPELINE MARKER
  - CATCH BASIN / DROP INLET
  - CURB INLET
  - BORING LOCATION
  - MAILBOX
  - UTILITY POLE
  - FLUSHING BASIN

DATUM  
 NAVD 88  
 NAD 83

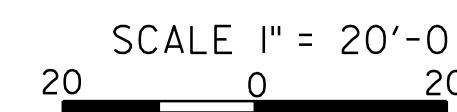

**PROJECT LAYOUT SHEET 27**

PROJECT NAME: ADDISON - NEW HAVEN

PROJECT NUMBER: STP 9632(1)

FILE NAME: p95B076.dgn  
 PROJECT LEADER: CDL  
 DESIGNED BY: SJL  
 PLOT FILE: p95B076.50.i

PLOT DATE: 3/13/2012  
 DRAWN BY: SJL  
 CHECKED BY: EPD  
 SHEET 50 OF 186