

DURABLE 4 INCH WHITE LINE (SEE OPTION ITEMS)
 STA. b 3+75 - STA. b 8+75 (SOLID LT & RT)

TEMPORARY 4 INCH WHITE LINE, PAINT
 STA. b 3+75 - STA. b 8+75 (SOLID LT & RT)

CURVE #1
 DELTA = 39°27'26"
 D = 13°19'29" (1) D = 8°33'06" (2)
 R = 430.00' (1) R = 670.00' (2)
 T = 161.73' (1) T = 196.07' (2)
 L = 210.14' (1) L = 133.98' (2)
 BANKING 0.08 FT/FT , 0.08 FT/FT
 RUNOFF 180' , 170' (45 MPH)
 SEE SUPERELEVATION DIAGRAMS
 FOR BANKING INFORMATION

DURABLE 4 INCH YELLOW LINE (SEE OPTION ITEMS)
 STA. b 3+75 - STA. b 8+75 (SOLID LT & RT)

TEMPORARY 4 INCH YELLOW LINE, PAINT
 STA. b 3+75 - STA. b 8+75 (SOLID LT & RT)

STONE FILL, TYPE I
 STA. b 3+75 - STA. b 4+75 RT
 STA. b 3+80 - STA. b 4+95 LT

GRUBBING MATERIAL
 STA. b 3+75 - STA. b 4+75 RT
 STA. b 3+80 - STA. b 4+95 LT

GEOTEXTILE FOR SILT FENCE
 STA. b 3+75 - STA. b 4+75 RT
 STA. b 3+80 - STA. b 4+95 LT

GEOTEXTILE UNDER STONE FILL
 STA. b 3+75 - STA. b 4+75 RT
 STA. b 3+80 - STA. b 4+95 LT

STEEL BEAM GUARDRAIL, GALVANIZED W/8 FT POSTS


STA. b 3+75 - ~~STA. b 4+94 LT~~ B 5+03 LT
 STA. b 3+75 - ~~STA. b 5+37.75 RT~~ B 5+28 RT

ANCHOR FOR STEEL BEAM RAIL
~~STA. b 4+94 LT~~ - ~~STA. b 5+37.75 RT~~
 B 5+03 LT B 5+28 RT

REMOVAL AND DISPOSAL OF GUARDRAIL
 STA. b 3+75 - STA. b 4+95 LT
 STA. b 3+75 - STA. b 5+37.75 RT

REMOVING SIGNS
 AS SHOWN - 3

ERECTING SALVAGED SIGNS
 AS SHOWN - 1

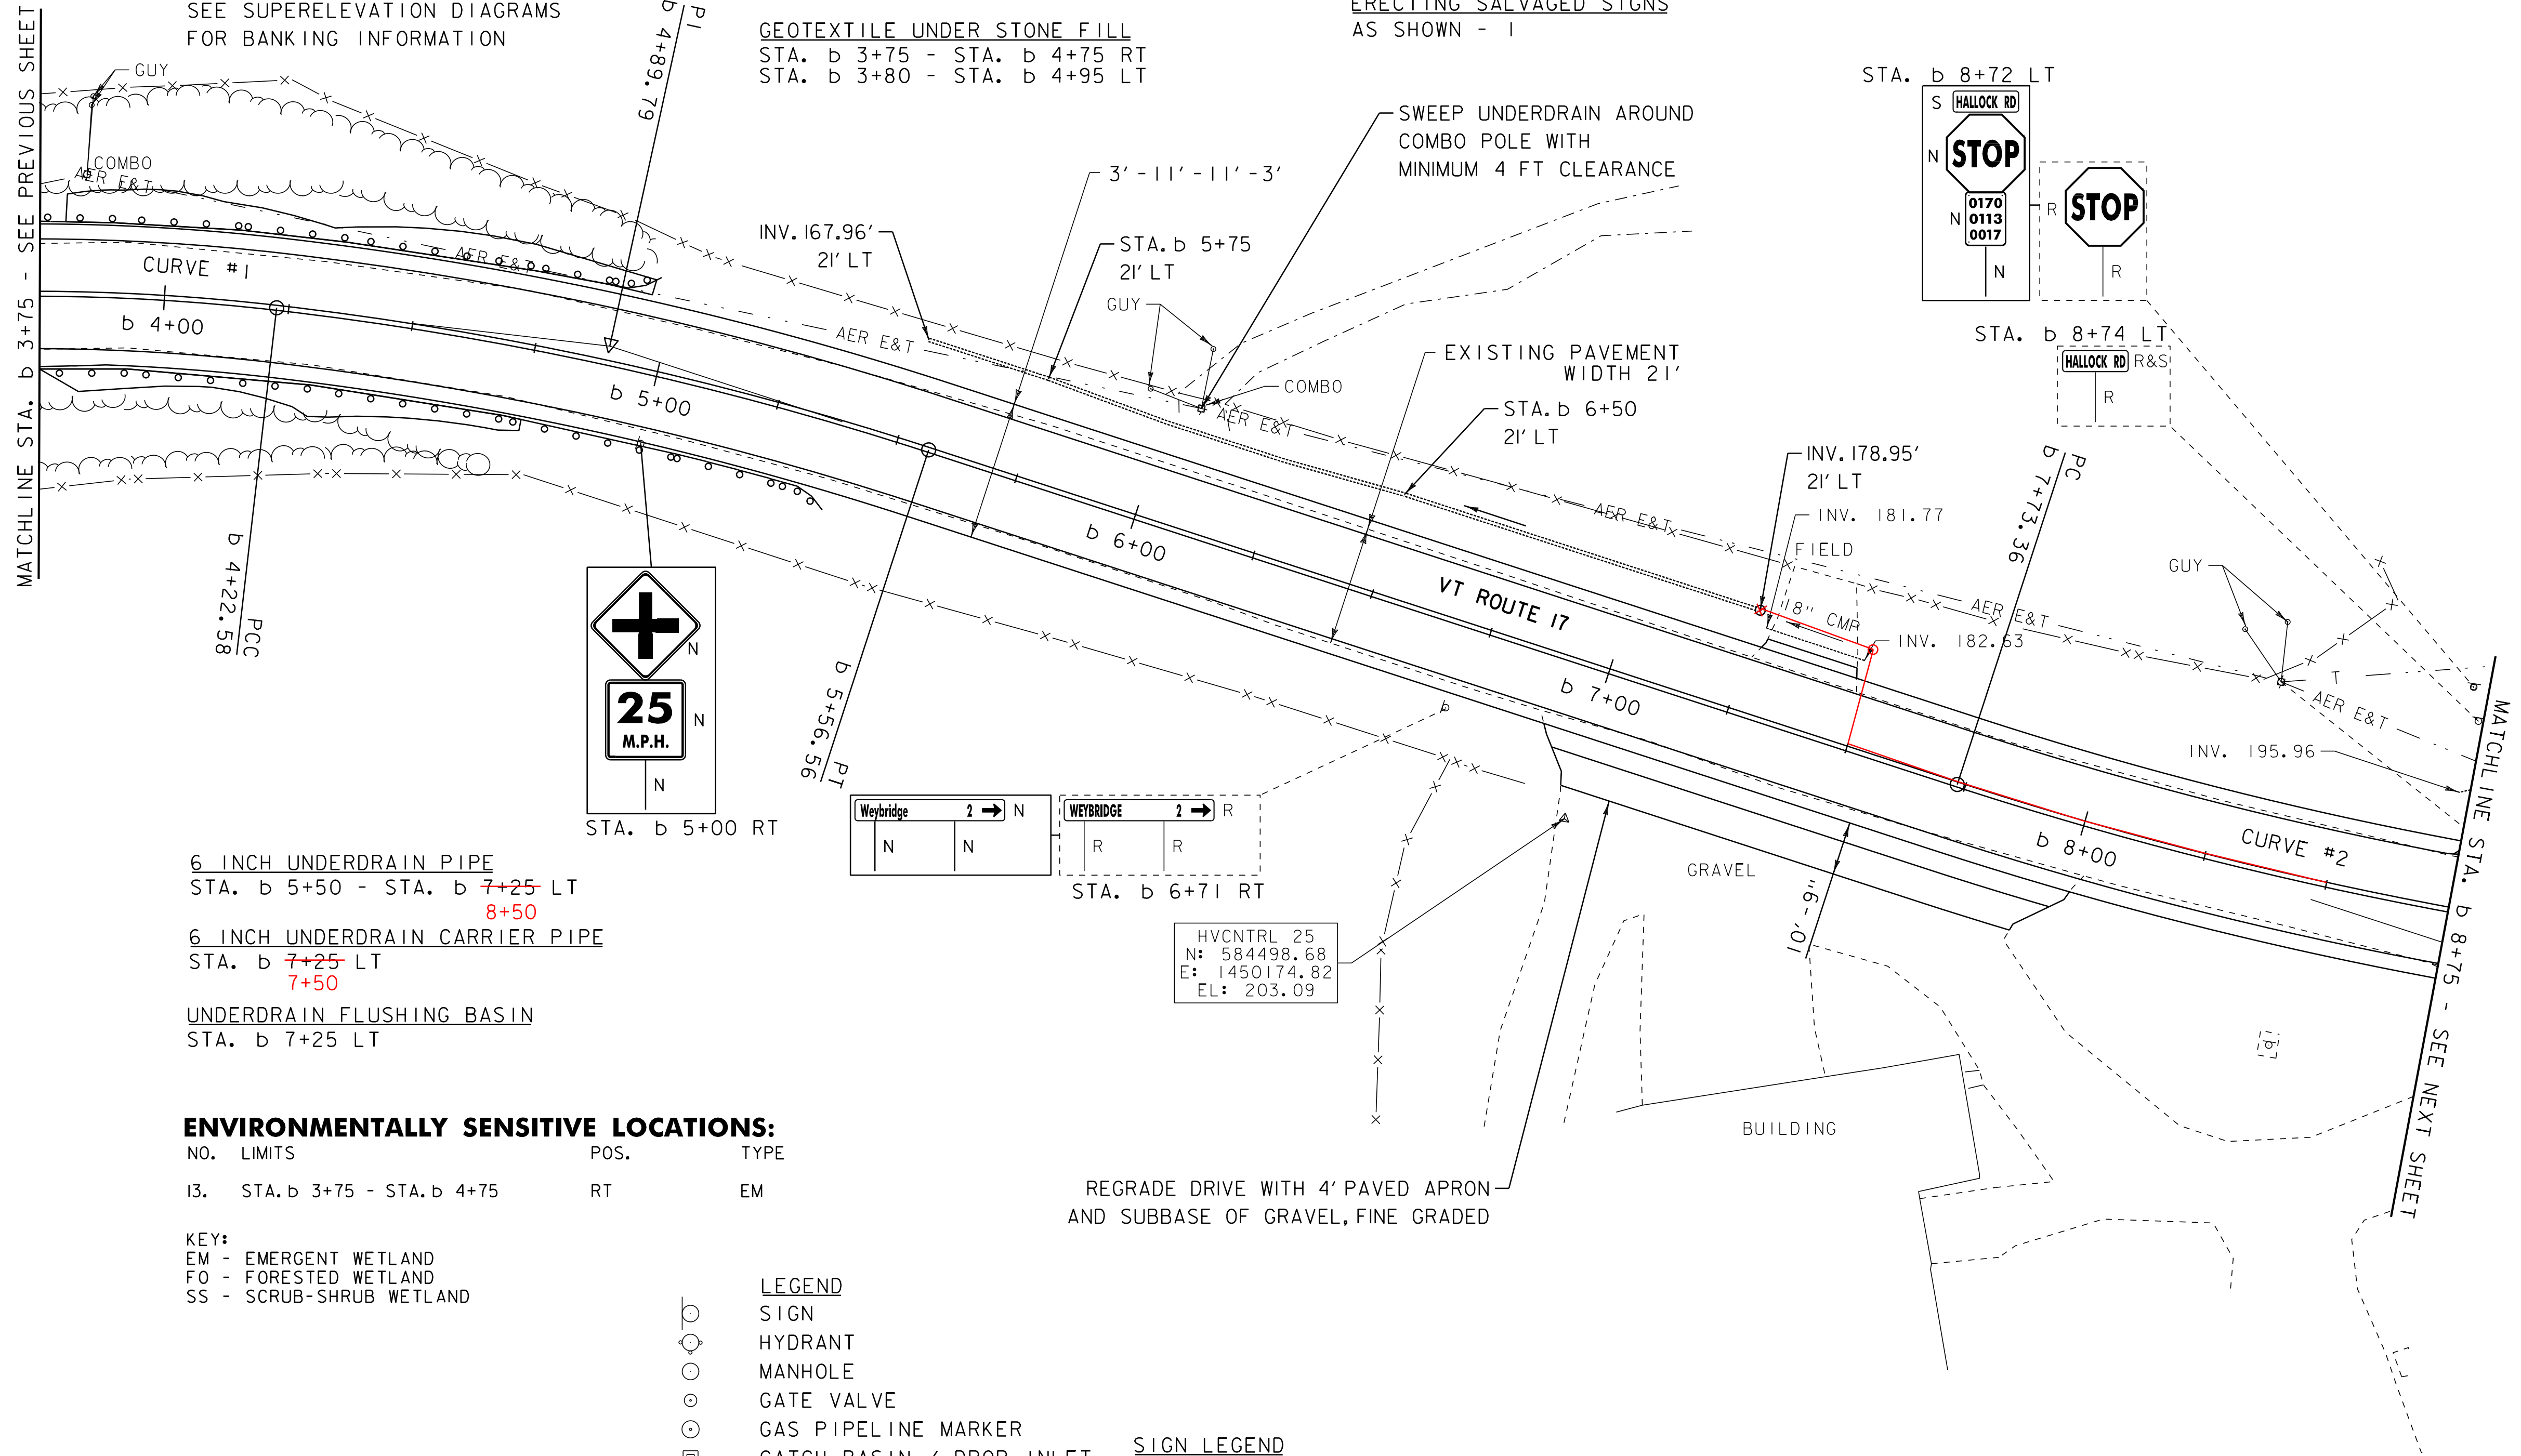

6 INCH UNDERDRAIN PIPE
 STA. b 5+50 - STA. b 7+25 LT
 8+50

6 INCH UNDERDRAIN CARRIER PIPE
 STA. b 7+25 LT
 7+50

UNDERDRAIN FLUSHING BASIN
 STA. b 7+25 LT


ENVIRONMENTALLY SENSITIVE LOCATIONS:

NO.	LIMITS	POS.	TYPE
13.	STA. b 3+75 - STA. b 4+75	RT	EM

KEY:
 EM - EMERGENT WETLAND
 FO - FORESTED WETLAND
 SS - SCRUB-SHRUB WETLAND

- LEGEND**
- SIGN
 - HYDRANT
 - MANHOLE
 - GATE VALVE
 - GAS PIPELINE MARKER
 - CATCH BASIN / DROP INLET
 - CURB INLET
 - BORING LOCATION
 - MAILBOX
 - UTILITY POLE
 - FLUSHING BASIN

- SIGN LEGEND**
- R = REMOVE
 - R&S = REMOVE AND SALVAGE
 - RET = RETAIN
 - S = SALVAGE
 - N = NEW
 - B-B = BACK TO BACK

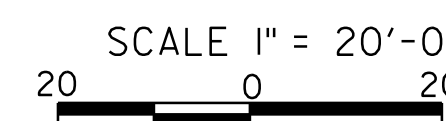

DATUM

NAVD 88
NAD 83

PROJECT LAYOUT SHEET 29

PROJECT NAME: ADDISON - NEW HAVEN
 PROJECT NUMBER: STP 9632(1)

FILE NAME: p95B076.dgn
 PROJECT LEADER: CDL
 DESIGNED BY: SJL
 PLOT FILE: p95B076_52.1

PLOT DATE: 3/13/2012
 DRAWN BY: SJL
 CHECKED BY: EPD
 SHEET 52 OF 186

