

THINNING AND TRIMMING
STA. b 10+75 - STA. b 14+75 LT

DURABLE 4 INCH WHITE LINE (SEE OPTION ITEMS)
STA. b 8+75 - STA. b 14+75 (SOLID LT & RT)
(WITH EDGELINE BREAKS AT TH #1)
STA. b 9+18 LT (EDGELINES TH #1)
STA. b 9+25 RT (EDGELINES TH #1)

DURABLE 4 INCH YELLOW LINE (SEE OPTION ITEMS)
STA. b 8+75 - STA. b 14+75 (SOLID LT & RT)
(WITH CENTERLINE BREAKS AT TH #1)
STA. b 9+18 LT (CENTERLINE TH #1)
STA. b 9+25 RT (CENTERLINE TH #1)

TEMPORARY 4 INCH WHITE LINE, PAINT
STA. b 8+75 - STA. b 14+75 (SOLID LT & RT)
(WITH EDGELINE BREAKS AT TH #1)
STA. b 9+18 LT (EDGELINES TH #1)
STA. b 9+25 RT (EDGELINES TH #1)


TEMPORARY 4 INCH YELLOW LINE, PAINT
STA. b 8+75 - STA. b 14+75 (SOLID LT & RT)
(WITH CENTERLINE BREAKS AT TH #1)
STA. b 9+18 LT (CENTERLINE TH #1)
STA. b 9+25 RT (CENTERLINE TH #1)

DURABLE 24 INCH STOP BAR (SEE OPTION ITEMS)
STA. b 8+87 - STA. b 9+00 LT (TH #1)
STA. b 9+27 - STA. b 9+37 RT (TH #1)

DURABLE LETTER OR SYMBOL (SEE OPTION ITEMS)
STA. b 8+90 LT "STOP" (TH #1)
STA. b 9+35 RT "STOP" (TH #1)

TEMPORARY 24 INCH STOP BAR, PAINT
STA. b 8+87 - STA. b 9+00 LT (TH #1)
STA. b 9+27 - STA. b 9+37 RT (TH #1)

TEMPORARY LETTER OR SYMBOL, PAINT
STA. b 8+90 LT "STOP" (TH #1)
STA. b 9+35 RT "STOP" (TH #1)

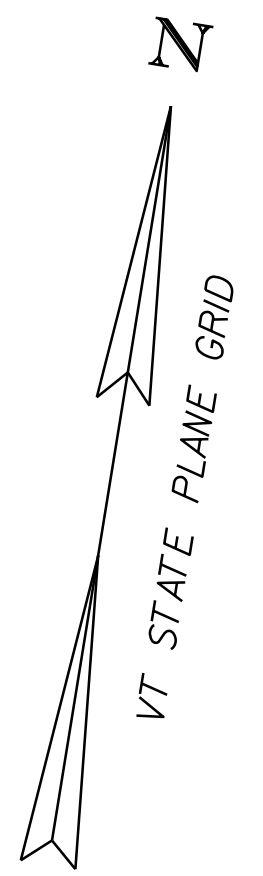


STONE FILL, TYPE I
STA. b 10+75 - STA. b 13+75 RT

GRUBBING MATERIAL
STA. b 10+75 - STA. b 13+75 RT

GEOTEXTILE FOR SILT FENCE
STA. b 10+75 - STA. b 13+75 RT

GEOTEXTILE UNDER STONE FILL
STA. b 10+75 - STA. b 13+75 RT

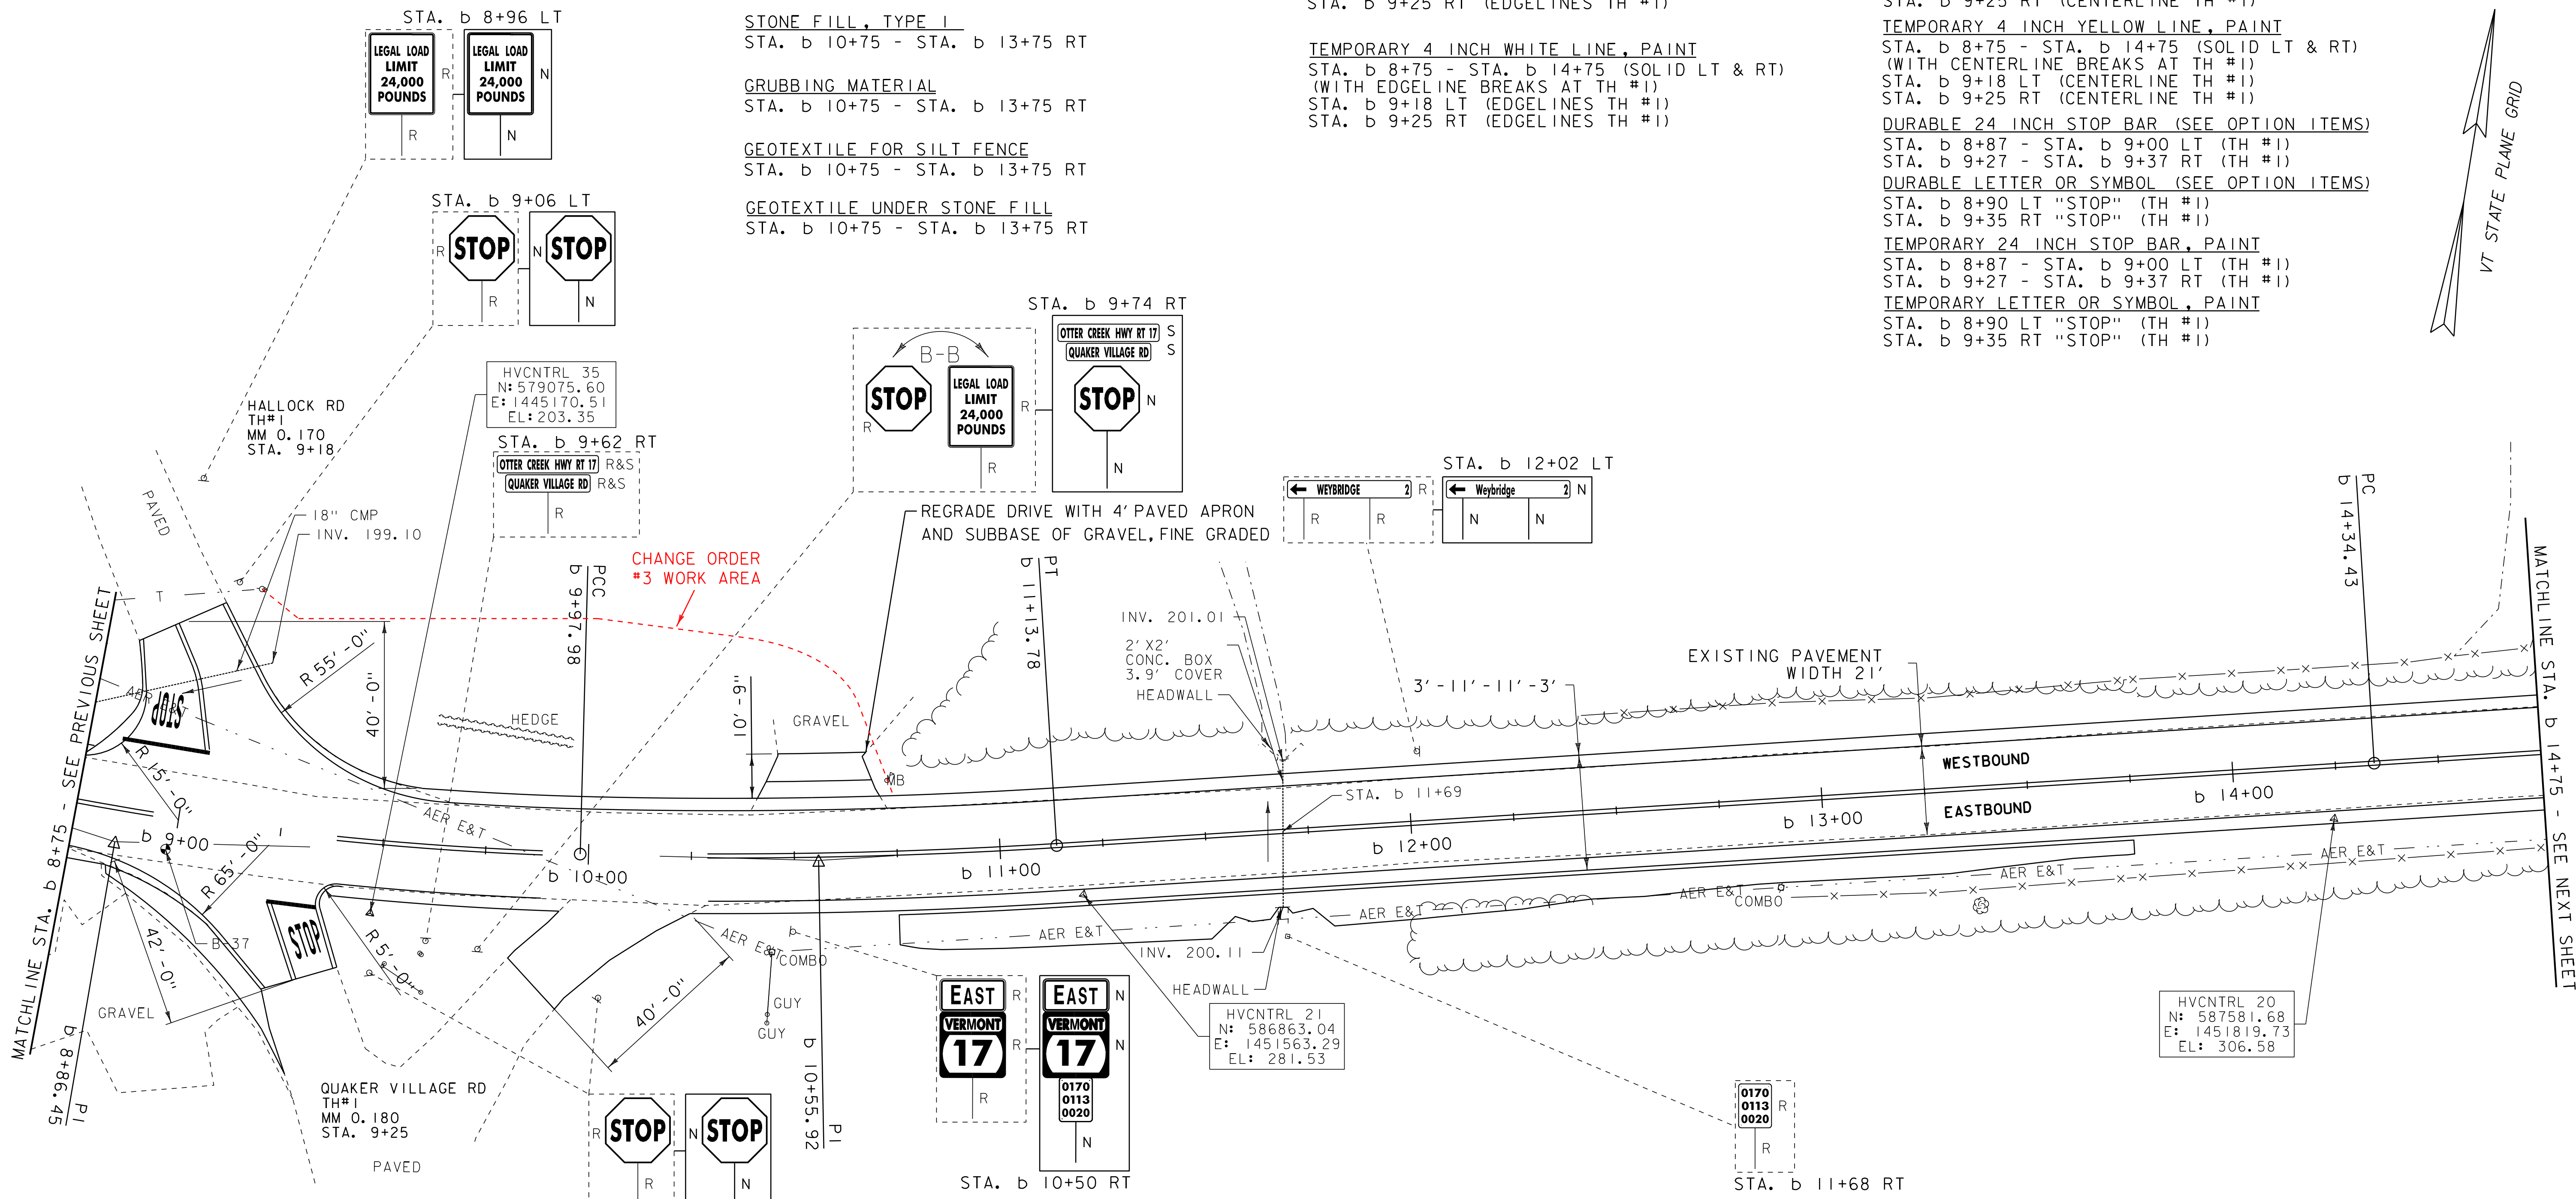

CURVE #2
DELTA = 21°36'13"
D = 7°20'44" (1) D = 4°24'27" (2)
R = 780.00' (1) R = 1300.00' (2)
T = 154.42' (1) T = 189.87' (2)
L = 224.62' (1) L = 115.80' (2)
BANKING 0.076 FT/FT , 0.058 FT/FT
RUNOFF 170' , 140' (45 MPH)
SEE SUPERELEVATION DIAGRAMS
FOR BANKING INFORMATION

- LEGEND**
- SIGN
 - HYDRANT
 - MANHOLE
 - GATE VALVE
 - GAS PIPELINE MARKER
 - CATCH BASIN / DROP INLET
 - CURB INLET
 - BORING LOCATION
 - MAILBOX
 - UTILITY POLE
 - FLUSHING BASIN

- SIGN LEGEND**
- R = REMOVE
 - R&S = REMOVE AND SALVAGE
 - RET = RETAIN
 - S = SALVAGE
 - N = NEW
 - B-B = BACK TO BACK

REMOVING SIGNS
AS SHOWN - 13
ERECTING SALVAGED SIGNS
AS SHOWN - 3

DATUM
NAVD 88
NAD 83

SCALE 1" = 20'-0"
20 0 20

PROJECT LAYOUT SHEET 30	PROJECT NAME: ADDISON - NEW HAVEN
	PROJECT NUMBER: STP 9632(1)
	FILE NAME: p95B076.dgn
	PLOT DATE: 3/13/2012
	PROJECT LEADER: CDL
	DESIGNED BY: SJL
	PLOT FILE: p95B076.53.1
	DRAWN BY: SJL
	CHECKED BY: EPD
	SHEET 53 OF 186