

DURABLE 4 INCH WHITE LINE (SEE OPTION ITEMS)
 STA. b 25+75 - STA. b 31+50 (SOLID LT & RT)


TEMPORARY 4 INCH WHITE LINE, PAINT
 STA. b 25+75 - STA. b 31+50 (SOLID LT & RT)

DURABLE 4 INCH YELLOW LINE (SEE OPTION ITEMS)
 STA. b 25+75 - STA. b 31+50 (SOLID LT, DASHED RT)

TEMPORARY 4 INCH YELLOW LINE, PAINT
 STA. b 25+75 - STA. b 31+50 (SOLID LT, DASHED RT)

6 INCH UNDERDRAIN PIPE
 STA. b ~~30+25~~ - STA. b 31+50 LT
 30+20
 B 28+27 - B 30+07 LT



CURVE #8
 DELTA = 0°21'43"
 D = 0°11'28"
 R = 30000.00'
 T = 94.74'
 L = 189.47'
 NORMAL CROWN

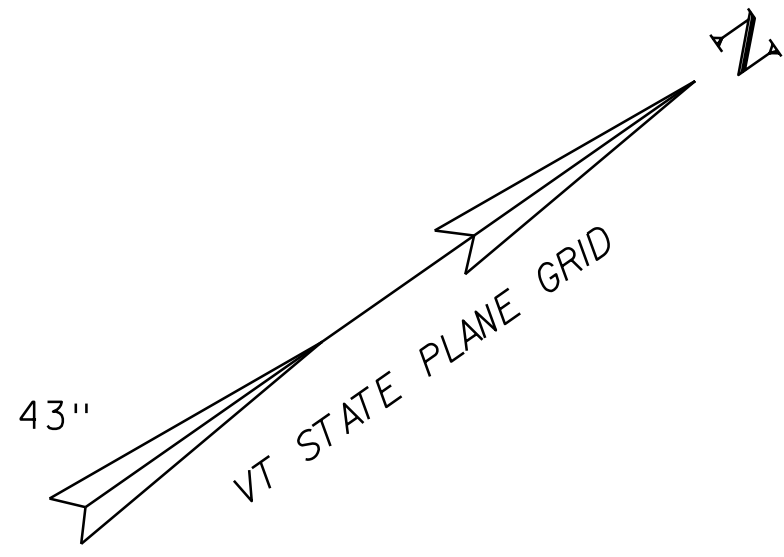

2 STA. b 26+25.75 LT 19.38' TO
 STA. b 26+25.82 LT 16.38'
 EXTEND 18" CPEP (3'-0")
 PROPOSED INV. IN = 209.10'
 EXISTING INV. IN = 208.98'
 ADD TYPE I STONE FILL
 AROUND INLET

3 STA. b 30+13.35 LT 16.78' TO
 STA. b 30+13.55 LT 18.77'
 EXTEND 18" CSP (2'-0")
 PROPOSED INV. IN = 206.02'
 EXISTING INV. IN = 205.85'

STA. b 31+28 LT

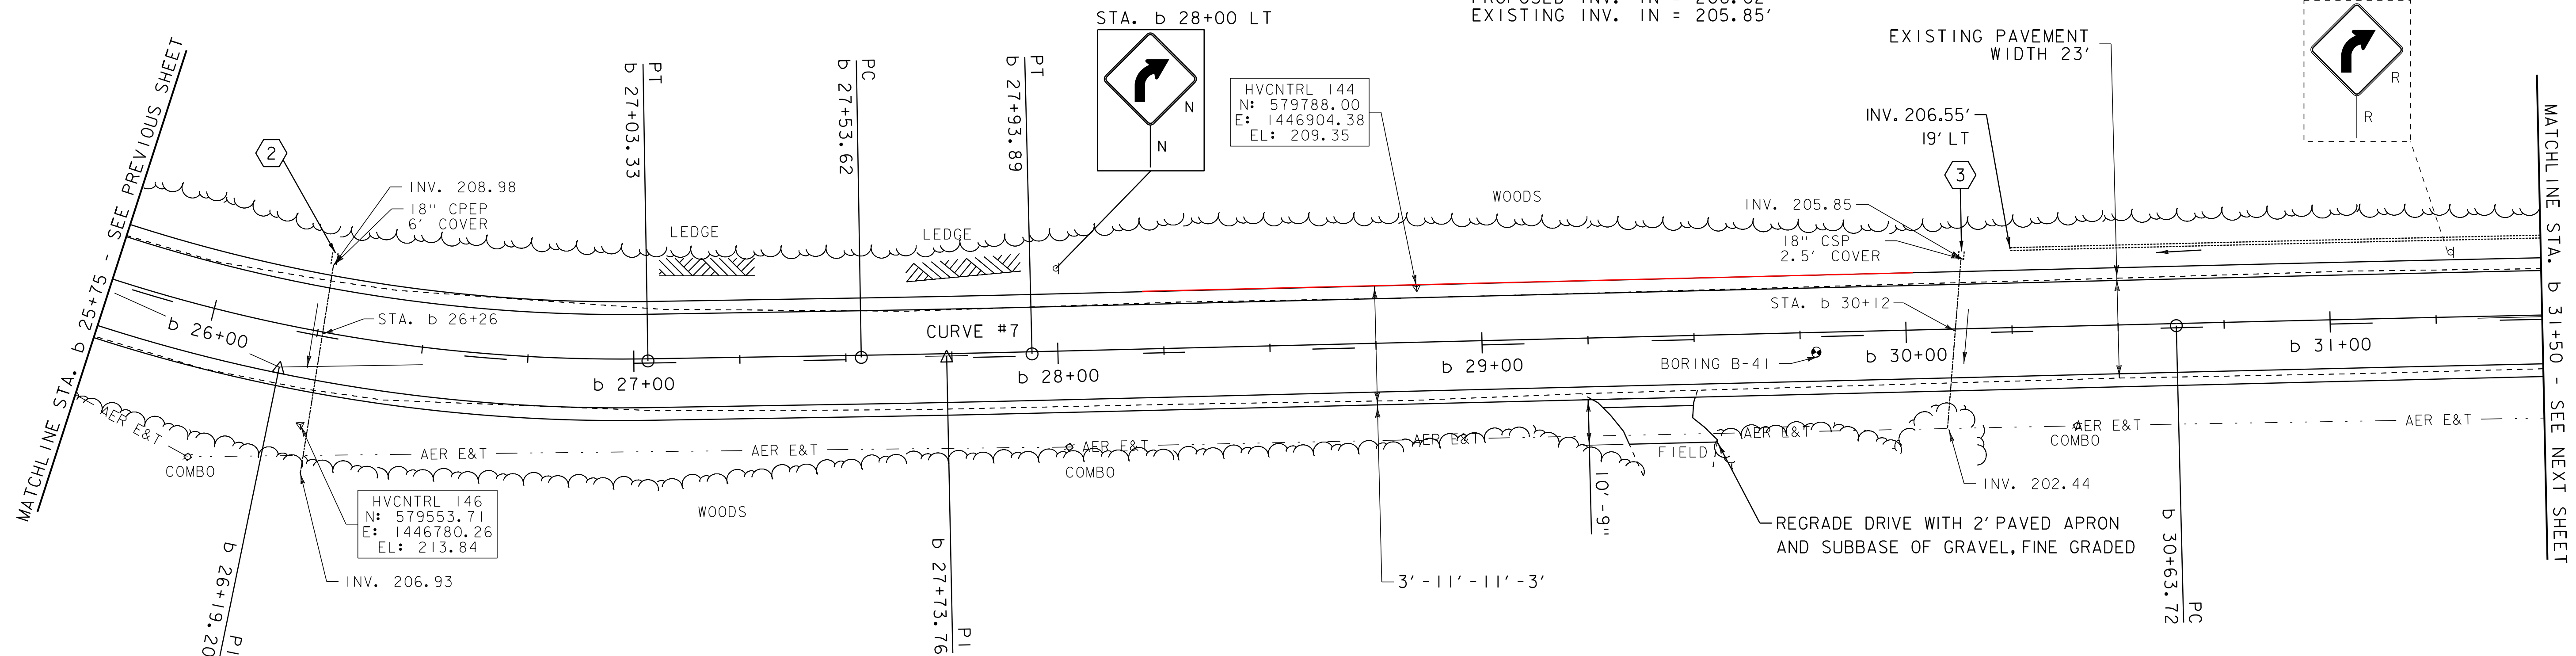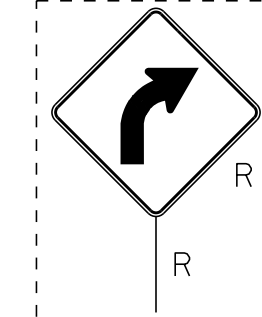

CURVE #7
 DELTA = 0°27'41"
 D = 1°08'45"
 R = 5000.00'
 T = 20.13'
 L = 40.27'
 NORMAL CROWN

REMOVING SIGNS
 AS SHOWN - I

- LEGEND**
- SIGN
 - HYDRANT
 - MANHOLE
 - GATE VALVE
 - GAS PIPELINE MARKER
 - CATCH BASIN / DROP INLET
 - CURB INLET
 - BORING LOCATION
 - MAILBOX
 - UTILITY POLE
 - FLUSHING BASIN

- SIGN LEGEND**
- R = REMOVE
 - R&S = REMOVE AND SALVAGE
 - RET = RETAIN
 - S = SALVAGE
 - N = NEW
 - B-B = BACK TO BACK

DATUM
 NAVD 88
 NAD 83

SCALE 1" = 20'-0"

PROJECT LAYOUT SHEET 33

PROJECT NAME: ADDISON - NEW HAVEN
 PROJECT NUMBER: STP 9632(1)
 FILE NAME: p95B076.dgn
 PROJECT LEADER: CDL
 DESIGNED BY: SJL
 PLOT FILE: p95B076.56.i
 PLOT DATE: 3/13/2012
 DRAWN BY: SJL
 CHECKED BY: EPD
 SHEET 56 OF 186