

6 INCH UNDERDRAIN PIPE  
STA. b 31+50 - STA. b ~~33+75~~ LT 33+61

6 INCH UNDERDRAIN CARRIER PIPE  
STA. b 33+75 LT

UNDERDRAIN FLUSHING BASIN  
STA. b ~~33+75~~ LT  
b 33+61 LT

STONE FILL, TYPE I  
STA. b 36+75 - STA. b 37+25 RT

GRUBBING MATERIAL  
STA. b 36+75 - STA. b 37+25 RT

GEOTEXTILE FOR SILT FENCE  
STA. b 36+75 - STA. b 37+25 RT


GEOTEXTILE UNDER STONE FILL  
STA. b 36+75 - STA. b 37+25 RT

DURABLE 4 INCH WHITE LINE (SEE OPTION ITEMS)  
STA. b 31+50 - STA. b 37+25 (SOLID LT & RT)

TEMPORARY 4 INCH WHITE LINE, PAINT  
STA. b 31+50 - STA. b 37+25 (SOLID LT & RT)


DURABLE 4 INCH YELLOW LINE (SEE OPTION ITEMS)  
STA. b 31+50 - STA. b 32+25 (SOLID LT, DASHED RT)  
STA. b 32+25 - STA. b 37+25 (SOLID RT, DASHED LT)

TEMPORARY 4 INCH YELLOW LINE, PAINT  
STA. b 31+50 - STA. b 32+25 (SOLID LT, DASHED RT)  
STA. b 32+25 - STA. b 37+25 (SOLID RT, DASHED LT)

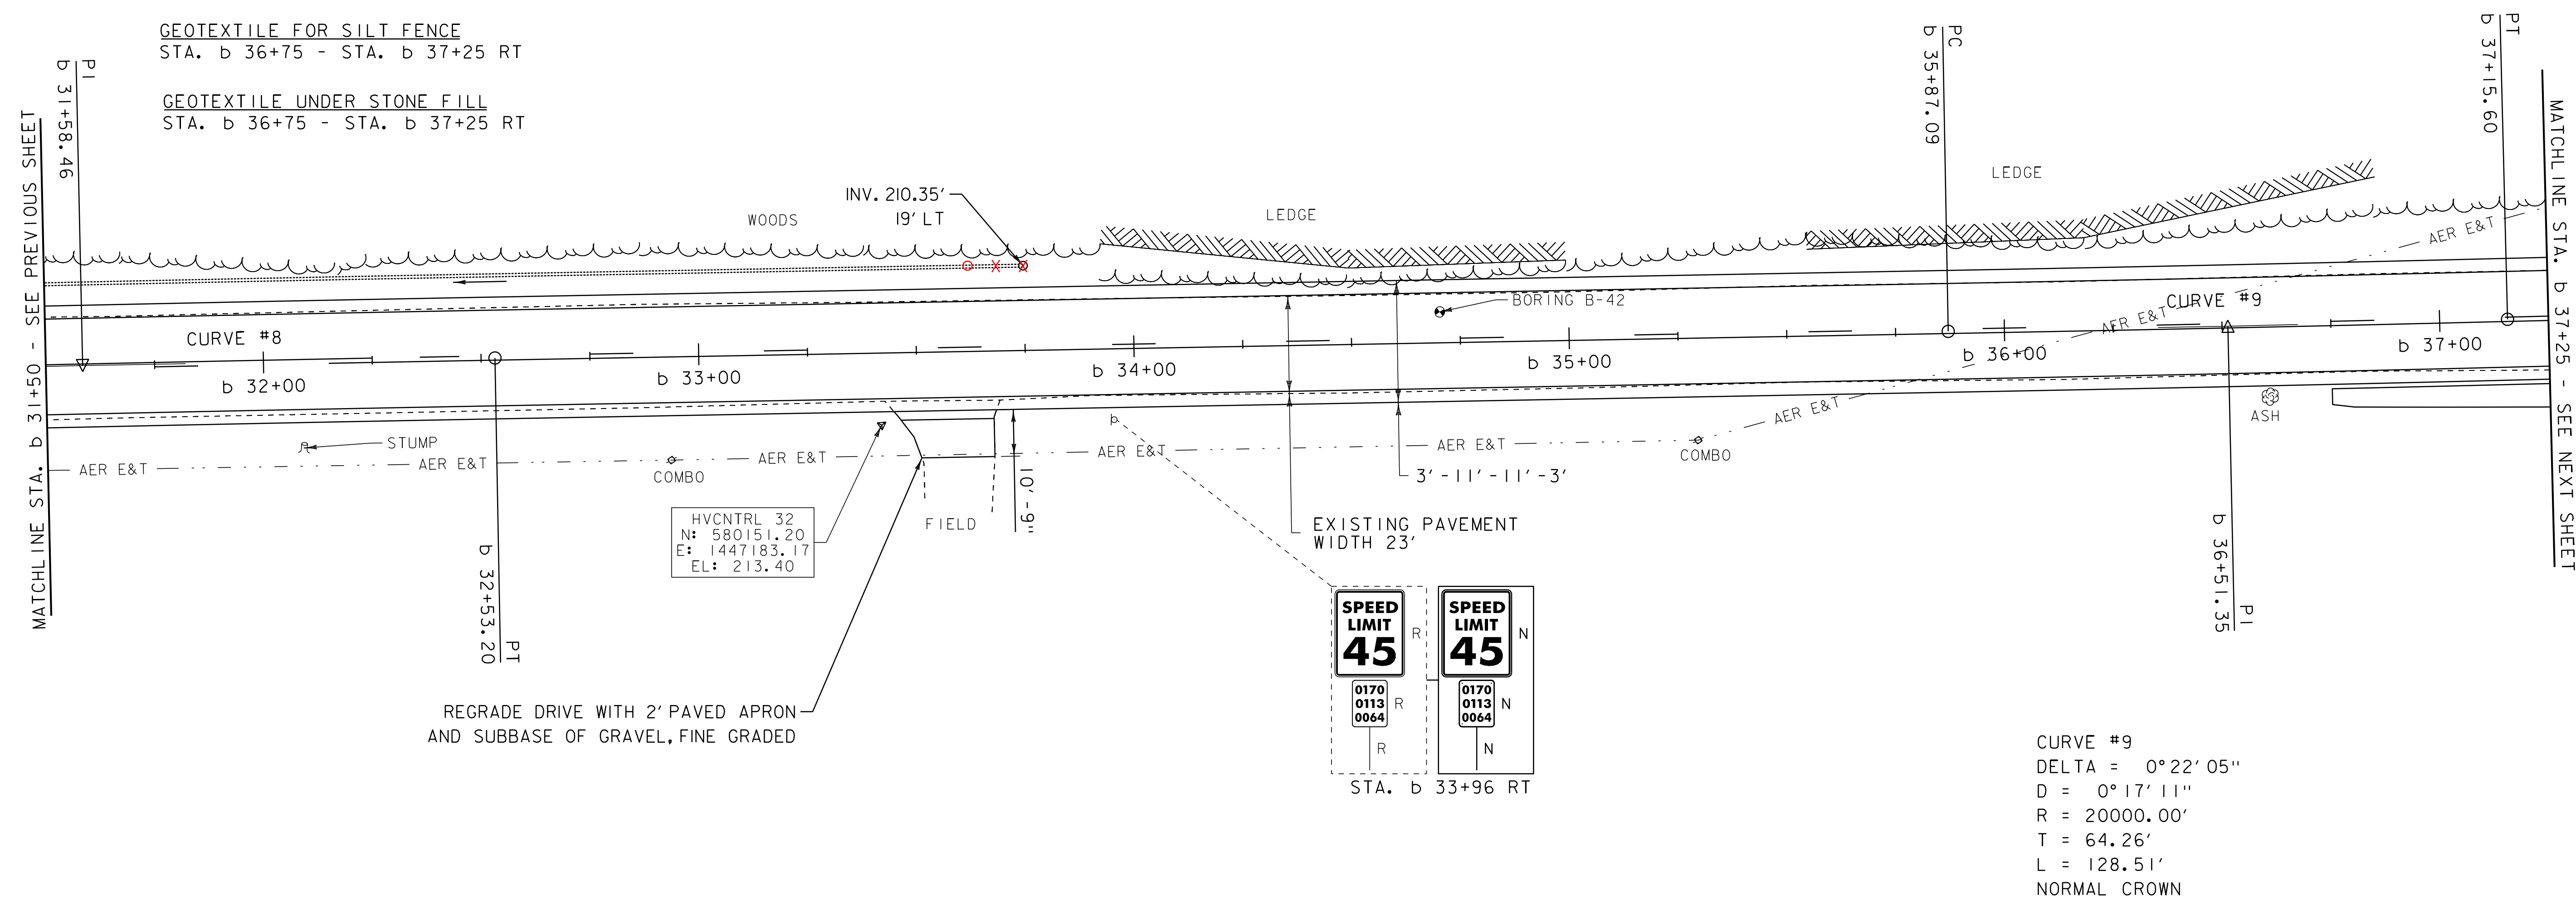

MATCHLINE STA. b 31+50 - SEE PREVIOUS SHEET

MATCHLINE STA. b 37+25 - SEE NEXT SHEET

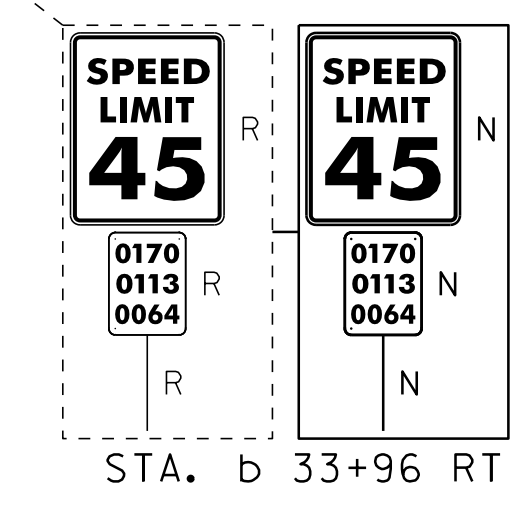


CURVE #9  
DELTA = 0° 22' 05"  
D = 0° 17' 11"  
R = 20000.00'  
T = 64.26'  
L = 128.51'  
NORMAL CROWN

REMOVING SIGNS  
AS SHOWN - 2

- LEGEND**
- SIGN
  - ⊙ HYDRANT
  - MANHOLE
  - ⊙ GATE VALVE
  - ⊙ GAS PIPELINE MARKER
  - ⊙ CATCH BASIN / DROP INLET
  - CURB INLET
  - ⊙ BORING LOCATION
  - ⊙ MAILBOX
  - ⊙ UTILITY POLE
  - ⊙ FLUSHING BASIN

- SIGN LEGEND**
- R = REMOVE
  - R&S = REMOVE AND SALVAGE
  - RET = RETAIN
  - S = SALVAGE
  - N = NEW
  - B-B = BACK TO BACK

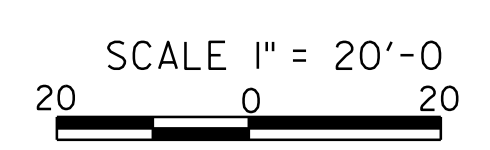

DATUM	NAVD 88
	NAD 83

<b>PROJECT LAYOUT SHEET 34</b>	PROJECT NAME: ADDISON - NEW HAVEN
	PROJECT NUMBER: STP 9632(1)
	FILE NAME: p95B076.dgn
	PLOT DATE: 3/13/2012
	PROJECT LEADER: CDL
	DESIGNED BY: SJL
	PLOT FILE: p95B076.57.1
	DRAWN BY: SJL
	CHECKED BY: EPD
	SHEET 57 OF 186