

DURABLE 4 INCH WHITE LINE (SEE OPTION ITEMS)
 STA. b 37+25 - STA. b 42+75 (SOLID LT & RT)

TEMPORARY 4 INCH WHITE LINE, PAINT
 STA. b 37+25 - STA. b 42+75 (SOLID LT & RT)

6 INCH UNDERDRAIN PIPE
 STA. b ~~41+50~~ - STA. b 42+75 LT
 41+48

6 INCH UNDERDRAIN CARRIER PIPE
 STA. b 41+50 LT

UNDERDRAIN FLUSHING BASIN
 STA. b ~~41+50~~ LT
 41+48

STONE FILL, TYPE I
 STA. b 37+25 - STA. b 40+25 RT

GRUBBING MATERIAL
 STA. b 37+25 - STA. b 40+25 RT



DURABLE 4 INCH YELLOW LINE (SEE OPTION ITEMS)
 STA. b 37+25 - STA. b 40+25 (DASHED LT, SOLID RT)
 STA. b 40+25 - STA. b 42+75 (SOLID LT & RT)

TEMPORARY 4 INCH YELLOW LINE, PAINT
 STA. b 37+25 - STA. b 40+25 (DASHED LT, SOLID RT)
 STA. b 40+25 - STA. b 42+75 (SOLID LT & RT)

GEOTEXTILE FOR SILT FENCE
 STA. b 37+25 - STA. b 40+25 RT

GEOTEXTILE UNDER STONE FILL
 STA. b 37+25 - STA. b 40+25 RT

CURVE #10
 DELTA = 0°40'30"
 D = 0°29'54"
 R = 11500.00'
 T = 67.75'
 L = 135.50'
 NORMAL CROWN

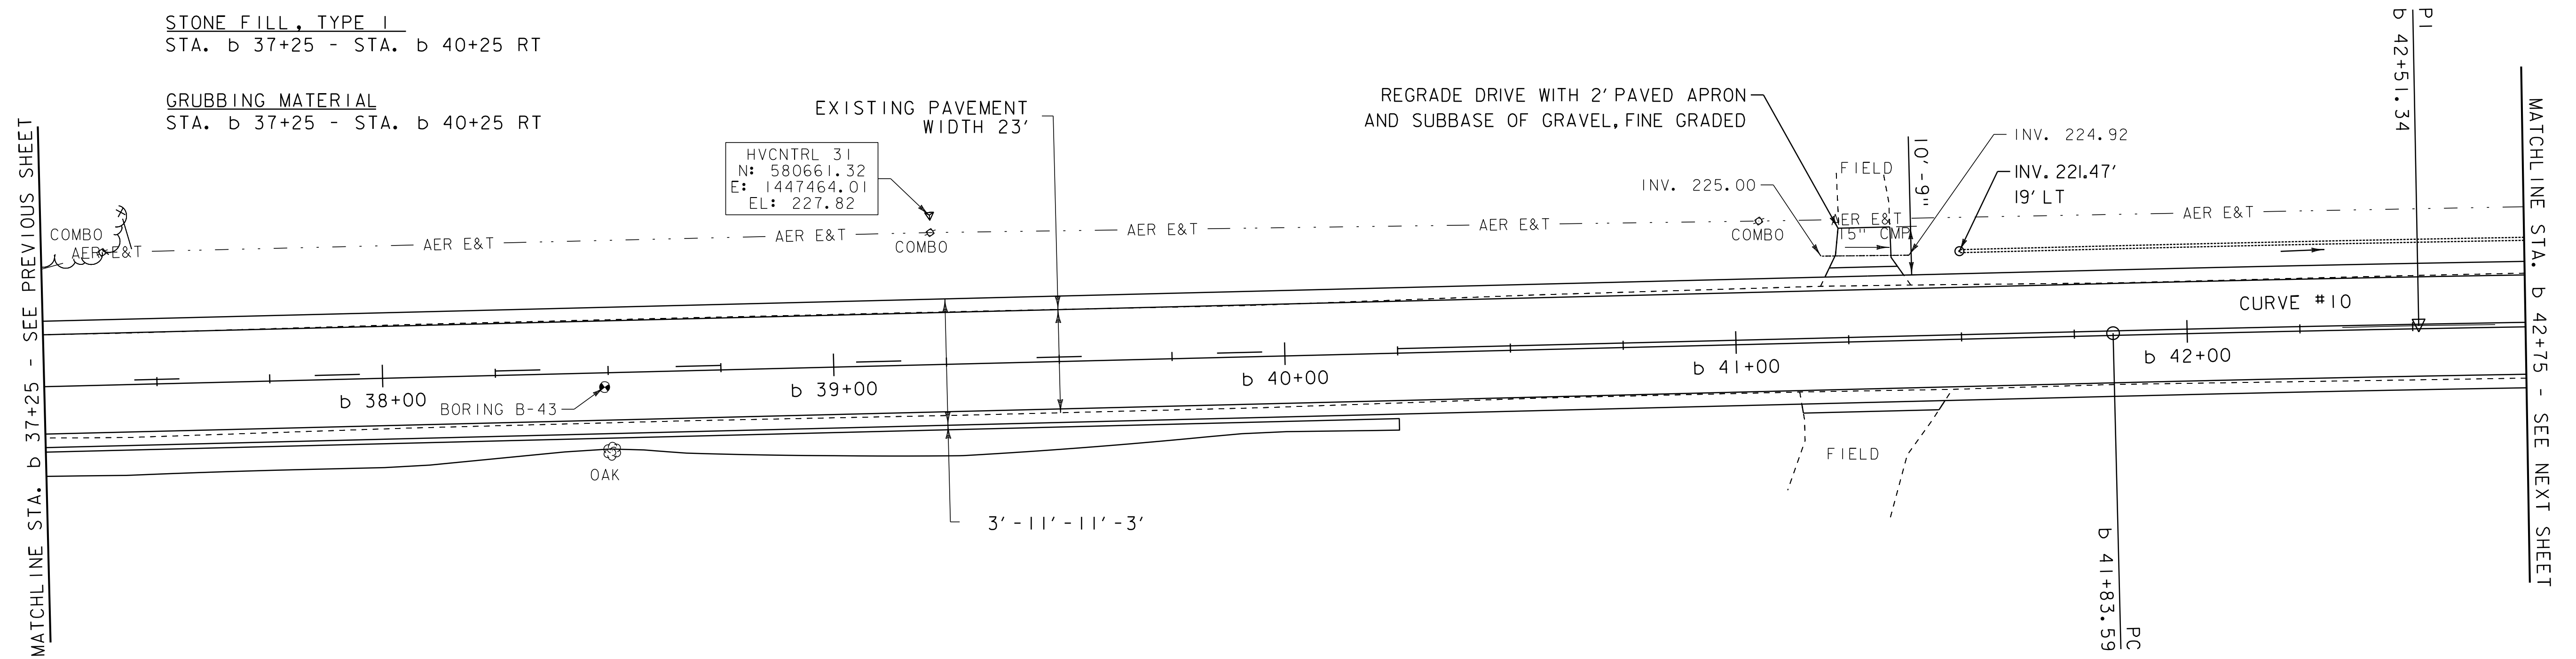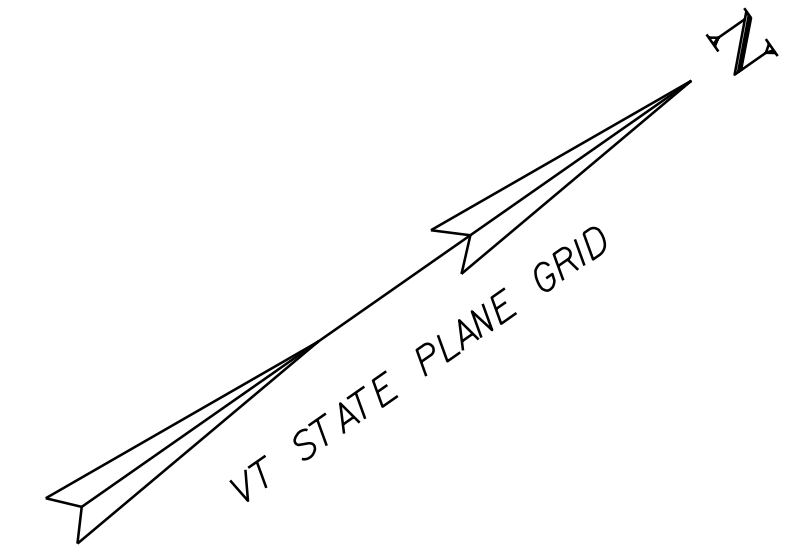

MATCHLINE STA. b 37+25 - SEE PREVIOUS SHEET

MATCHLINE STA. b 42+75 - SEE NEXT SHEET

HVCNTRL 31
 N: 580661.32
 E: 1447464.01
 EL: 227.82

- LEGEND**
- SIGN
 - HYDRANT
 - MANHOLE
 - GATE VALVE
 - GAS PIPELINE MARKER
 - CATCH BASIN / DROP INLET
 - CURB INLET
 - BORING LOCATION
 - MAILBOX
 - UTILITY POLE
 - FLUSHING BASIN

- SIGN LEGEND**
- R = REMOVE
 - R&S = REMOVE AND SALVAGE
 - RET = RETAIN
 - S = SALVAGE
 - N = NEW
 - B-B = BACK TO BACK

DATUM
 NAVD 88
 NAD 83

SCALE 1" = 20'-0"
 20 0 20

PROJECT LAYOUT SHEET 35	PROJECT NAME: ADDISON - NEW HAVEN	PLOT DATE: 3/13/2012
	PROJECT NUMBER: STP 9632(1)	DRAWN BY: SJL
	FILE NAME: p95B076.dgn	CHECKED BY: EPD
	PROJECT LEADER: CDL	SHEET 58 OF 186
	DESIGNED BY: SJL	
	PLOT FILE: p95B076.58.i	