

DURABLE 4 INCH WHITE LINE (SEE OPTION ITEMS)
 STA. b 48+50 - STA. b 54+50 (SOLID LT & RT)

TEMPORARY 4 INCH WHITE LINE, PAINT
 STA. b 48+50 - STA. b 54+50 (SOLID LT & RT)

DURABLE 4 INCH YELLOW LINE (SEE OPTION ITEMS)
 STA. b 48+50 - STA. b 52+25 (SOLID LT, DASHED RT)
 STA. b 52+25 - STA. b 54+00 (DASHED)
 STA. b 54+00 - STA. b 54+50 (DASHED LT, SOLID RT)



TEMPORARY 4 INCH YELLOW LINE, PAINT
 STA. b 48+50 - STA. b 52+25 (SOLID LT, DASHED RT)
 STA. b 52+25 - STA. b 54+00 (DASHED)
 STA. b 54+00 - STA. b 54+50 (DASHED LT, SOLID RT)

6 INCH UNDERDRAIN PIPE
 STA. b 53+00 - STA. b 54+50
 49+15
 REMOVING AND RESETTING FENCE
 STA. b 49+29 - STA. b 54+44 RT

UNDERDRAIN FLUSHING BASIN
 B 52+35 LT

CURVE #12
 DELTA = 0°46'01"
 D = 0°29'54"
 R = 11500.00'
 T = 76.97'
 L = 153.94'
 NORMAL CROWN

4 STA. b 49+08.17 LT 17.48' TO
 STA. b 49+08.25 LT 20.48'
 EXTEND 18" CPEP (3'-0")
 PROPOSED INV. IN = 218.23'
 EXISTING INV. IN = 218.12'

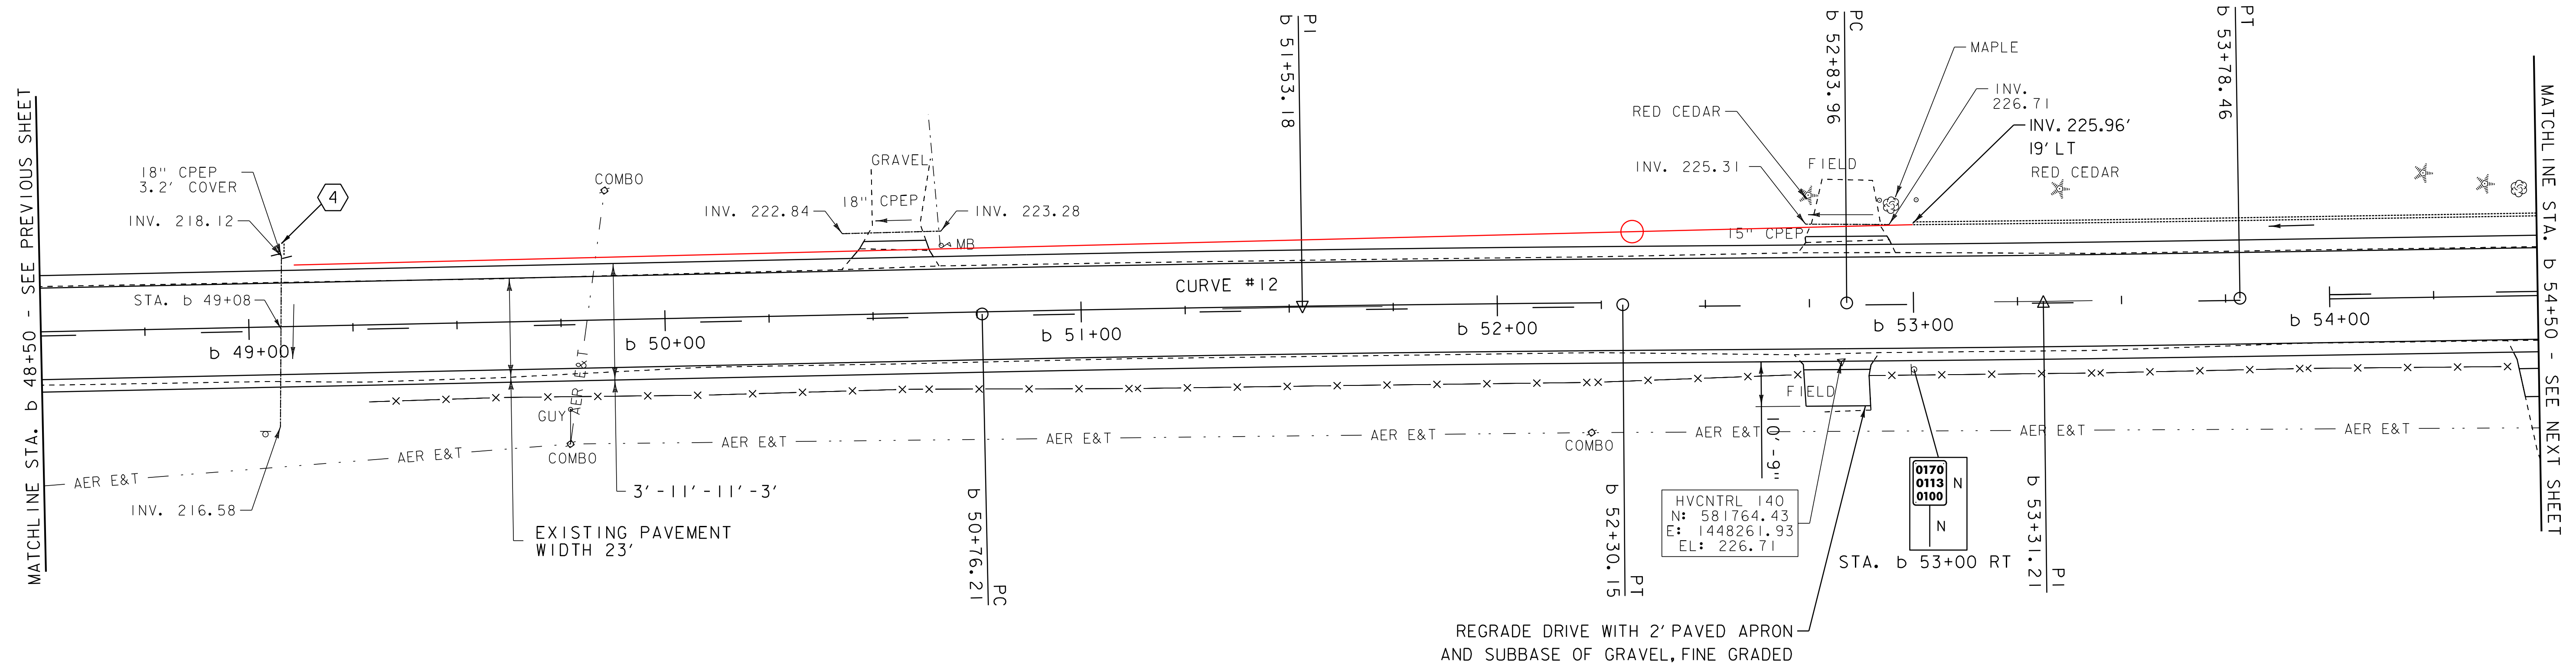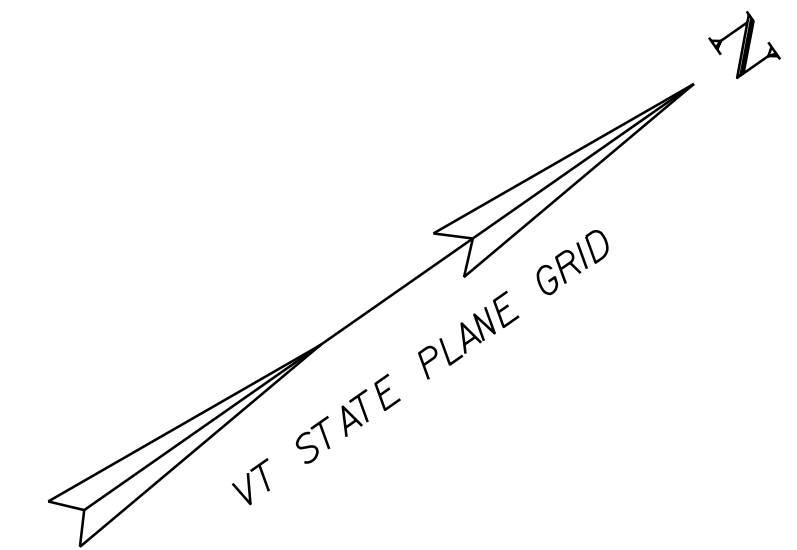

MATCHLINE STA. b 48+50 - SEE PREVIOUS SHEET


MATCHLINE STA. b 54+50 - SEE NEXT SHEET

- LEGEND**
- SIGN
 - ⊙ HYDRANT
 - MANHOLE
 - GATE VALVE
 - GAS PIPELINE MARKER
 - ⊠ CATCH BASIN / DROP INLET
 - CURB INLET
 - ⊙ BORING LOCATION
 - ⊙ MAILBOX
 - ⊙ UTILITY POLE
 - ⊙ FLUSHING BASIN

- SIGN LEGEND**
- R = REMOVE
 - R&S = REMOVE AND SALVAGE
 - RET = RETAIN
 - S = SALVAGE
 - N = NEW
 - B-B = BACK TO BACK

CURVE #13
 DELTA = 0°28'15"
 D = 0°29'54"
 R = 11500.00'
 T = 47.25'
 L = 94.50'
 NORMAL CROWN

DATUM
 NAVD 88
 NAD 83

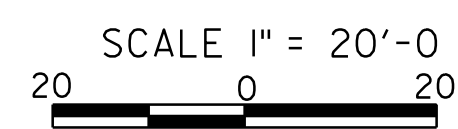

PROJECT LAYOUT SHEET 37	PROJECT NAME: ADDISON - NEW HAVEN	
	PROJECT NUMBER: STP 9632(1)	
	FILE NAME: p95B076.dgn	PLOT DATE: 3/13/2012
PROJECT LEADER: CDL	DRAWN BY: SJL	
DESIGNED BY: SJL	CHECKED BY: EPD	
PLOT FILE: p95B076_60.t	SHEET 60 OF 186	