

DURABLE 4 INCH WHITE LINE (SEE OPTION ITEMS)
 STA. b 54+50 - STA. b 60+25 (SOLID LT & RT)

TEMPORARY 4 INCH WHITE LINE, PAINT
 STA. b 54+50 - STA. b 60+25 (SOLID LT & RT)

6 INCH UNDERDRAIN PIPE
 STA. b 54+50 - STA. b ~~54+75~~ ⁵⁴⁺⁷⁰ LT

6 INCH UNDERDRAIN CARRIER PIPE
 STA. b 54+75 LT

UNDERDRAIN FLUSHING BASIN
 STA. b ~~54+75~~ ⁵⁴⁺⁷⁰ LT

STONE FILL, TYPE I
 STA. b 56+75 - STA. b 60+25 RT

GRUBBING MATERIAL
 STA. b 56+75 - STA. b 60+25 RT

GEOTEXTILE FOR SILT FENCE
 STA. b 56+75 - STA. b 60+25 RT



GEOTEXTILE UNDER STONE FILL
 STA. b 56+75 - STA. b 60+25 RT

DURABLE 4 INCH YELLOW LINE (SEE OPTION ITEMS)
 STA. b 54+50 - STA. b 60+25 (DASHED LT, SOLID RT)

TEMPORARY 4 INCH YELLOW LINE, PAINT
 STA. b 54+50 - STA. b 60+25 (DASHED LT, SOLID RT)

STEEL BEAM GUARDRAIL, GALVANIZED W/8 FEET POSTS
 STA. b 60+~~2.5~~ ¹⁰ - STA. b 60+25 RT

ANCHOR FOR STEEL BEAM RAIL
 STA. b 60+~~2.5~~ ¹⁰ RT

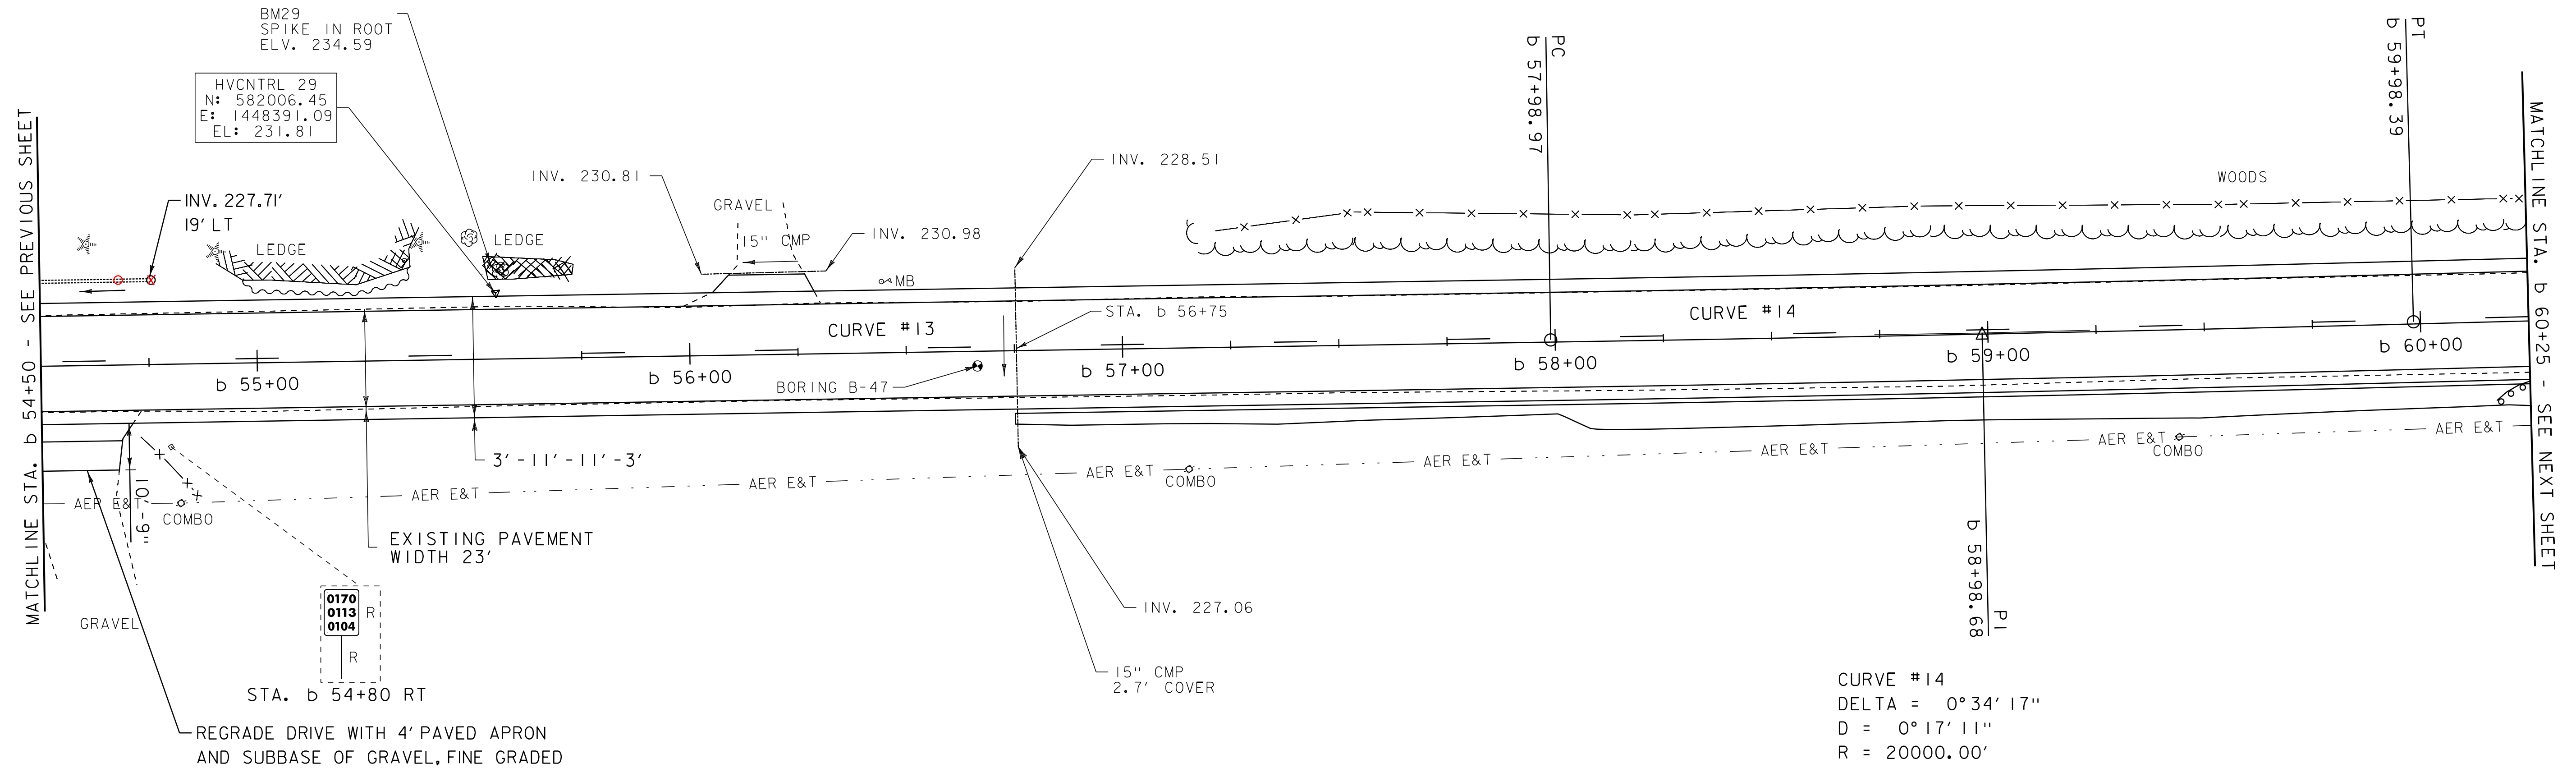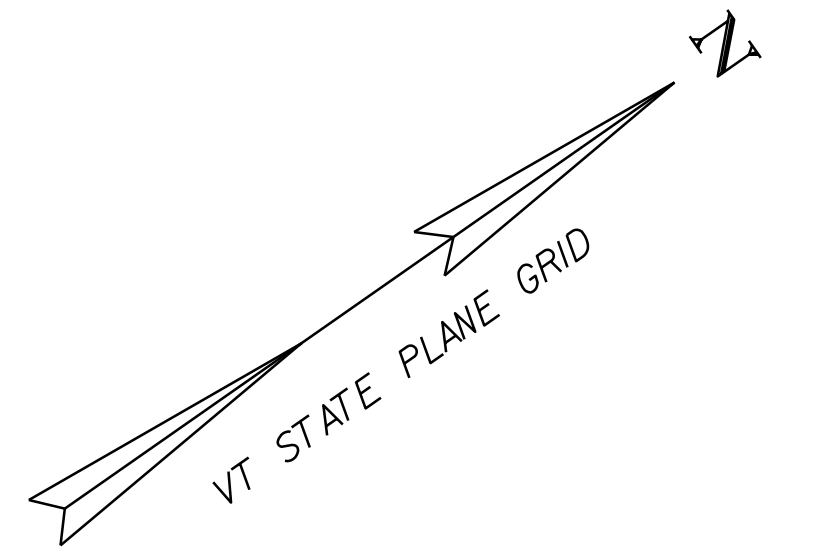

CURVE #14
 DELTA = 0° 34' 17"
 D = 0° 17' 11"
 R = 20000.00'
 T = 99.71'
 L = 199.42'
 NORMAL CROWN

REMOVING SIGNS
 AS SHOWN - 1

- LEGEND**
- SIGN
 - ⊙ HYDRANT
 - MANHOLE
 - GATE VALVE
 - GAS PIPELINE MARKER
 - ⊠ CATCH BASIN / DROP INLET
 - CURB INLET
 - ⊙ BORING LOCATION
 - ⊙ MAILBOX
 - ⊙ UTILITY POLE
 - ⊙ FLUSHING BASIN

- SIGN LEGEND**
- R = REMOVE
 - R&S = REMOVE AND SALVAGE
 - RET = RETAIN
 - S = SALVAGE
 - N = NEW
 - B-B = BACK TO BACK

DATUM
 NAVD 88
 NAD 83

SCALE 1" = 20'-0"
 20 0 20

PROJECT LAYOUT SHEET 38

PROJECT NAME: ADDISON - NEW HAVEN
 PROJECT NUMBER: STP 9632(1)

FILE NAME: p95B076.dgn
 PROJECT LEADER: CDL
 DESIGNED BY: SJL
 PLOT FILE: p95B076.plt

PLOT DATE: 3/13/2012
 DRAWN BY: SJL
 CHECKED BY: EPD
 SHEET 61 OF 186