

DURABLE 4 INCH WHITE LINE (SEE OPTION ITEMS)
 STA. b 65+75 - STA. b 71+50 (SOLID LT & RT)

TEMPORARY 4 INCH WHITE LINE, PAINT
 STA. b 65+75 - STA. b 71+50 (SOLID LT & RT)

GRUBBING MATERIAL
 STA. b 65+75 - STA. b 67+25 RT
 STA. b 67+50 - STA. b 68+75 LT

STONE FILL, TYPE I
 STA. b 65+75 - STA. b 67+25 RT
 STA. b 67+50 - STA. b 68+75 LT

DURABLE 4 INCH YELLOW LINE (SEE OPTION ITEMS)
 STA. b 65+75 - STA. b 71+50 (SOLID LT & RT)

TEMPORARY 4 INCH YELLOW LINE, PAINT
 STA. b 65+75 - STA. b 71+50 (SOLID LT & RT)

GEOTEXTILE FOR SILT FENCE
 STA. b 65+75 - STA. b 67+25 RT
 STA. b 67+50 - STA. b 68+75 LT

GEOTEXTILE UNDER STONE FILL
 STA. b 65+75 - STA. b 67+25 RT
 STA. b 67+50 - STA. b 68+75 LT

CURVE #16
 DELTA = 4°11'12"
 D = 1°16'24"
 R = 4500.00'
 T = 164.48'
 L = 328.81'
 BANKING 0.022 FT/FT
 140' RUNOFF (45 MPH)
 SEE SUPERELEVATION DIAGRAMS
 FOR BANKING INFORMATION

⑥ STA. b 68+09.39 LT 15.67' TO
 STA. b 68+09.40 LT 18.69'
 EXTEND 18" CSP (3'-0")
 PROPOSED INV. IN = 235.67'
 EXISTING INV. IN = 235.52'

EXISTING PAVEMENT
 WIDTH 25'

HVCNTRL 27
 N: 583289.81
 E: 1449003.3
 EL: 243.02

FAIR VIEW LN
 RET
 RET

ENVIRONMENTALLY SENSITIVE LOCATIONS:

| NO. | LIMITS | POS. | TYPE |
|-----|-----------------------------|------|------|
| 15. | STA. b 70+75 - STA. b 71+50 | LT | EM |

KEY:
 EM - EMERGENT WETLAND
 FO - FORESTED WETLAND
 SS - SCRUB-SHRUB WETLAND

SIGN LEGEND



R = REMOVE
 R&S = REMOVE AND SALVAGE
 RET = RETAIN
 S = SALVAGE
 N = NEW
 B-B = BACK TO BACK

LEGEND


- SIGN
- HYDRANT
- MANHOLE
- GATE VALVE
- GAS PIPELINE MARKER
- CATCH BASIN / DROP INLET
- CURB INLET
- BORING LOCATION
- ⌘ MAILBOX
- ⌘ UTILITY POLE
- FLUSHING BASIN

SEE PREVIOUS SHEET

MATCHLINE STA. b 71+50 - SEE NEXT SHEET

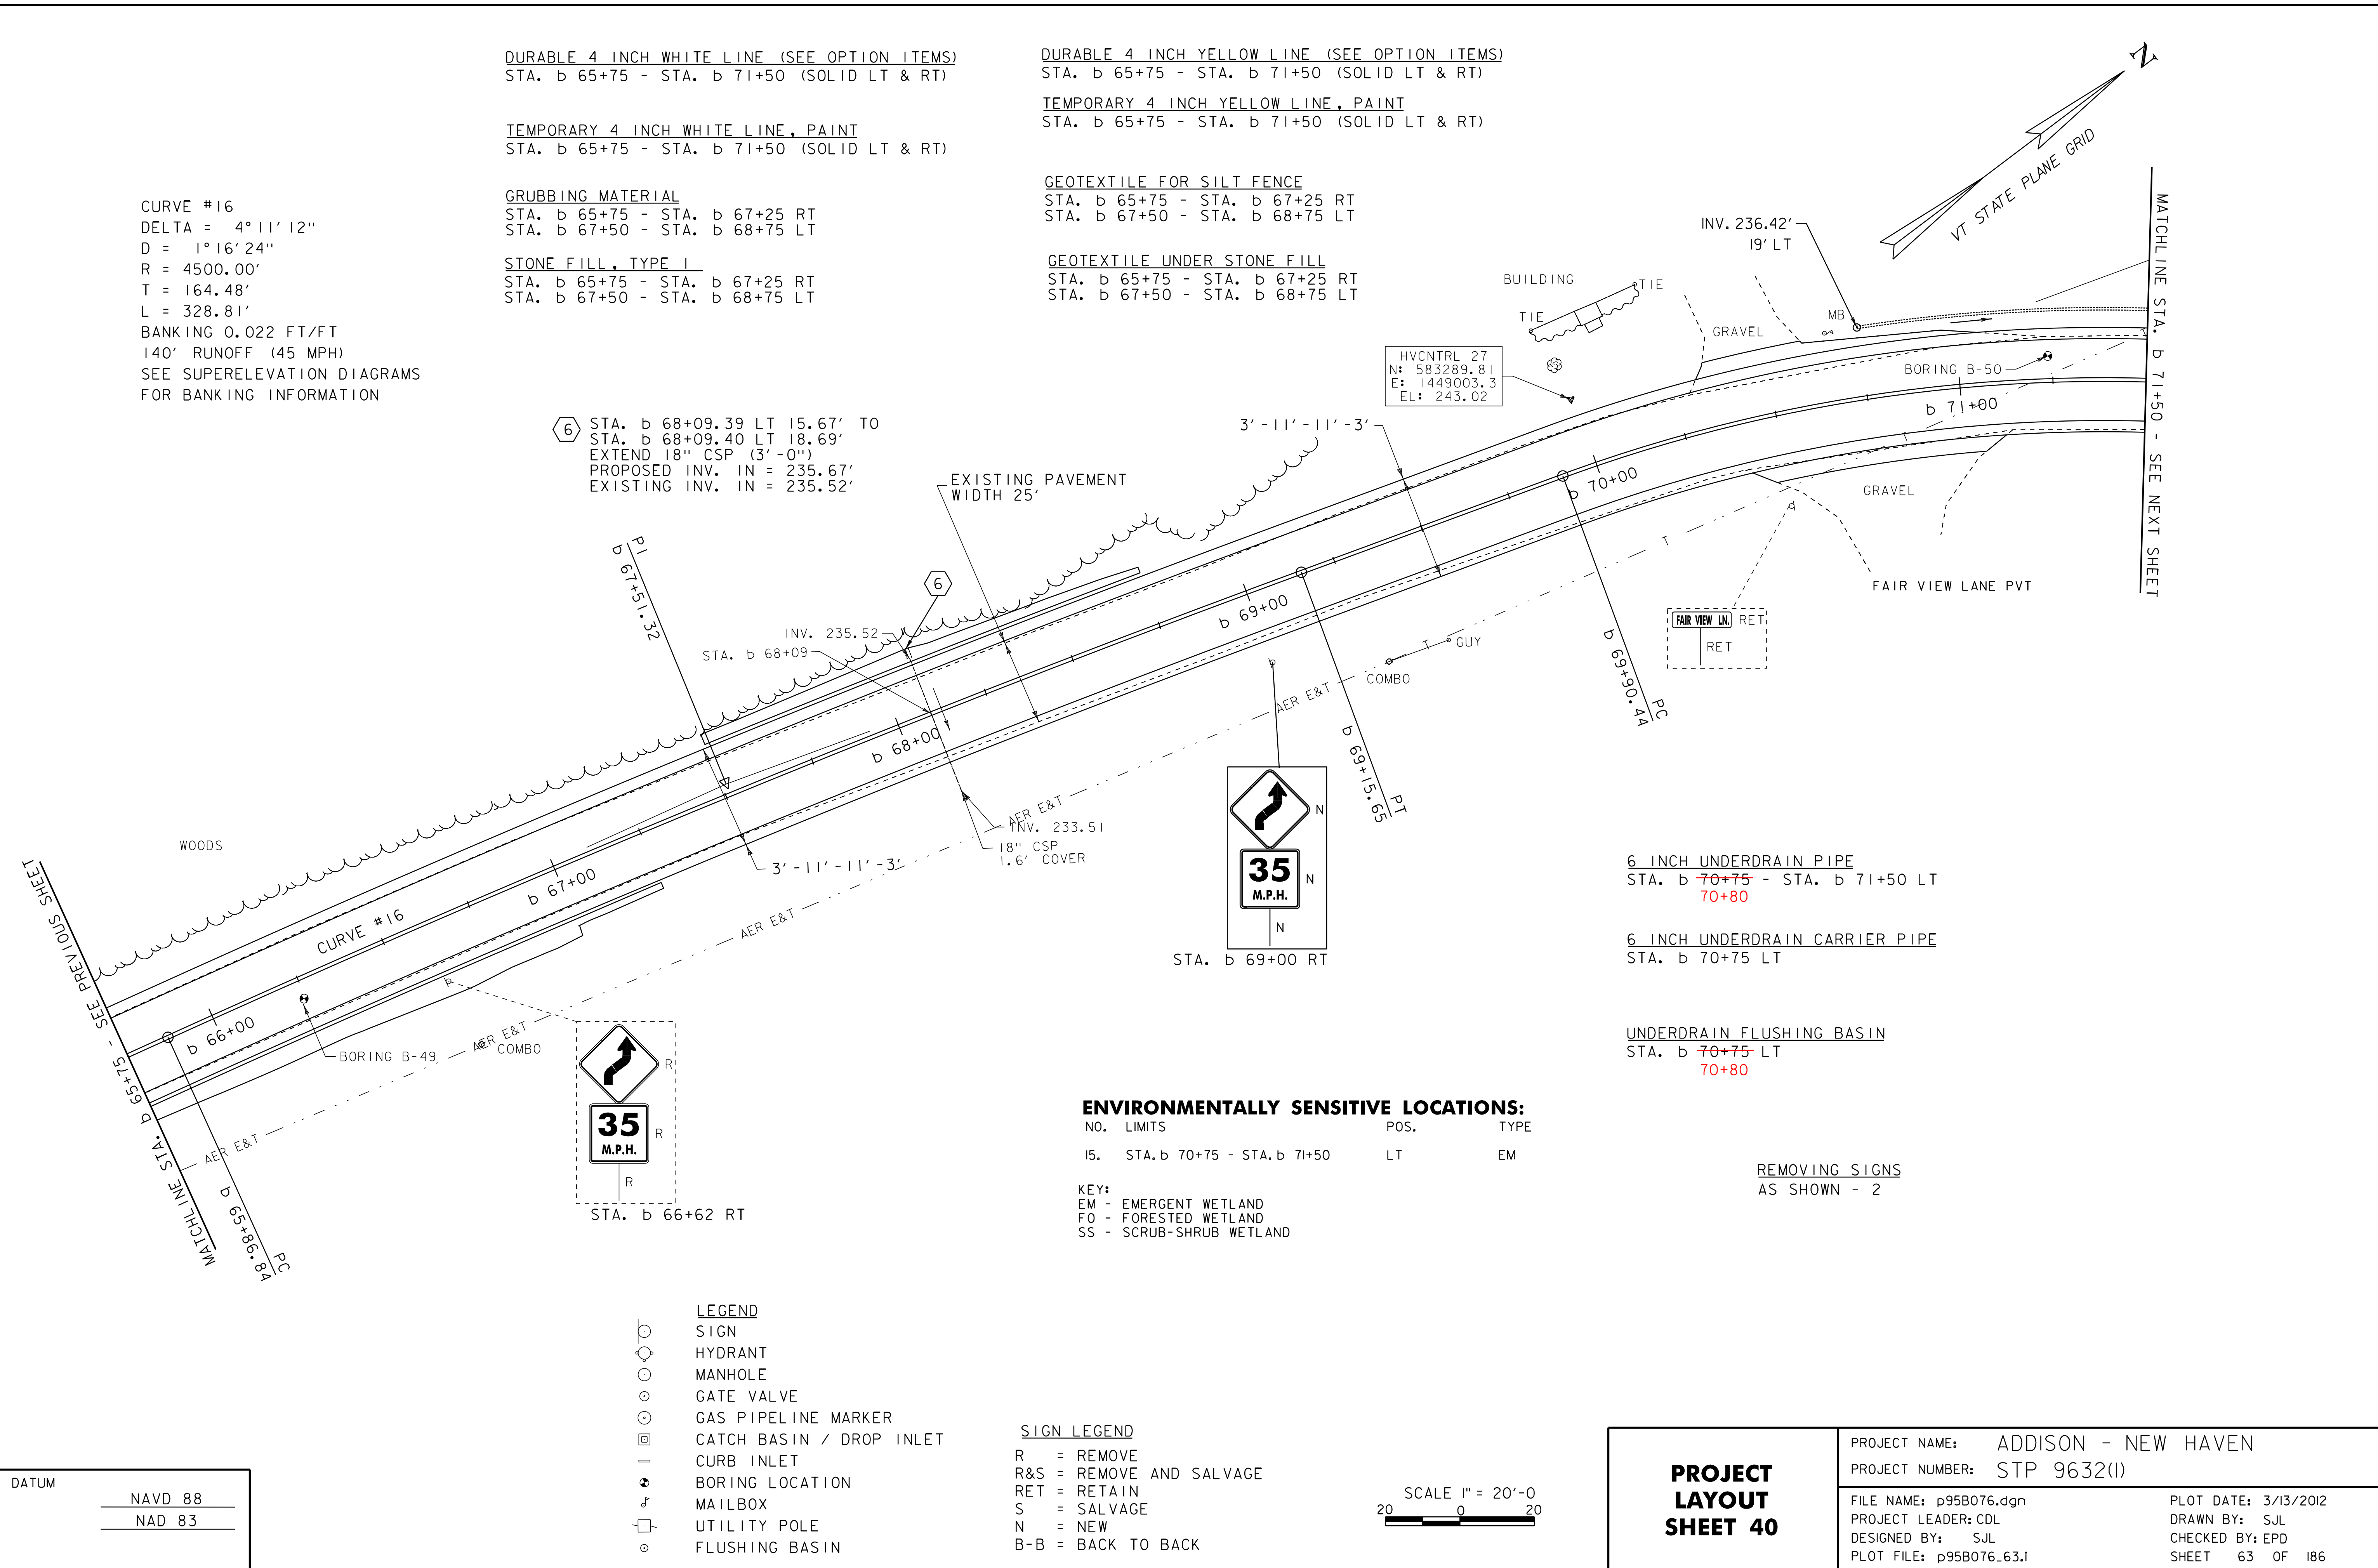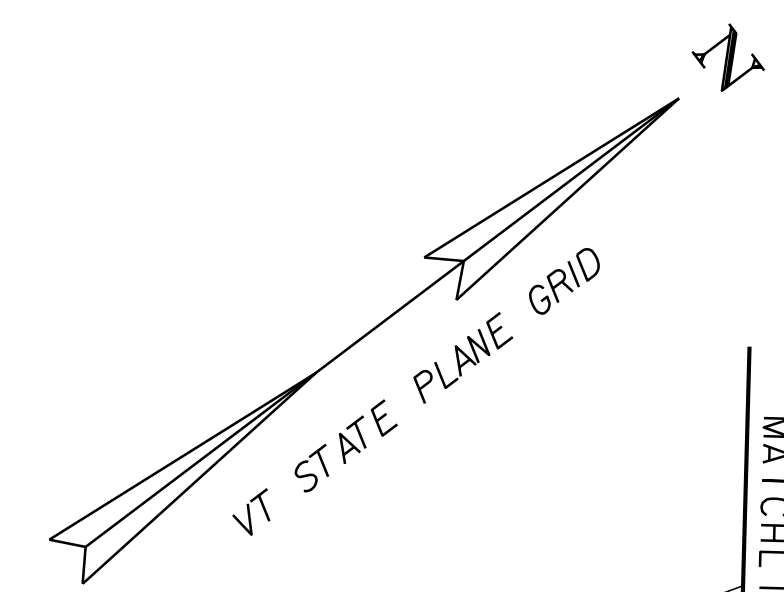

| | |
|-------|---------|
| DATUM | NAVD 88 |
| | NAD 83 |

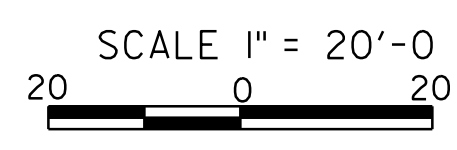

| | | |
|--------------------------------|-----------------------------------|----------------------|
| PROJECT LAYOUT SHEET 40 | PROJECT NAME: ADDISON - NEW HAVEN | PLOT DATE: 3/13/2012 |
| | PROJECT NUMBER: STP 9632(1) | DRAWN BY: SJL |
| | FILE NAME: p95B076.dgn | CHECKED BY: EPD |
| | DESIGNED BY: SJL | SHEET 63 OF 186 |