


MATCHLINE STA. b 71+50 - SEE PREVIOUS SHEET

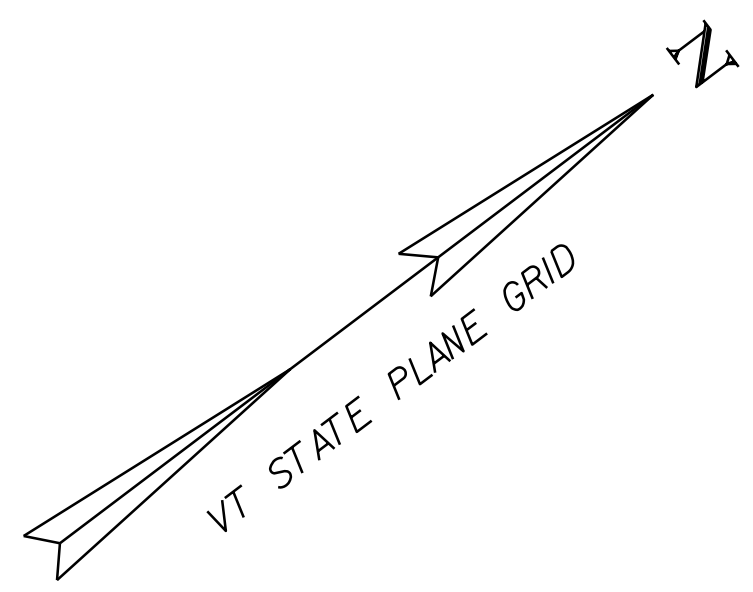

DURABLE 4 INCH WHITE LINE (SEE OPTION ITEMS)
STA. b 71+50 - STA. b 77+75 (SOLID LT & RT)

TEMPORARY 4 INCH WHITE LINE, PAINT
STA. b 71+50 - STA. b 77+75 (SOLID LT & RT)

DURABLE 4 INCH YELLOW LINE (SEE OPTION ITEMS)
STA. b 71+50 - STA. b 77+75 (SOLID LT & RT)

TEMPORARY 4 INCH YELLOW LINE, PAINT
STA. b 71+50 - STA. b 77+75 (SOLID LT & RT)

6 INCH UNDERDRAIN PIPE 77+75
STA. b 71+50 - STA. b 72+25 LT
STA. b 73+00 - STA. b 77+00 LT

6 INCH UNDERDRAIN CARRIER PIPE
STA. b 73+00 LT
STA. b 75+00 LT

UNDERDRAIN FLUSHING BASIN
STA. b 73+00 LT
STA. b 75+00 LT
B 75+20 LT

REMOVING SIGNS
AS SHOWN - 1

STONE FILL, TYPE I
STA. b 72+75 - STA. b 77+75 LT

GRUBBING MATERIAL
STA. b 72+75 - STA. b 77+75 LT

GEOTEXTILE FOR SILT FENCE
STA. b 72+75 - STA. b 77+75 LT

GEOTEXTILE UNDER STONE FILL
STA. b 72+75 - STA. b 77+75 LT

REMOVING AND RESETTING FENCE
STA. b 77+50 - STA. b 77+75 LT

NOTE:
EXISTING BURIED FIBER OPTIC CABLES HAVE BEEN ABANDONED WITHIN PROJECT LIMITS

CURVE #17
DELTA = 46°28'08"
D = 13°38'31"
R = 420.00'
T = 180.31'
L = 340.63'
BANKING 0.076 FT/FT
145' RUNOFF (35 MPH)
SEE SUPERELEVATION DIAGRAMS FOR BANKING INFORMATION


ENVIRONMENTALLY SENSITIVE LOCATIONS:

NO.	LIMITS	POS.	TYPE
15.	STA. b 71+50 - STA. b 77+75	LT	EM

KEY:
EM - EMERGENT WETLAND
FO - FORESTED WETLAND
SS - SCRUB-SHRUB WETLAND

- LEGEND**
- SIGN
 - HYDRANT
 - MANHOLE
 - GATE VALVE
 - GAS PIPELINE MARKER
 - CATCH BASIN / DROP INLET
 - CURB INLET
 - ⊕ BORING LOCATION
 - ⊕ MAILBOX
 - ⊕ UTILITY POLE
 - FLUSHING BASIN

- SIGN LEGEND**
- R = REMOVE
 - R&S = REMOVE AND SALVAGE
 - RET = RETAIN
 - S = SALVAGE
 - N = NEW
 - B-B = BACK TO BACK

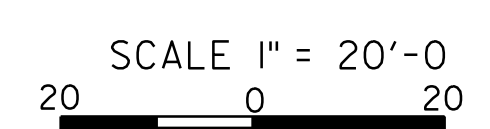

DATUM
NAVD 88
NAD 83

PROJECT LAYOUT SHEET 41

PROJECT NAME:	ADDISON - NEW HAVEN
PROJECT NUMBER:	STP 9632(1)
FILE NAME:	p95B076.dgn
PROJECT LEADER:	CDL
DESIGNED BY:	SJL
PLOT FILE:	p95B076_64.t
PLOT DATE:	3/13/2012
DRAWN BY:	SJL
CHECKED BY:	EPD
SHEET	64 OF 186

