

DURABLE 4 INCH WHITE LINE (SEE OPTION ITEMS)  
 STA. b 77+75 - STA. b 83+50 (SOLID LT & RT)

TEMPORARY 4 INCH WHITE LINE, PAINT  
 STA. b 77+75 - STA. b 83+50 (SOLID LT & RT)

STONE FILL, TYPE I  
 STA. b 77+75 - STA. b 78+25 LT  
 STA. b 80+50 - STA. b 83+50 LT

GRUBBING MATERIAL  
 STA. b 77+75 - STA. b 78+25 LT  
 STA. b 80+50 - STA. b 83+50 LT

GEOTEXTILE FOR SILT FENCE  
 STA. b 77+75 - STA. b 78+25 LT  
 STA. b 80+50 - STA. b 83+50 LT

GEOTEXTILE UNDER STONE FILL  
 STA. b 77+75 - STA. b 78+25 LT  
 STA. b 80+50 - STA. b 83+50 LT

DURABLE 4 INCH YELLOW LINE (SEE OPTION ITEMS)  
 STA. b 77+75 - STA. b 83+50 (SOLID LT & RT)

TEMPORARY 4 INCH YELLOW LINE, PAINT  
 STA. b 77+75 - STA. b 83+50 (SOLID LT & RT)

REMOVING AND RESETTING FENCE  
 STA. b 77+75 - STA. b 78+18 LT  
 STA. b 79+25 - STA. b 81+25 RT  
 STA. b 81+75 - STA. b 83+50 RT



6 INCH UNDERDRAIN PIPE  
 STA. b 77+75 - STA. b 83+50 LT  
 STA. b 82+50 - STA. b 83+50 RT

6 INCH UNDERDRAIN CARRIER PIPE  
 STA. b 78+50 LT STA. b 82+50 RT  
 STA. b 81+50 LT

UNDERDRAIN FLUSHING BASIN  
 STA. b 78+50 LT STA. b 82+50 RT  
 STA. b 81+50 LT  
 B 78+70 LT  
 B 81+60 LT

CURVE #19  
 DELTA = 1°05'35"  
 D = 0°29'54"  
 R = 11500.00'  
 T = 109.69'  
 L = 219.36'  
 NORMAL CROWN

NOTE:  
 EXISTING BURIED FIBER OPTIC CABLES HAVE  
 BEEN ABANDONED WITHIN PROJECT LIMITS

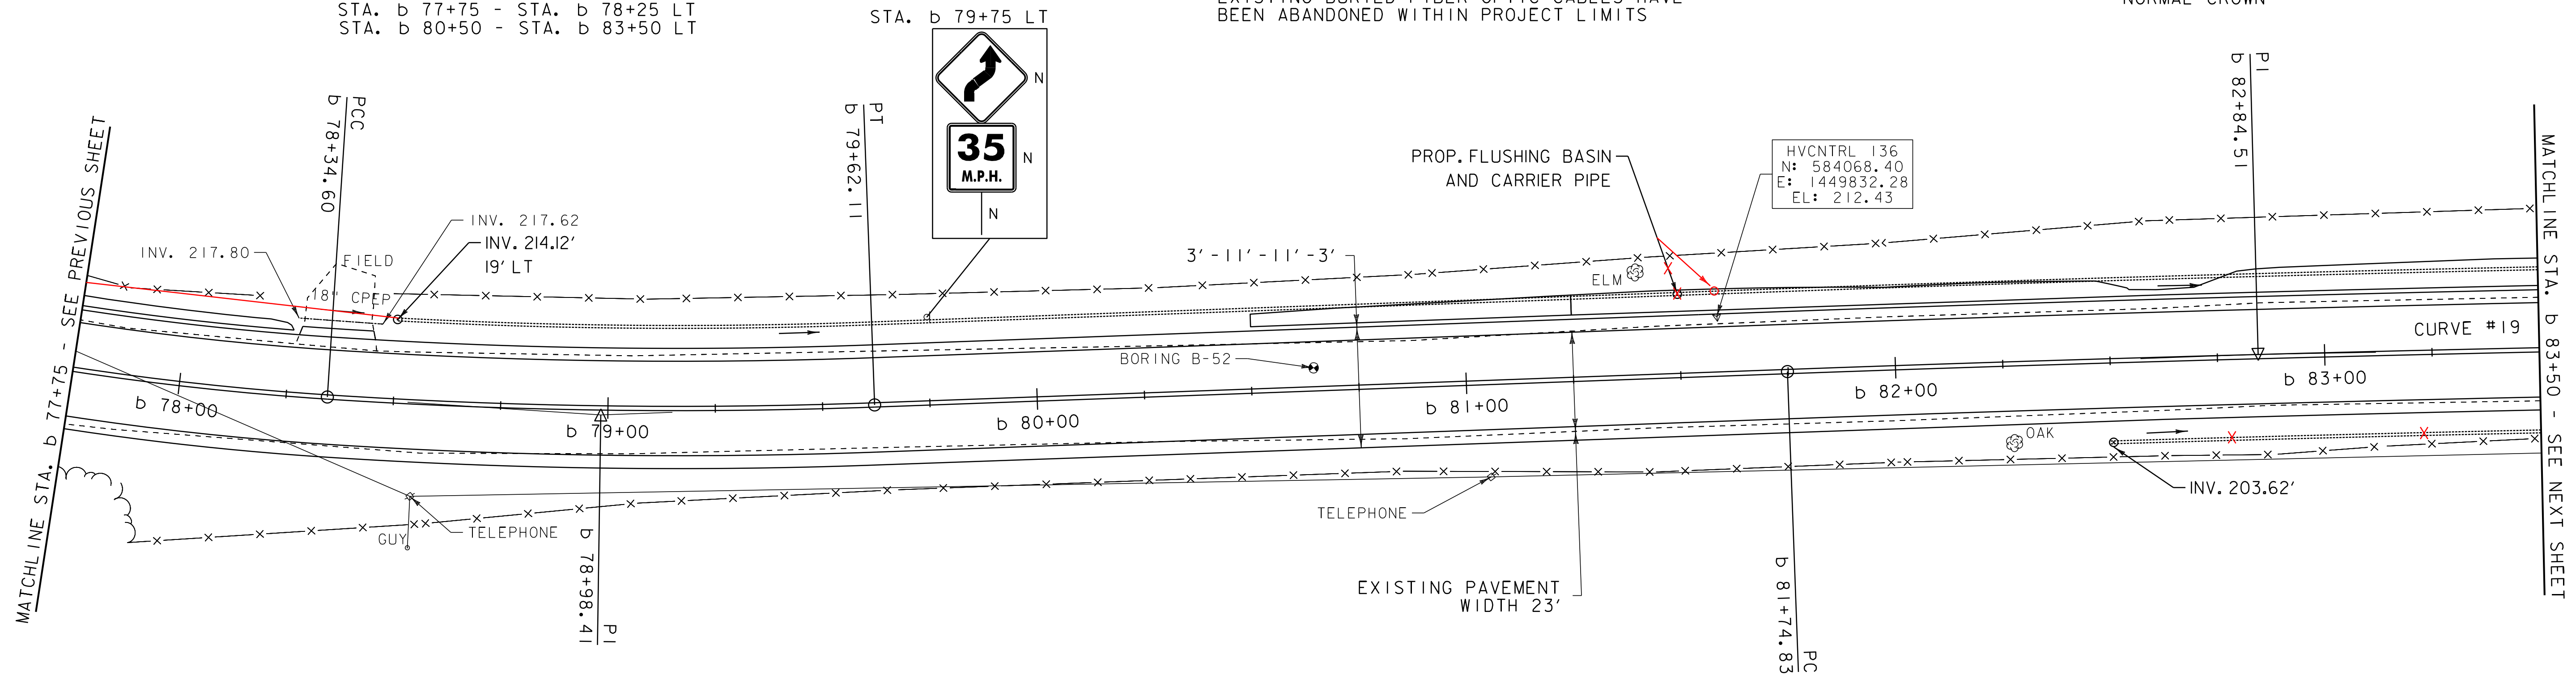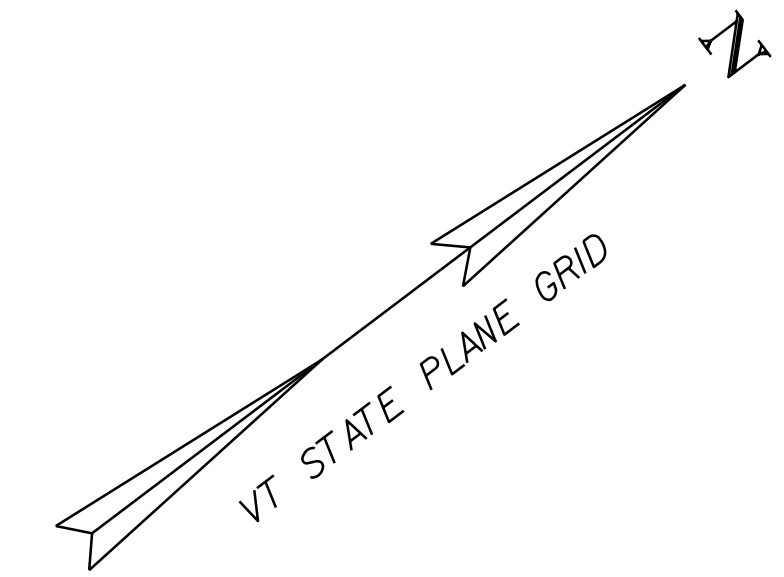

**ENVIRONMENTALLY SENSITIVE LOCATIONS:**

NO.	LIMITS	POS.	TYPE
15.	STA. b 77+75 - STA. b 81+00	LT	EM

KEY:  
 EM - EMERGENT WETLAND  
 FO - FORESTED WETLAND  
 SS - SCRUB-SHRUB WETLAND

**LEGEND**

- SIGN
- ⊙ HYDRANT
- MANHOLE
- GATE VALVE
- GAS PIPELINE MARKER
- ⊠ CATCH BASIN / DROP INLET
- CURB INLET
- ⊙ BORING LOCATION
- ⊙ MAILBOX
- ⊙ UTILITY POLE
- ⊙ FLUSHING BASIN

**SIGN LEGEND**

- R = REMOVE
- R&S = REMOVE AND SALVAGE
- RET = RETAIN
- S = SALVAGE
- N = NEW
- B-B = BACK TO BACK

DATUM  
 NAVD 88  
 NAD 83

SCALE 1" = 20'-0"  
 20 0 20

**PROJECT LAYOUT SHEET 42**

PROJECT NAME: ADDISON - NEW HAVEN  
 PROJECT NUMBER: STP 9632(1)

FILE NAME: p95B076.dgn  
 PROJECT LEADER: CDL  
 DESIGNED BY: SJL  
 PLOT FILE: p95B076.65.t

PLOT DATE: 3/13/2012  
 DRAWN BY: SJL  
 CHECKED BY: EPD  
 SHEET 65 OF 186