

DURABLE 4 INCH WHITE LINE (SEE OPTION ITEMS)
 STA. b 89+25 - STA. b 94+75 (SOLID LT & RT)

TEMPORARY 4 INCH WHITE LINE, PAINT
 STA. b 89+25 - STA. b 94+75 (SOLID LT & RT)

STONE FILL, TYPE I
 STA. b 91+75 - STA. b 92+25 RT
 STA. b 93+75 - STA. b 94+75 LT
 STA. b 93+75 - STA. b 94+25 RT

GRUBBING MATERIAL
 STA. b 91+75 - STA. b 92+25 RT
 STA. b 93+75 - STA. b 94+75 LT
 STA. b 93+75 - STA. b 94+25 RT

GEOTEXTILE FOR SILT FENCE
 STA. b 91+75 - STA. b 92+25 RT
 STA. b 93+75 - STA. b 94+75 LT
 STA. b 93+75 - STA. b 94+25 RT

GEOTEXTILE UNDER STONE FILL
 STA. b 91+75 - STA. b 92+25 RT
 STA. b 93+75 - STA. b 94+75 LT
 STA. b 93+75 - STA. b 94+25 RT

STEEL BEAM GUARDRAIL, GALVANIZED W/8 FEET POSTS
~~STA. b 94+19.75 - STA. b 94+75 RT~~
 B 92+37
 ANCHOR FOR STEEL BEAM RAIL
~~STA. b 94+19.75 RT~~
 B 92+37 RT

DURABLE 4 INCH YELLOW LINE (SEE OPTION ITEMS)
 STA. b 89+25 - STA. b 94+75 (SOLID LT & RT)

TEMPORARY 4 INCH YELLOW LINE, PAINT
 STA. b 89+25 - STA. b 94+75 (SOLID LT & RT)

6 INCH UNDERDRAIN PIPE
 STA. b ~~90+00~~ - STA. b ~~94+50~~ LT
 91+00 94+75



6 INCH UNDERDRAIN CARRIER PIPE
 STA. b 90+00 LT
 STA. b 92+25 LT

UNDERDRAIN FLUSHING BASIN
~~STA. b 90+00 LT B 91+00 LT~~
 STA. b 92+25 LT

REMOVING AND RESETTING FENCE
 STA. b 89+94 - STA. b 91+04 LT
 STA. b 91+25 - STA. b 92+00 RT
 STA. b 94+47 - STA. b 94+75 LT

NOTE:
 EXISTING BURIED FIBER OPTIC CABLES HAVE
 BEEN ABANDONED WITHIN PROJECT LIMITS

CURVE #21
 DELTA = 7°59'49"
 D = 2°51'53"
 R = 2000.00'
 T = 139.80'
 L = 279.15'
 BANKING 0.043 FT/FT
 140' RUNOFF (45 MPH)
 SEE SUPERELEVATION DIAGRAMS
 FOR BANKING INFORMATION

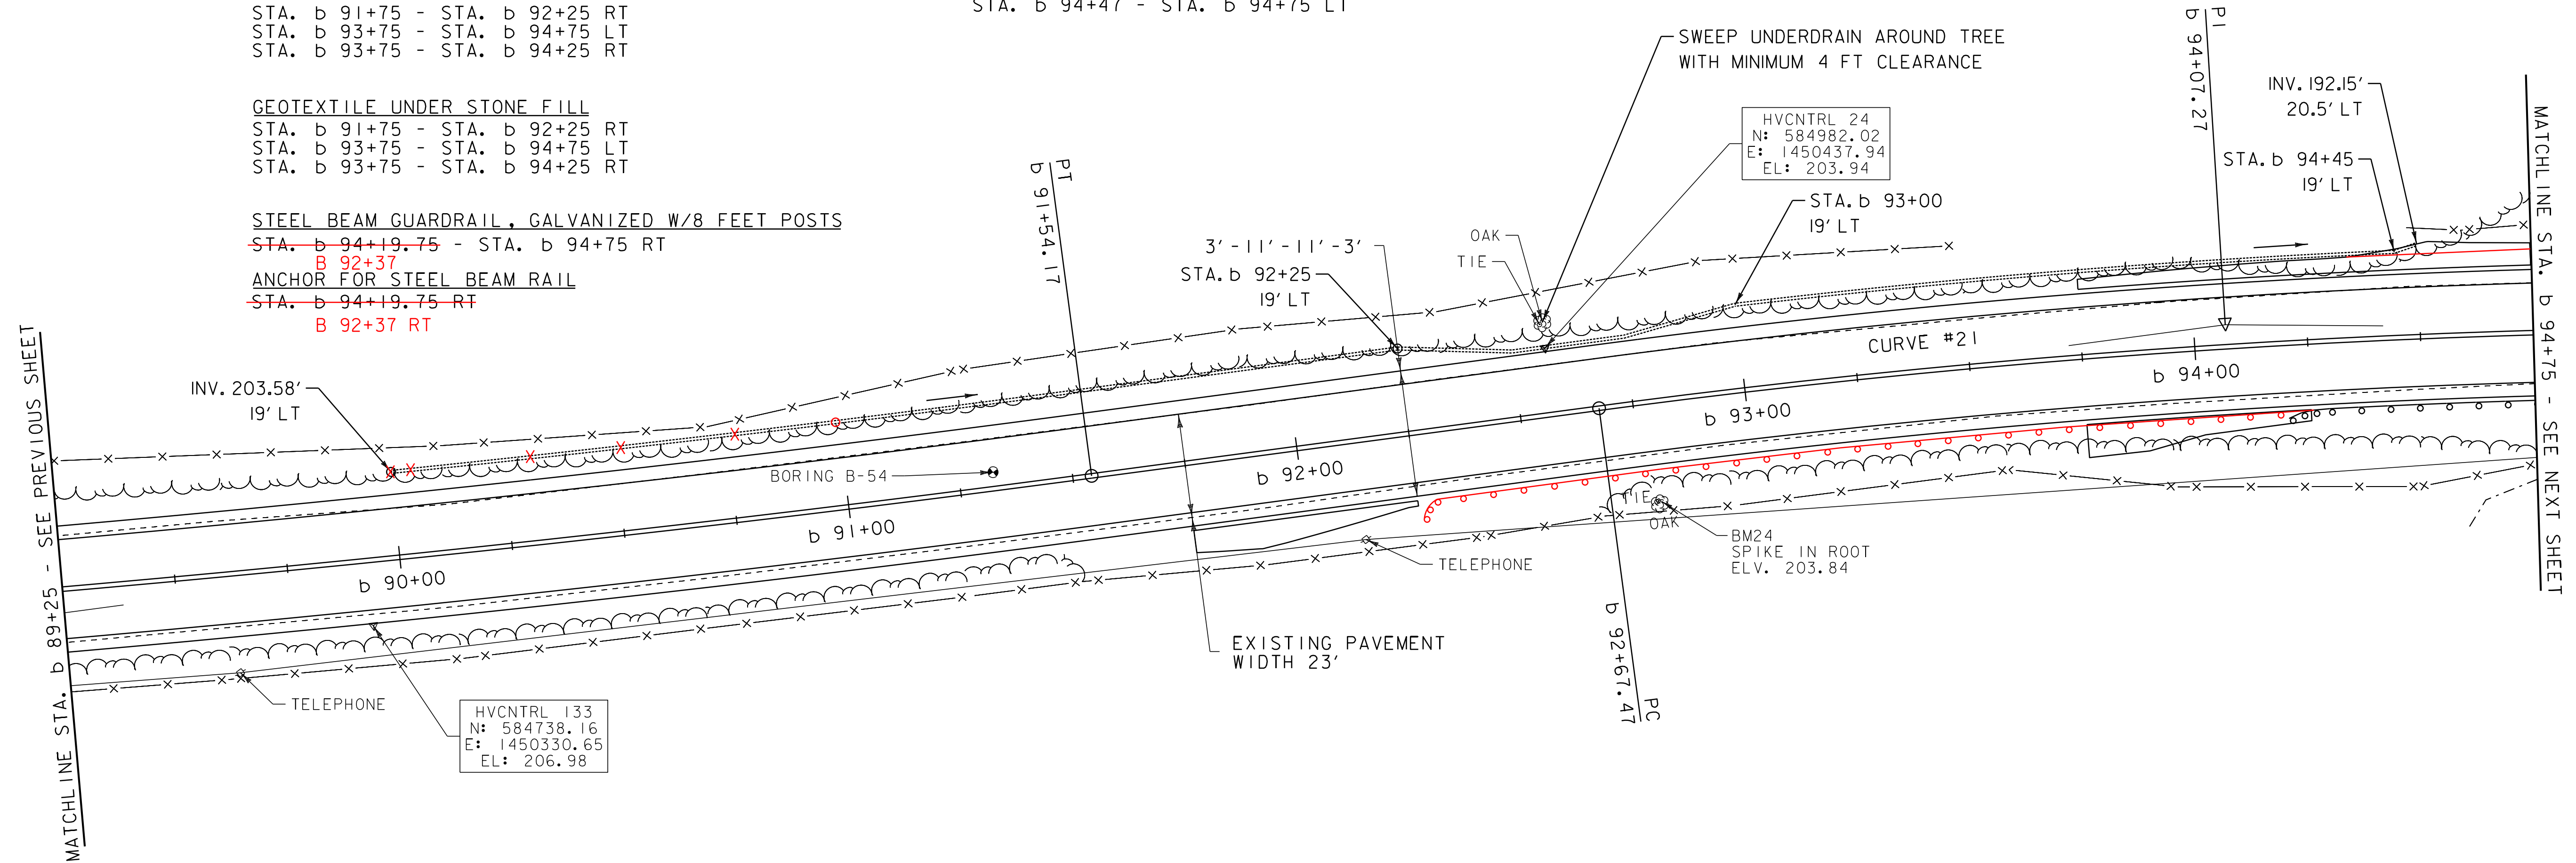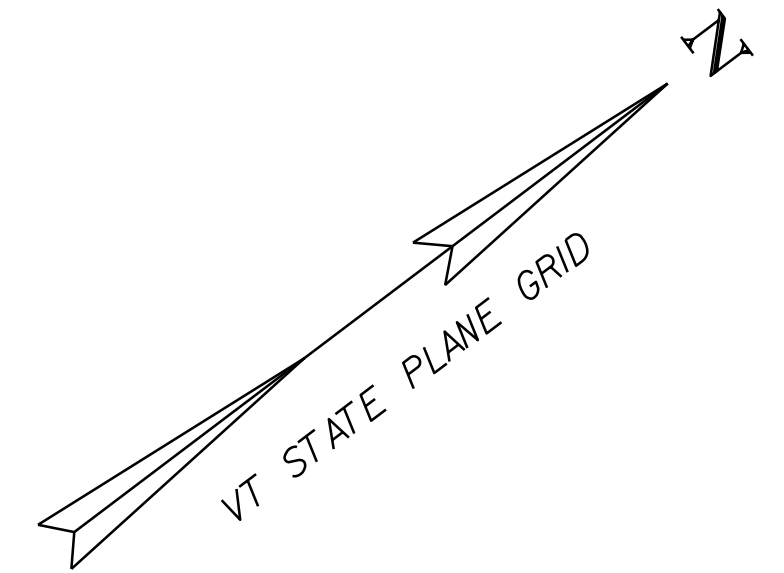

- LEGEND**
- SIGN
 - ⊙ HYDRANT
 - MANHOLE
 - ⊙ GATE VALVE
 - ⊙ GAS PIPELINE MARKER
 - ⊙ CATCH BASIN / DROP INLET
 - CURB INLET
 - ⊙ BORING LOCATION
 - ⊙ MAILBOX
 - ⊙ UTILITY POLE
 - ⊙ FLUSHING BASIN

- SIGN LEGEND**
- R = REMOVE
 - R&S = REMOVE AND SALVAGE
 - RET = RETAIN
 - S = SALVAGE
 - N = NEW
 - B-B = BACK TO BACK

DATUM
 NAVD 88
 NAD 83

SCALE 1" = 20'-0"
 20 0 20

PROJECT LAYOUT SHEET 44

PROJECT NAME: ADDISON - NEW HAVEN
 PROJECT NUMBER: STP 9632(1)

FILE NAME: p95B076.dgn
 PROJECT LEADER: CDL
 DESIGNED BY: SJL
 PLOT FILE: p95B076_67.i

PLOT DATE: 3/13/2012
 DRAWN BY: SJL
 CHECKED BY: EPD
 SHEET 67 OF 186