

DURABLE 4 INCH WHITE LINE (SEE OPTION ITEMS)
 STA. b 100+50 - STA. b 106+50 (SOLID LT & RT)

TEMPORARY 4 INCH WHITE LINE, PAINT
 STA. b 100+50 - STA. b 106+50 (SOLID LT & RT)


DURABLE 4 INCH YELLOW LINE (SEE OPTION ITEMS)
 STA. b 100+50 - STA. b 106+50 (SOLID LT & RT)

TEMPORARY 4 INCH YELLOW LINE, PAINT
 STA. b 100+50 - STA. b 106+50 (SOLID LT & RT)

6 INCH UNDERDRAIN PIPE
 STA. b 100+50 - STA. b ~~104+25~~ RT 104+20
 STA. b 104+50 - STA. b 106+50 RT


6 INCH UNDERDRAIN CARRIER PIPE
 STA. b 102+25 RT
 STA. b 104+25 RT

UNDERDRAIN FLUSHING BASIN
 STA. b ~~102+25~~ RT
 STA. b ~~104+25~~ RT
 B 104+20 RT

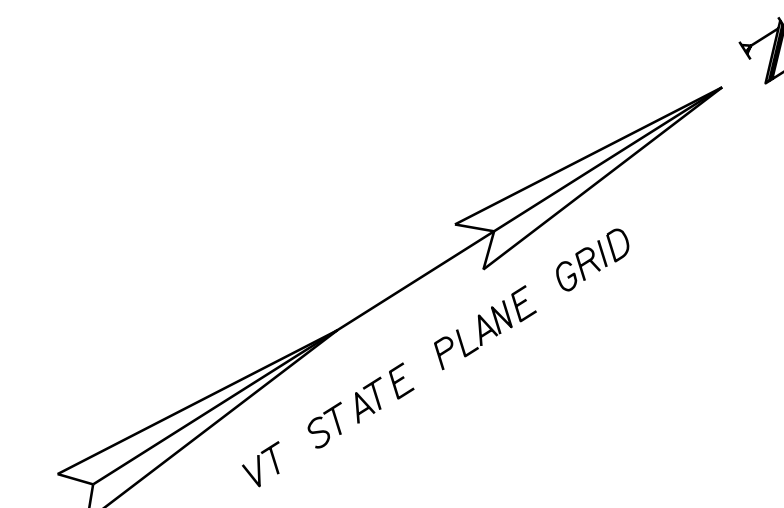

NOTE:
 EXISTING BURIED FIBER OPTIC CABLES HAVE
 BEEN ABANDONED WITHIN PROJECT LIMITS

CURVE #23
 DELTA = 0°23'40"
 D = 0°29'54"
 R = 11500.00'
 T = 39.58'
 L = 79.15'
 NORMAL CROWN

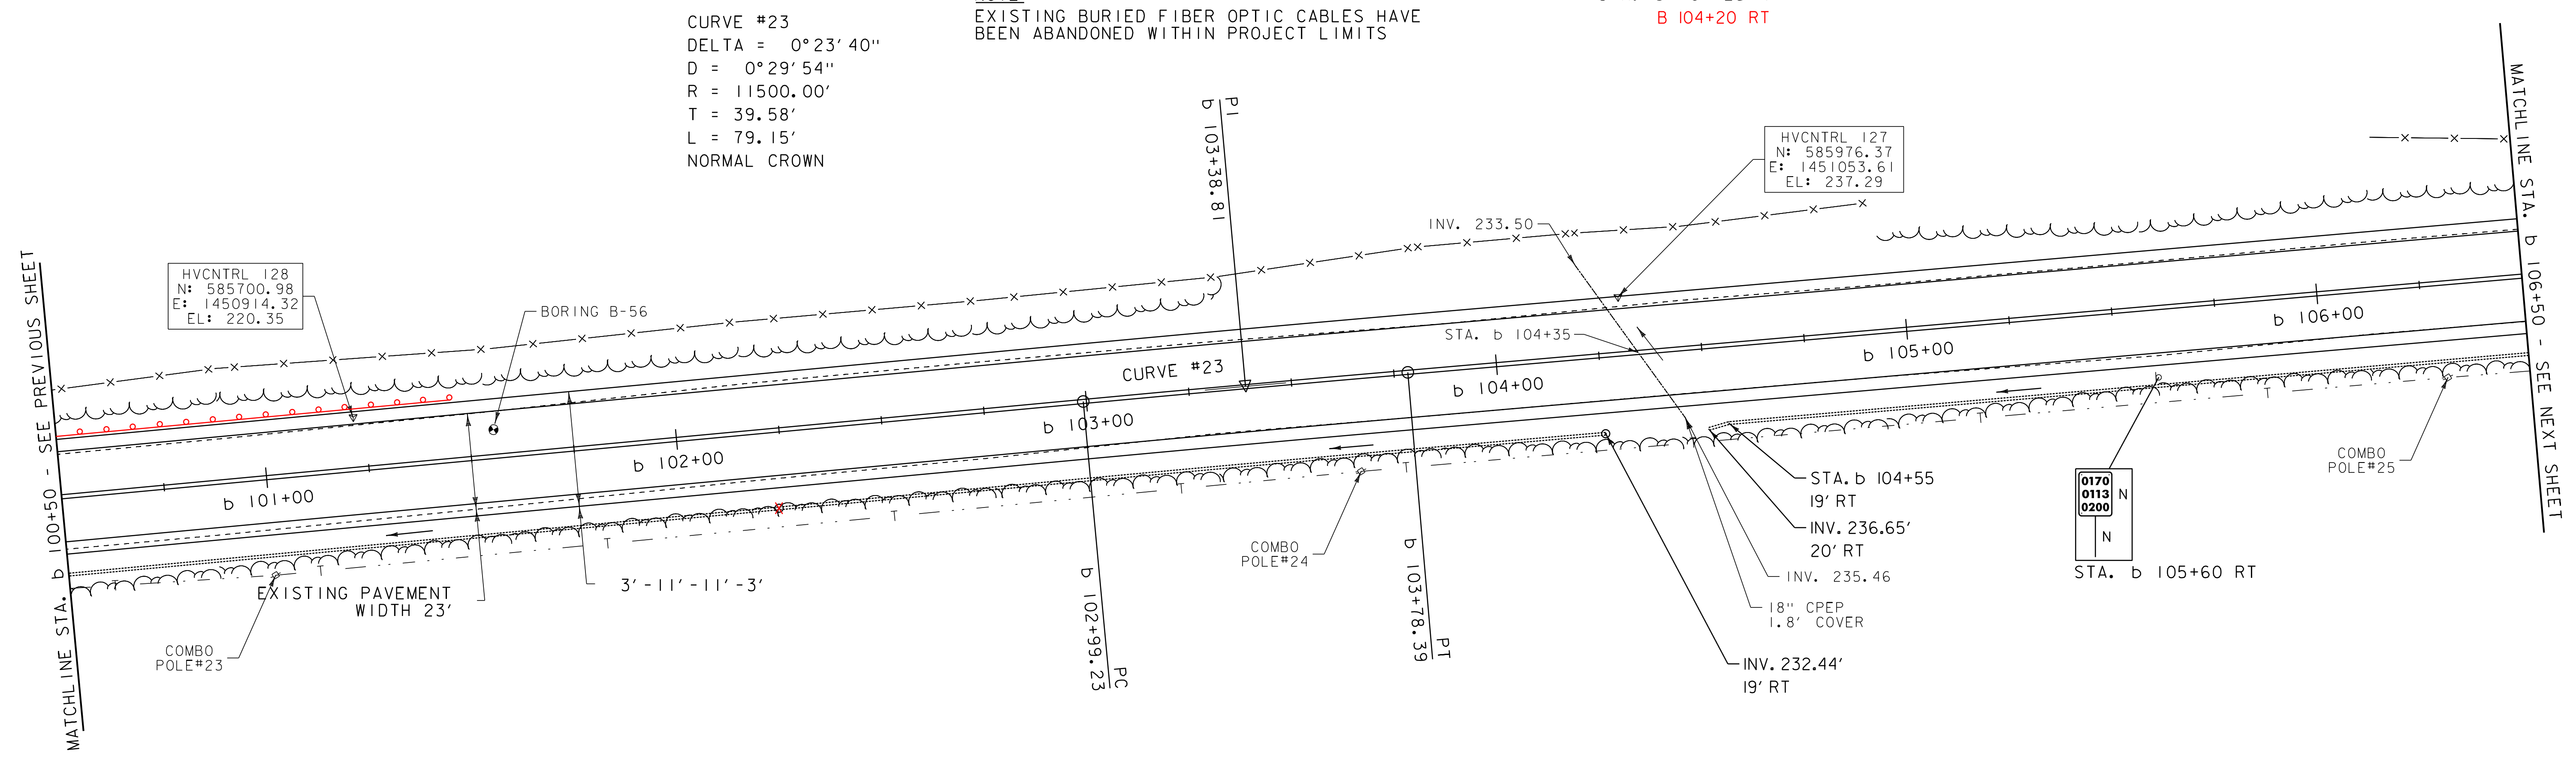

ENVIRONMENTALLY SENSITIVE LOCATIONS:

NO.	LIMITS	POS.	TYPE
20.	STA. b 101+50 - STA. b 104+50	LT	EM

KEY:
 EM - EMERGENT WETLAND
 FO - FORESTED WETLAND
 SS - SCRUB-SHRUB WETLAND

STEEL BEAM GUARDRAIL
 B 100+50 - B 101+46 LT

ANCHOR FOR STEEL BEAM
 B 101+46 LT

- LEGEND**
- SIGN
 - HYDRANT
 - MANHOLE
 - GATE VALVE
 - GAS PIPELINE MARKER
 - CATCH BASIN / DROP INLET
 - CURB INLET
 - ⊕ BORING LOCATION
 - ⊕ MAILBOX
 - UTILITY POLE
 - FLUSHING BASIN

- SIGN LEGEND**
- R = REMOVE
 - R&S = REMOVE AND SALVAGE
 - RET = RETAIN
 - S = SALVAGE
 - N = NEW
 - B-B = BACK TO BACK

DATUM
 NAVD 88
 NAD 83

SCALE 1" = 20'-0"
 20 0 20

PROJECT LAYOUT SHEET 46

PROJECT NAME: ADDISON - NEW HAVEN
 PROJECT NUMBER: STP 9632(1)

FILE NAME: p95B076.dgn
 PROJECT LEADER: CDL
 DESIGNED BY: SJL
 PLOT FILE: p95B076_69.i

PLOT DATE: 3/13/2012
 DRAWN BY: SJL
 CHECKED BY: EPD
 SHEET 69 OF 186