

STONE FILL, TYPE I
STA. b 111+75 - STA. b 112+25 LT

GRUBBING MATERIAL
STA. b 111+75 - STA. b 112+25 LT

GEOTEXTILE FOR SILT FENCE
STA. b 111+75 - STA. b 112+25 LT


GEOTEXTILE UNDER STONE FILL
STA. b 111+75 - STA. b 112+25 LT

DURABLE 4 INCH WHITE LINE (SEE OPTION ITEMS)
STA. b 106+50 - STA. b 112+25 (SOLID LT & RT)

TEMPORARY 4 INCH WHITE LINE, PAINT
STA. b 106+50 - STA. b 112+25 (SOLID LT & RT)


DURABLE 4 INCH YELLOW LINE (SEE OPTION ITEMS)
STA. b 106+50 - STA. b 112+25 (SOLID LT & RT)

TEMPORARY 4 INCH YELLOW LINE, PAINT
STA. b 106+50 - STA. b 112+25 (SOLID LT & RT)

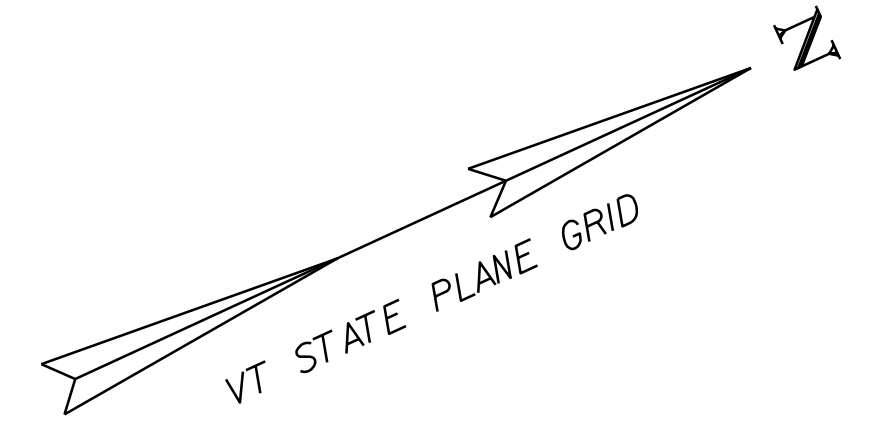

CURVE #24
DELTA = 3°37'42"
D = 1°18'08"
R = 4400.00'
T = 139.36'
L = 278.63'
BANKING 0.022 FT/FT
140' RUNOFF (45 MPH)
SEE SUPERELEVATION DIAGRAMS
FOR BANKING INFORMATION

NOTE:
EXISTING BURIED FIBER OPTIC CABLES HAVE
BEEN ABANDONED WITHIN PROJECT LIMITS

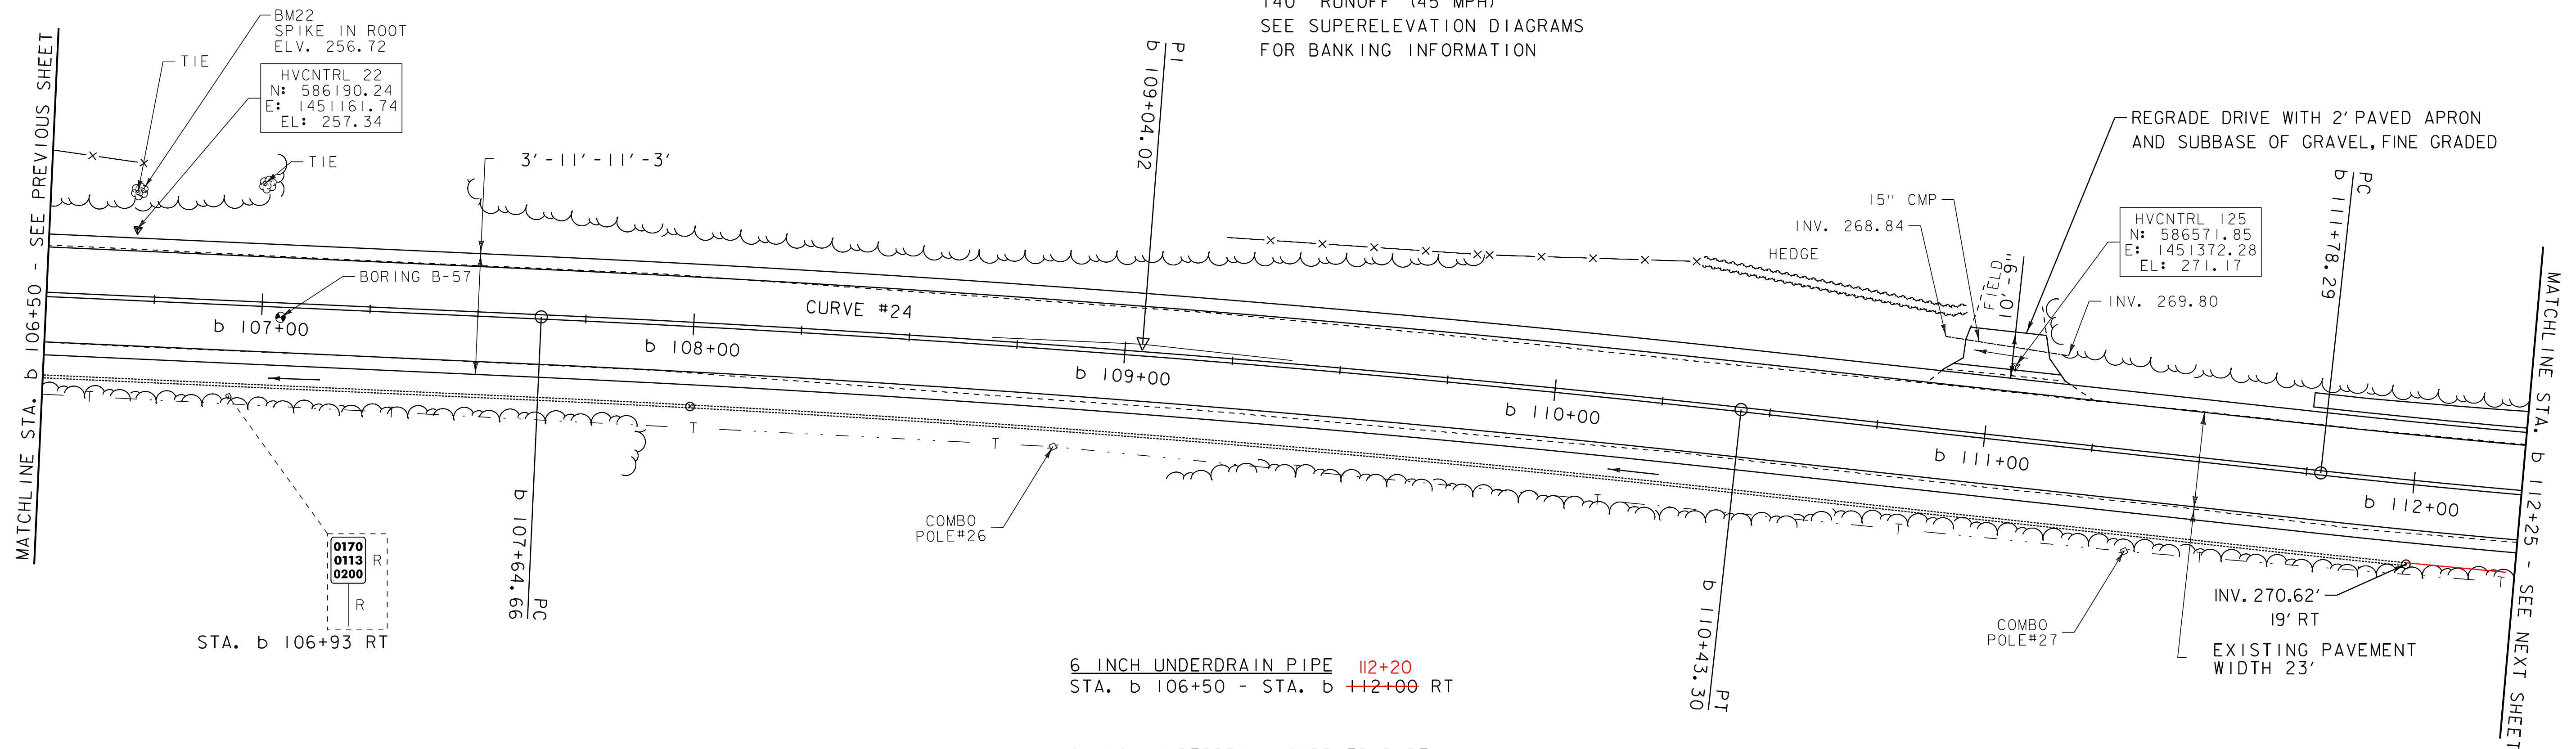

DATUM
NAVD 88
NAD 83

- LEGEND**
- SIGN
 - HYDRANT
 - MANHOLE
 - GATE VALVE
 - GAS PIPELINE MARKER
 - CATCH BASIN / DROP INLET
 - = CURB INLET
 - BORING LOCATION
 - ✂ MAILBOX
 - UTILITY POLE
 - FLUSHING BASIN

- SIGN LEGEND**
- R = REMOVE
 - R&S = REMOVE AND SALVAGE
 - RET = RETAIN
 - S = SALVAGE
 - N = NEW
 - B-B = BACK TO BACK

SCALE 1" = 20'-0"
20 0 20

REMOVING SIGNS
AS SHOWN - 1

PROJECT LAYOUT SHEET 47	PROJECT NAME: ADDISON - NEW HAVEN	PLOT DATE: 3/13/2012
	PROJECT NUMBER: STP 9632(1)	DRAWN BY: SJL
	FILE NAME: p95B076.dgn	CHECKED BY: EPD
	PROJECT LEADER: CDL	SHEET 70 OF 186
	DESIGNED BY: SJL	
	PLOT FILE: p95B076_70.i	